



STATE	PROJECT NO.	YEAR	SHEET NO.	TOTAL SHEETS
KANSAS	54-87 K-6657-01	2002	823A	1122


DATE	
BY	
REFERENCES NOTED	
REFERENCES CHECKED	

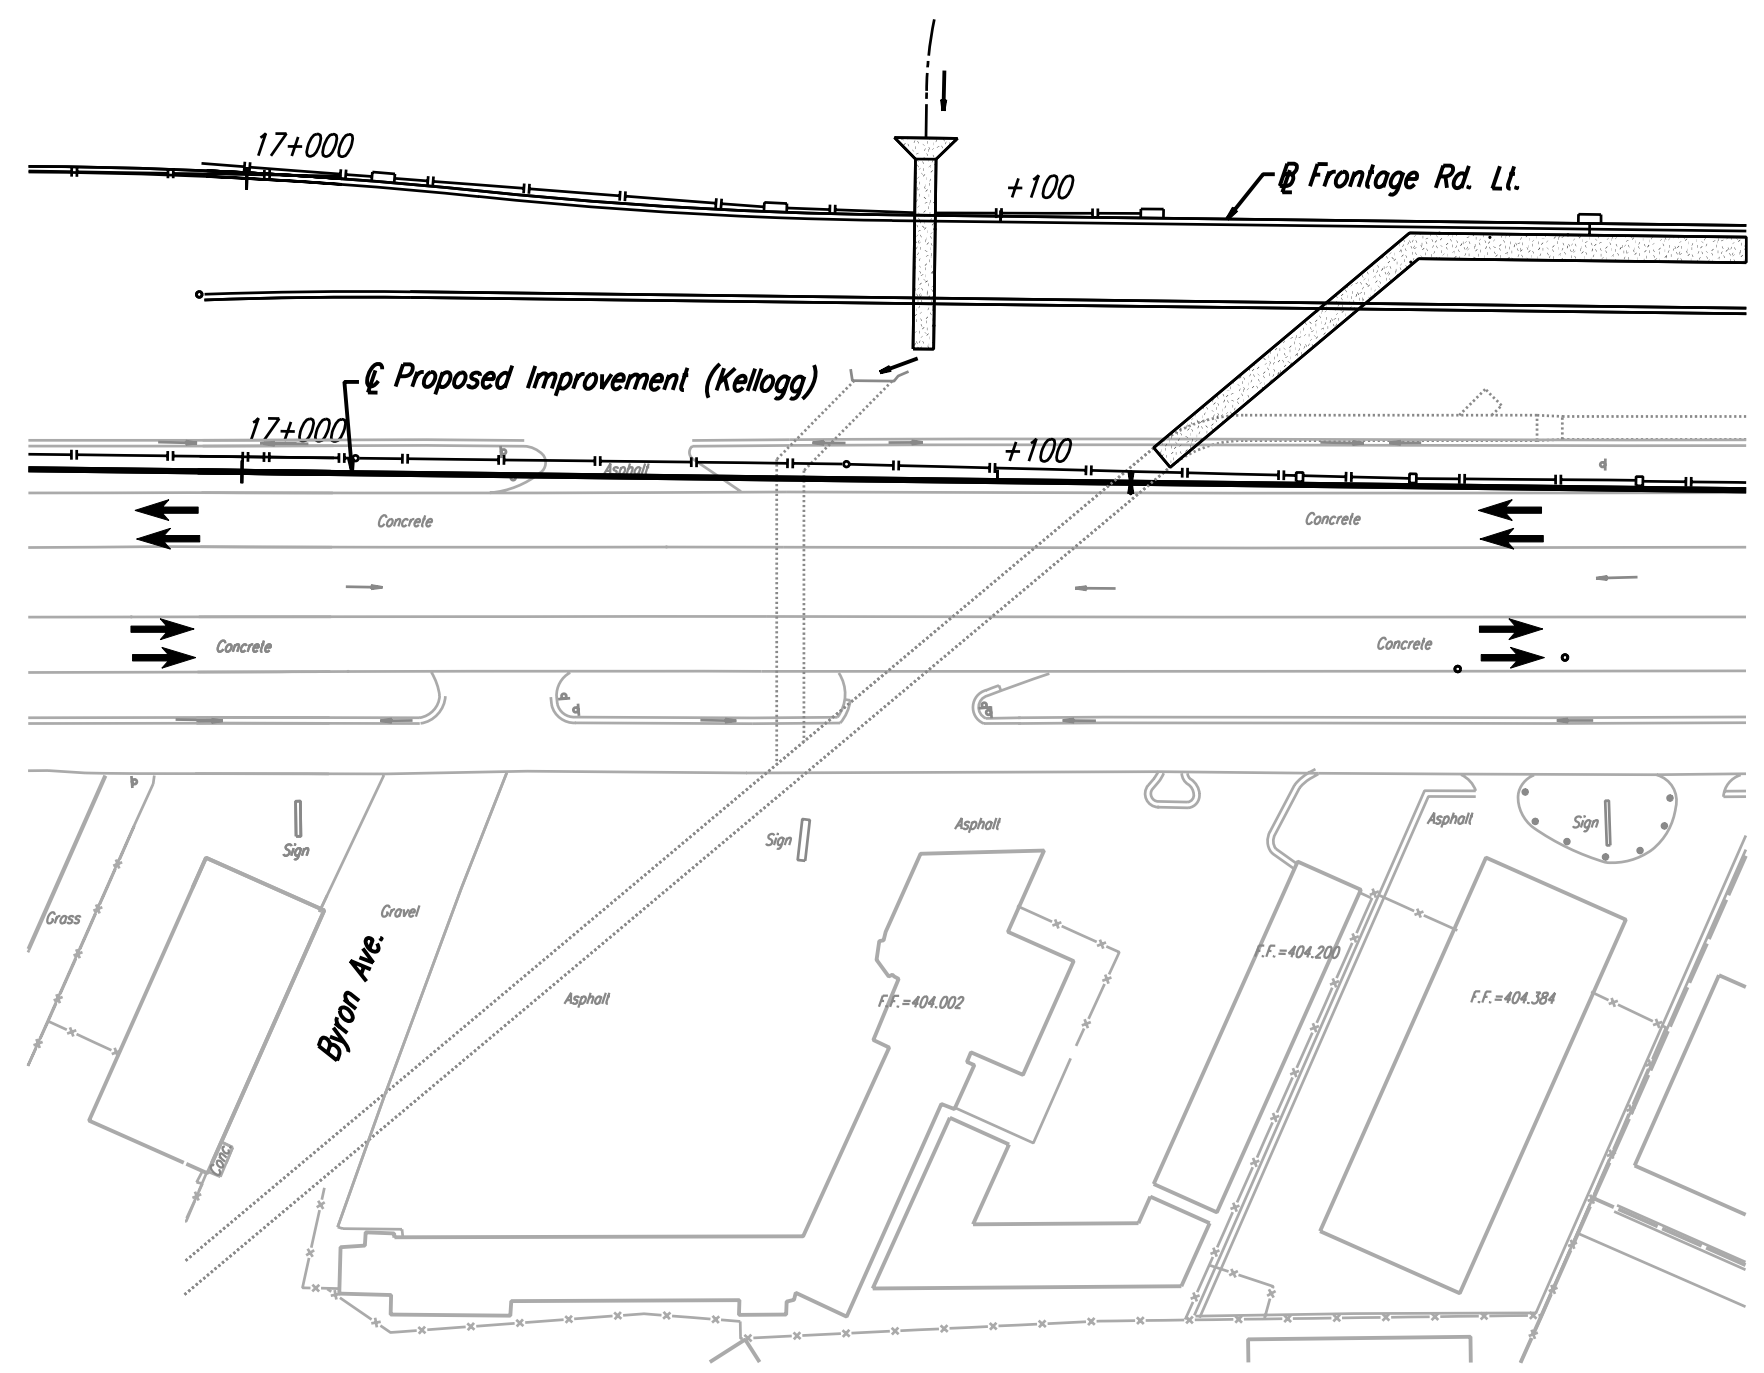


Sta. 17+090
STAGE 1A
①

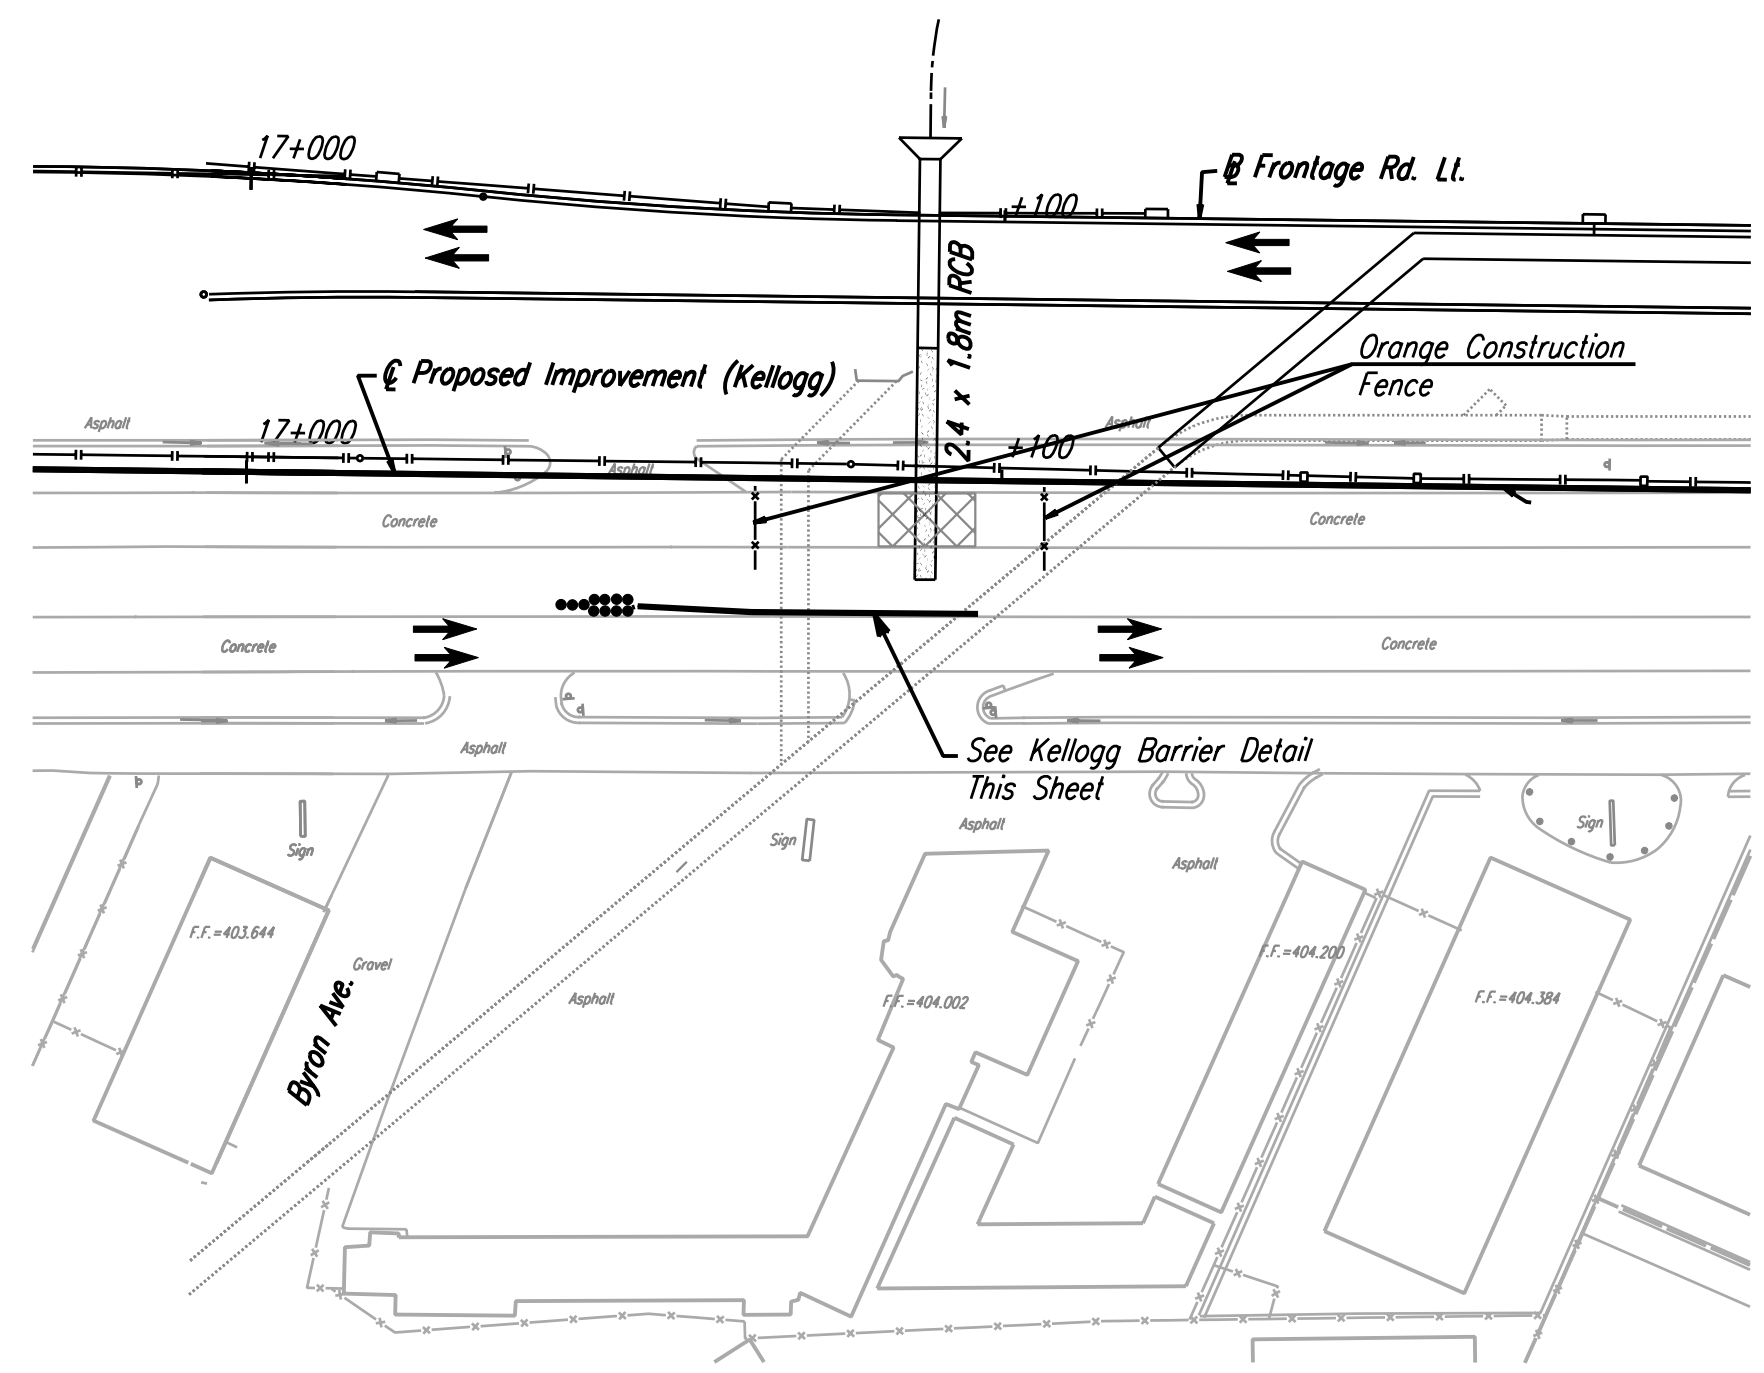

Sta. 17+090
PRIOR TO STAGE 2A
②

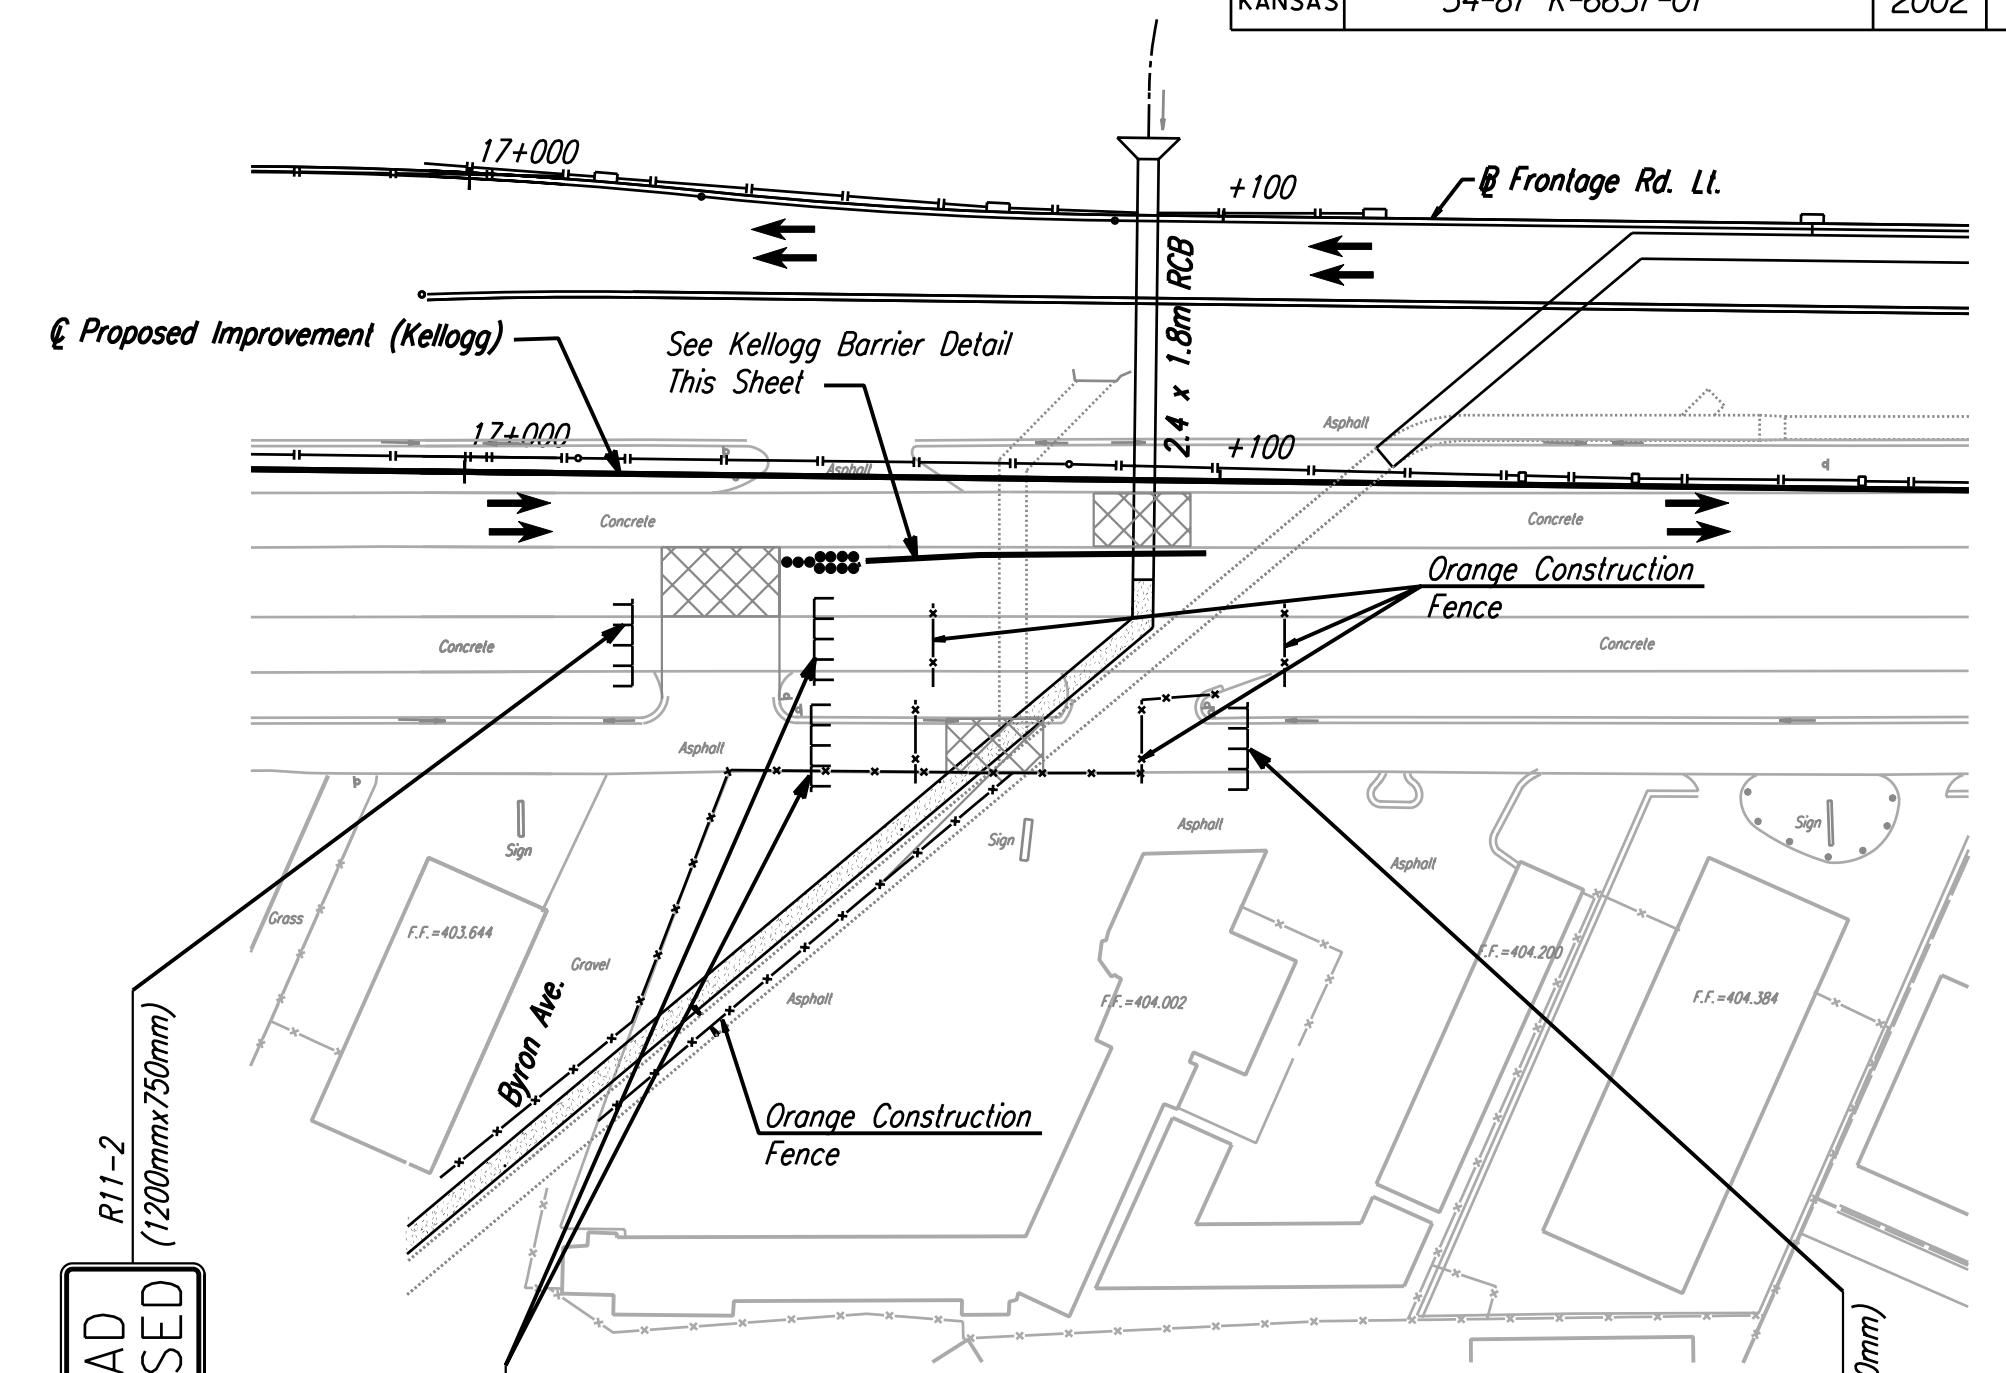


Sta. 17+090
STAGE 2A
③

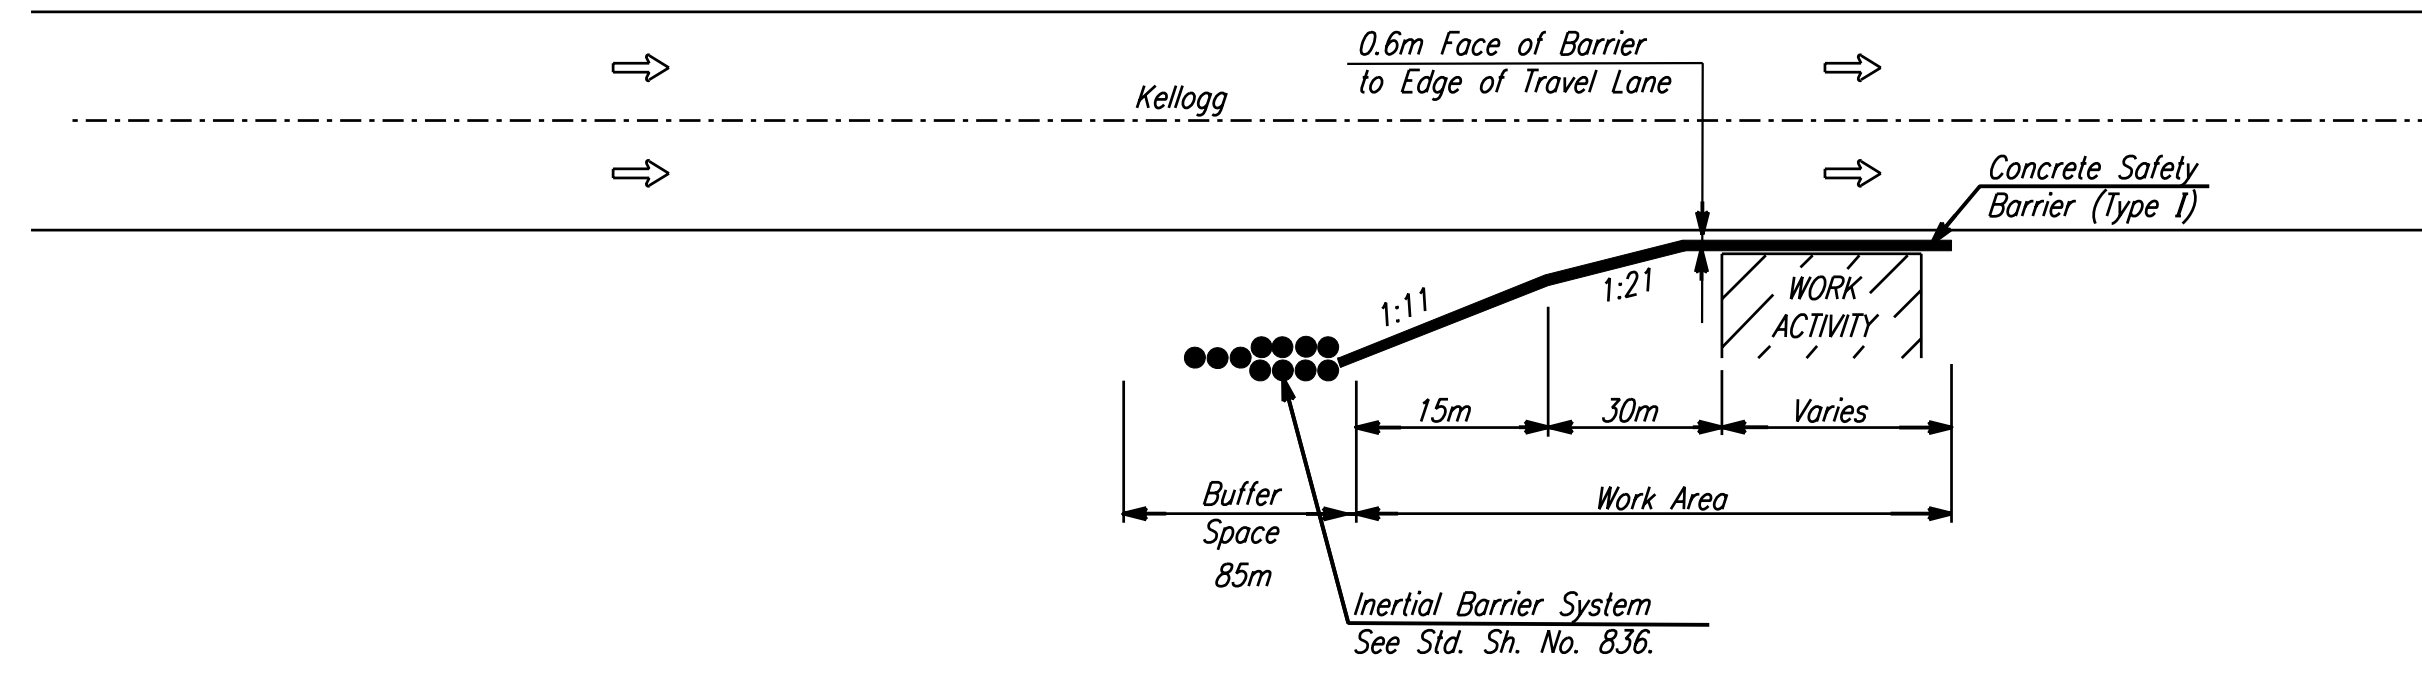

KELLOGG BARRIER DETAIL
TYPICAL TRAFFIC CONTROL DURING
CONSTRUCTION OF RCB'S ACROSS KELLOGG

See Std. Sh. No. 833 for additional Traffic Control Devices.

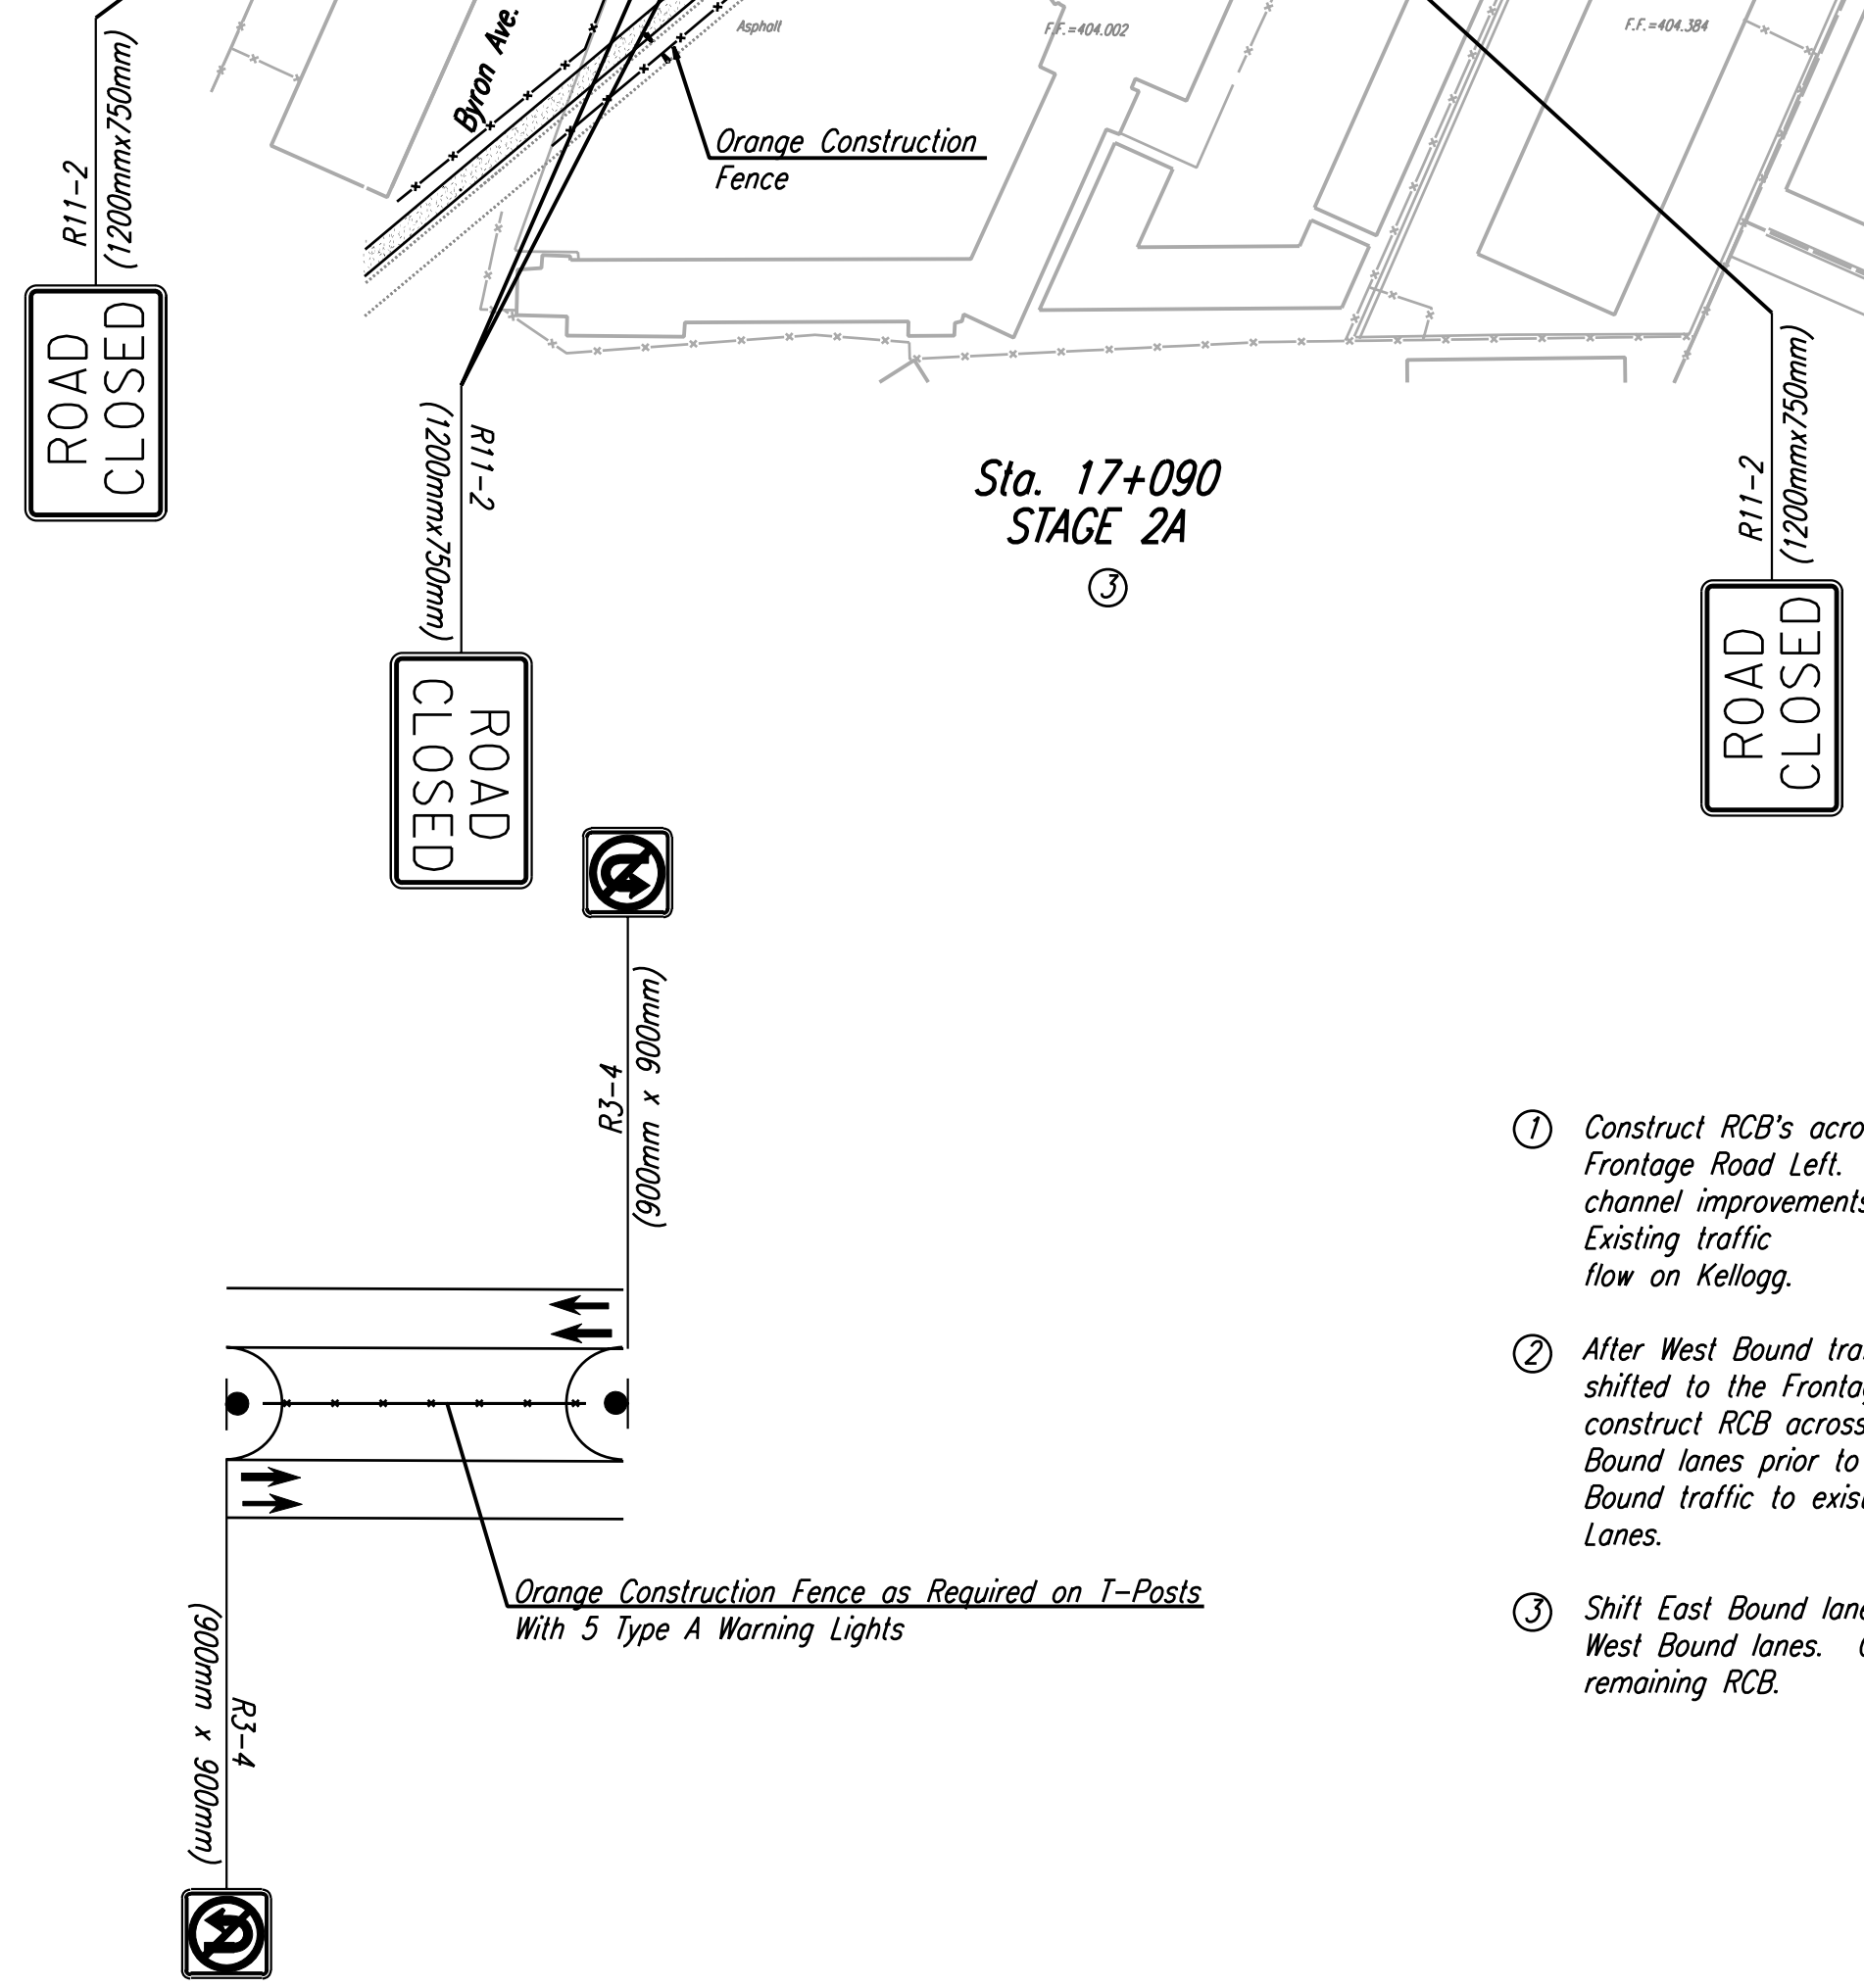

LEGEND

- Orange Construction Fence
- Temporary Pavement
- Work Area
- Type III Barricade
- Traffic Lane

- ① Construct RCB's across & along the Frontage Road Left. Construct channel improvements left. Existing traffic flow on Kellogg.
- ② After West Bound traffic has been shifted to the Frontage Road Left, construct RCB across existing East Bound lanes prior to shifting East Bound traffic to existing West Bound Lanes.
- ③ Shift East Bound lanes to existing West Bound lanes. Construct remaining RCB.

DSMR: RWM OPER: JGP Scale: 1:1000
12/1997/97.362/As-Builts/dgts/Val 4/Sh 82.3a-TC-RCBs-2.dgn Last Rev: 10-5-07 By: gdr

No.	Revisions	By	Date
CITY OF WICHITA STA. 17+090 RCB CONSTRUCTION SEQUENCE, TRAFFIC CONTROL & DETAILS SEDGWICK COUNTY			
Professional Engineering Consultants, P.A. 303 S. TOPEKA • WICHITA, KANSAS 67202 316-262-2691 • FAX 316-262-3003			
Designed by	RWM	Checked by	WDH
Drawn by	JSB	Date	April, 2002
		Job No.	97362