
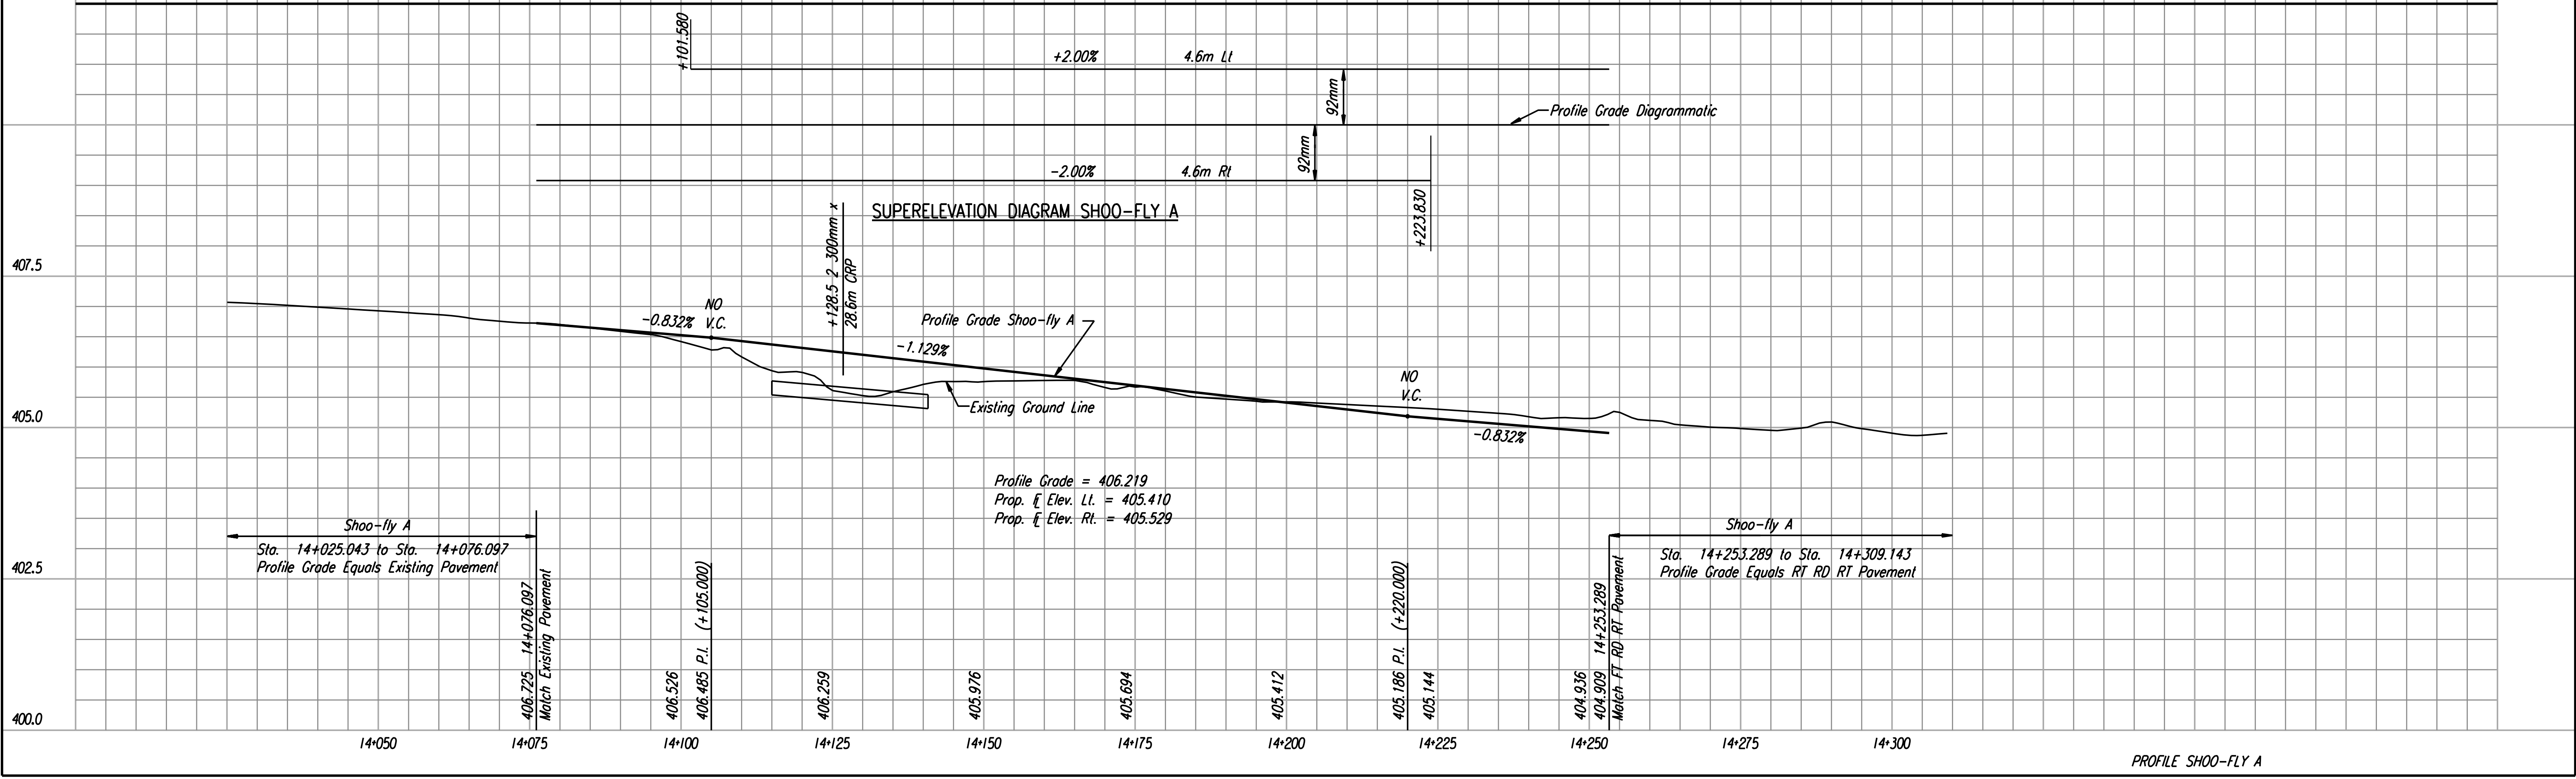


DATE	
BY	
SURVEYED	
PLOTTED	
INKED	
DESIGNED	
SQUAD	

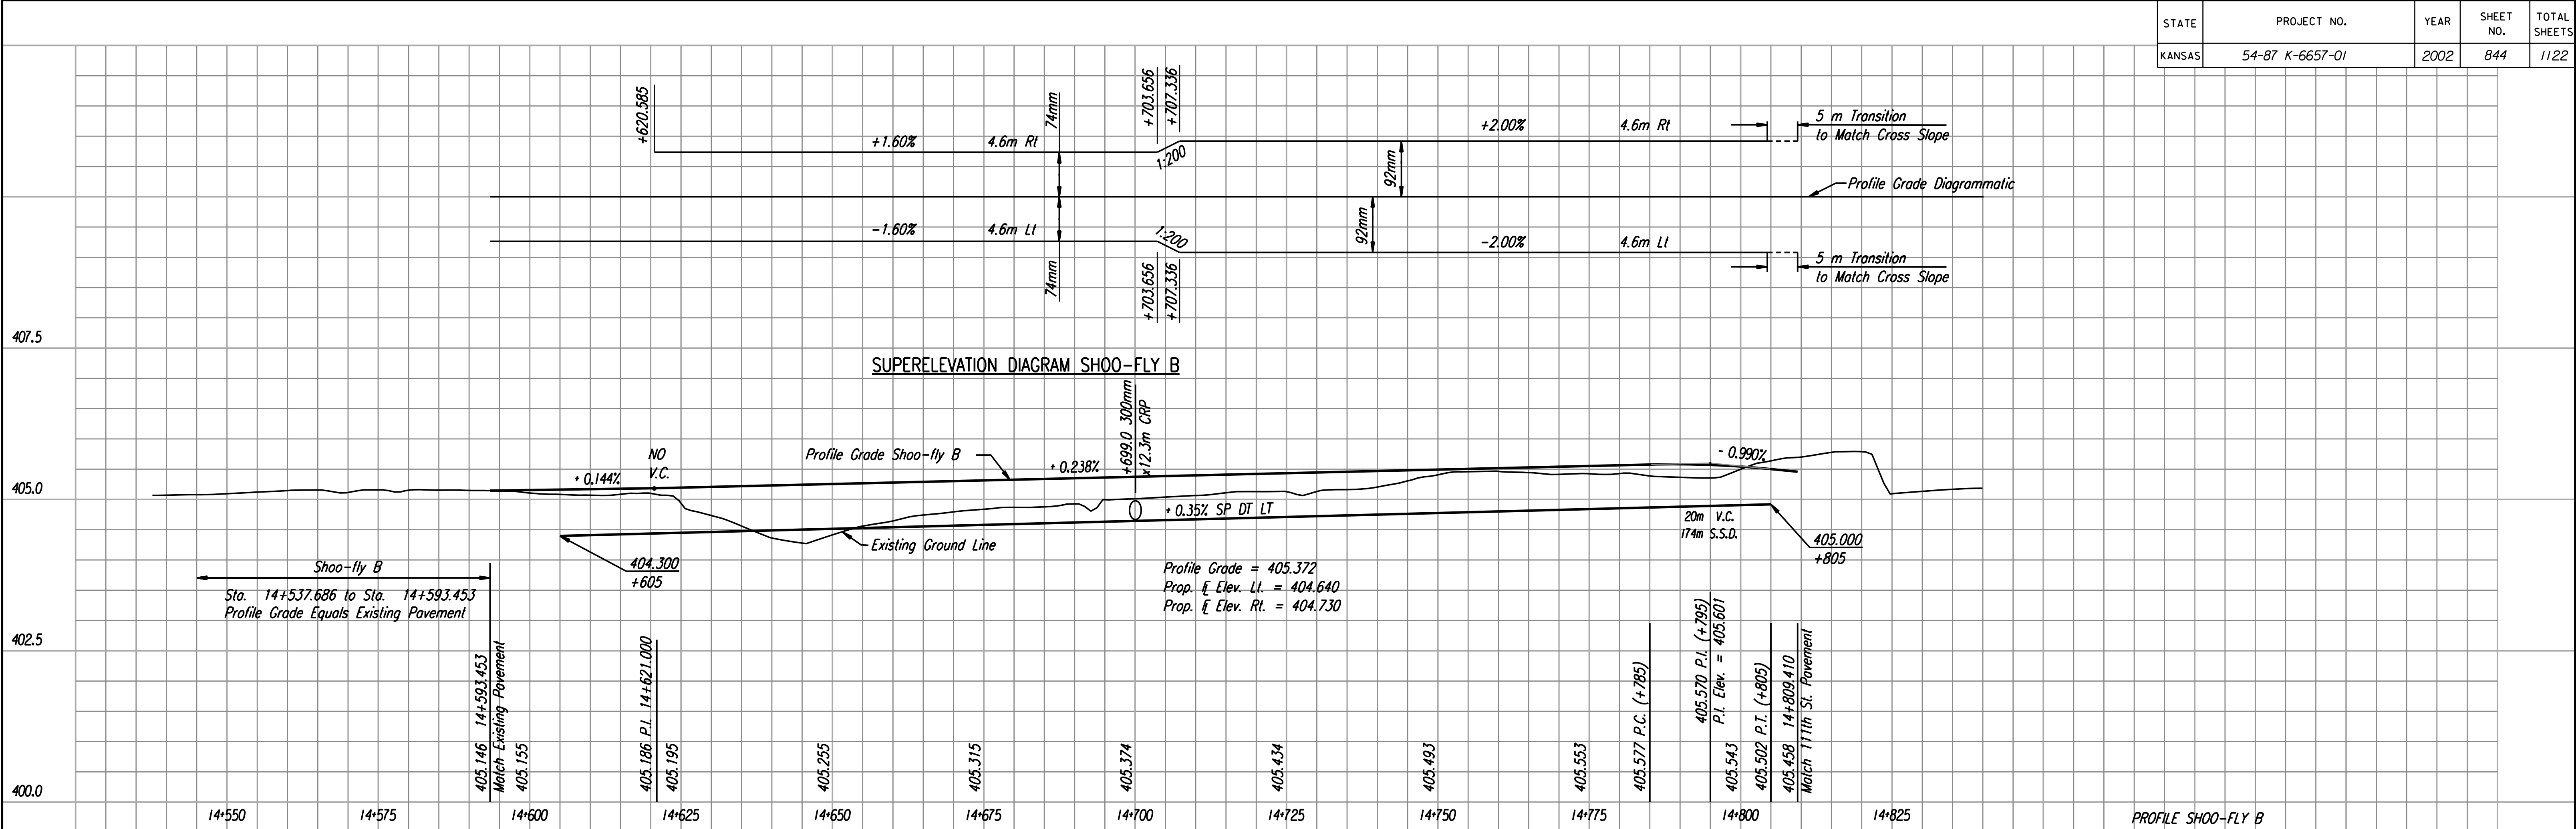

DSNR: RMM OPER: JSB Scale: 1:500
 11/1997/97362/As-Builts/dgn/s/Vol 4/Sh 844-Shoo-fly-ShooA.dgn Last Rev: 10-8-07 By: gdr