


STATE	PROJECT NO.	YEAR	SHEET NO.	TOTAL SHEETS
KANSAS	54-87 K-6657-01	2002	845	1122

DATE	
BY	
SURVEYED	
PLOTTED	
INKED	
DESIGNED	
SQUAD	

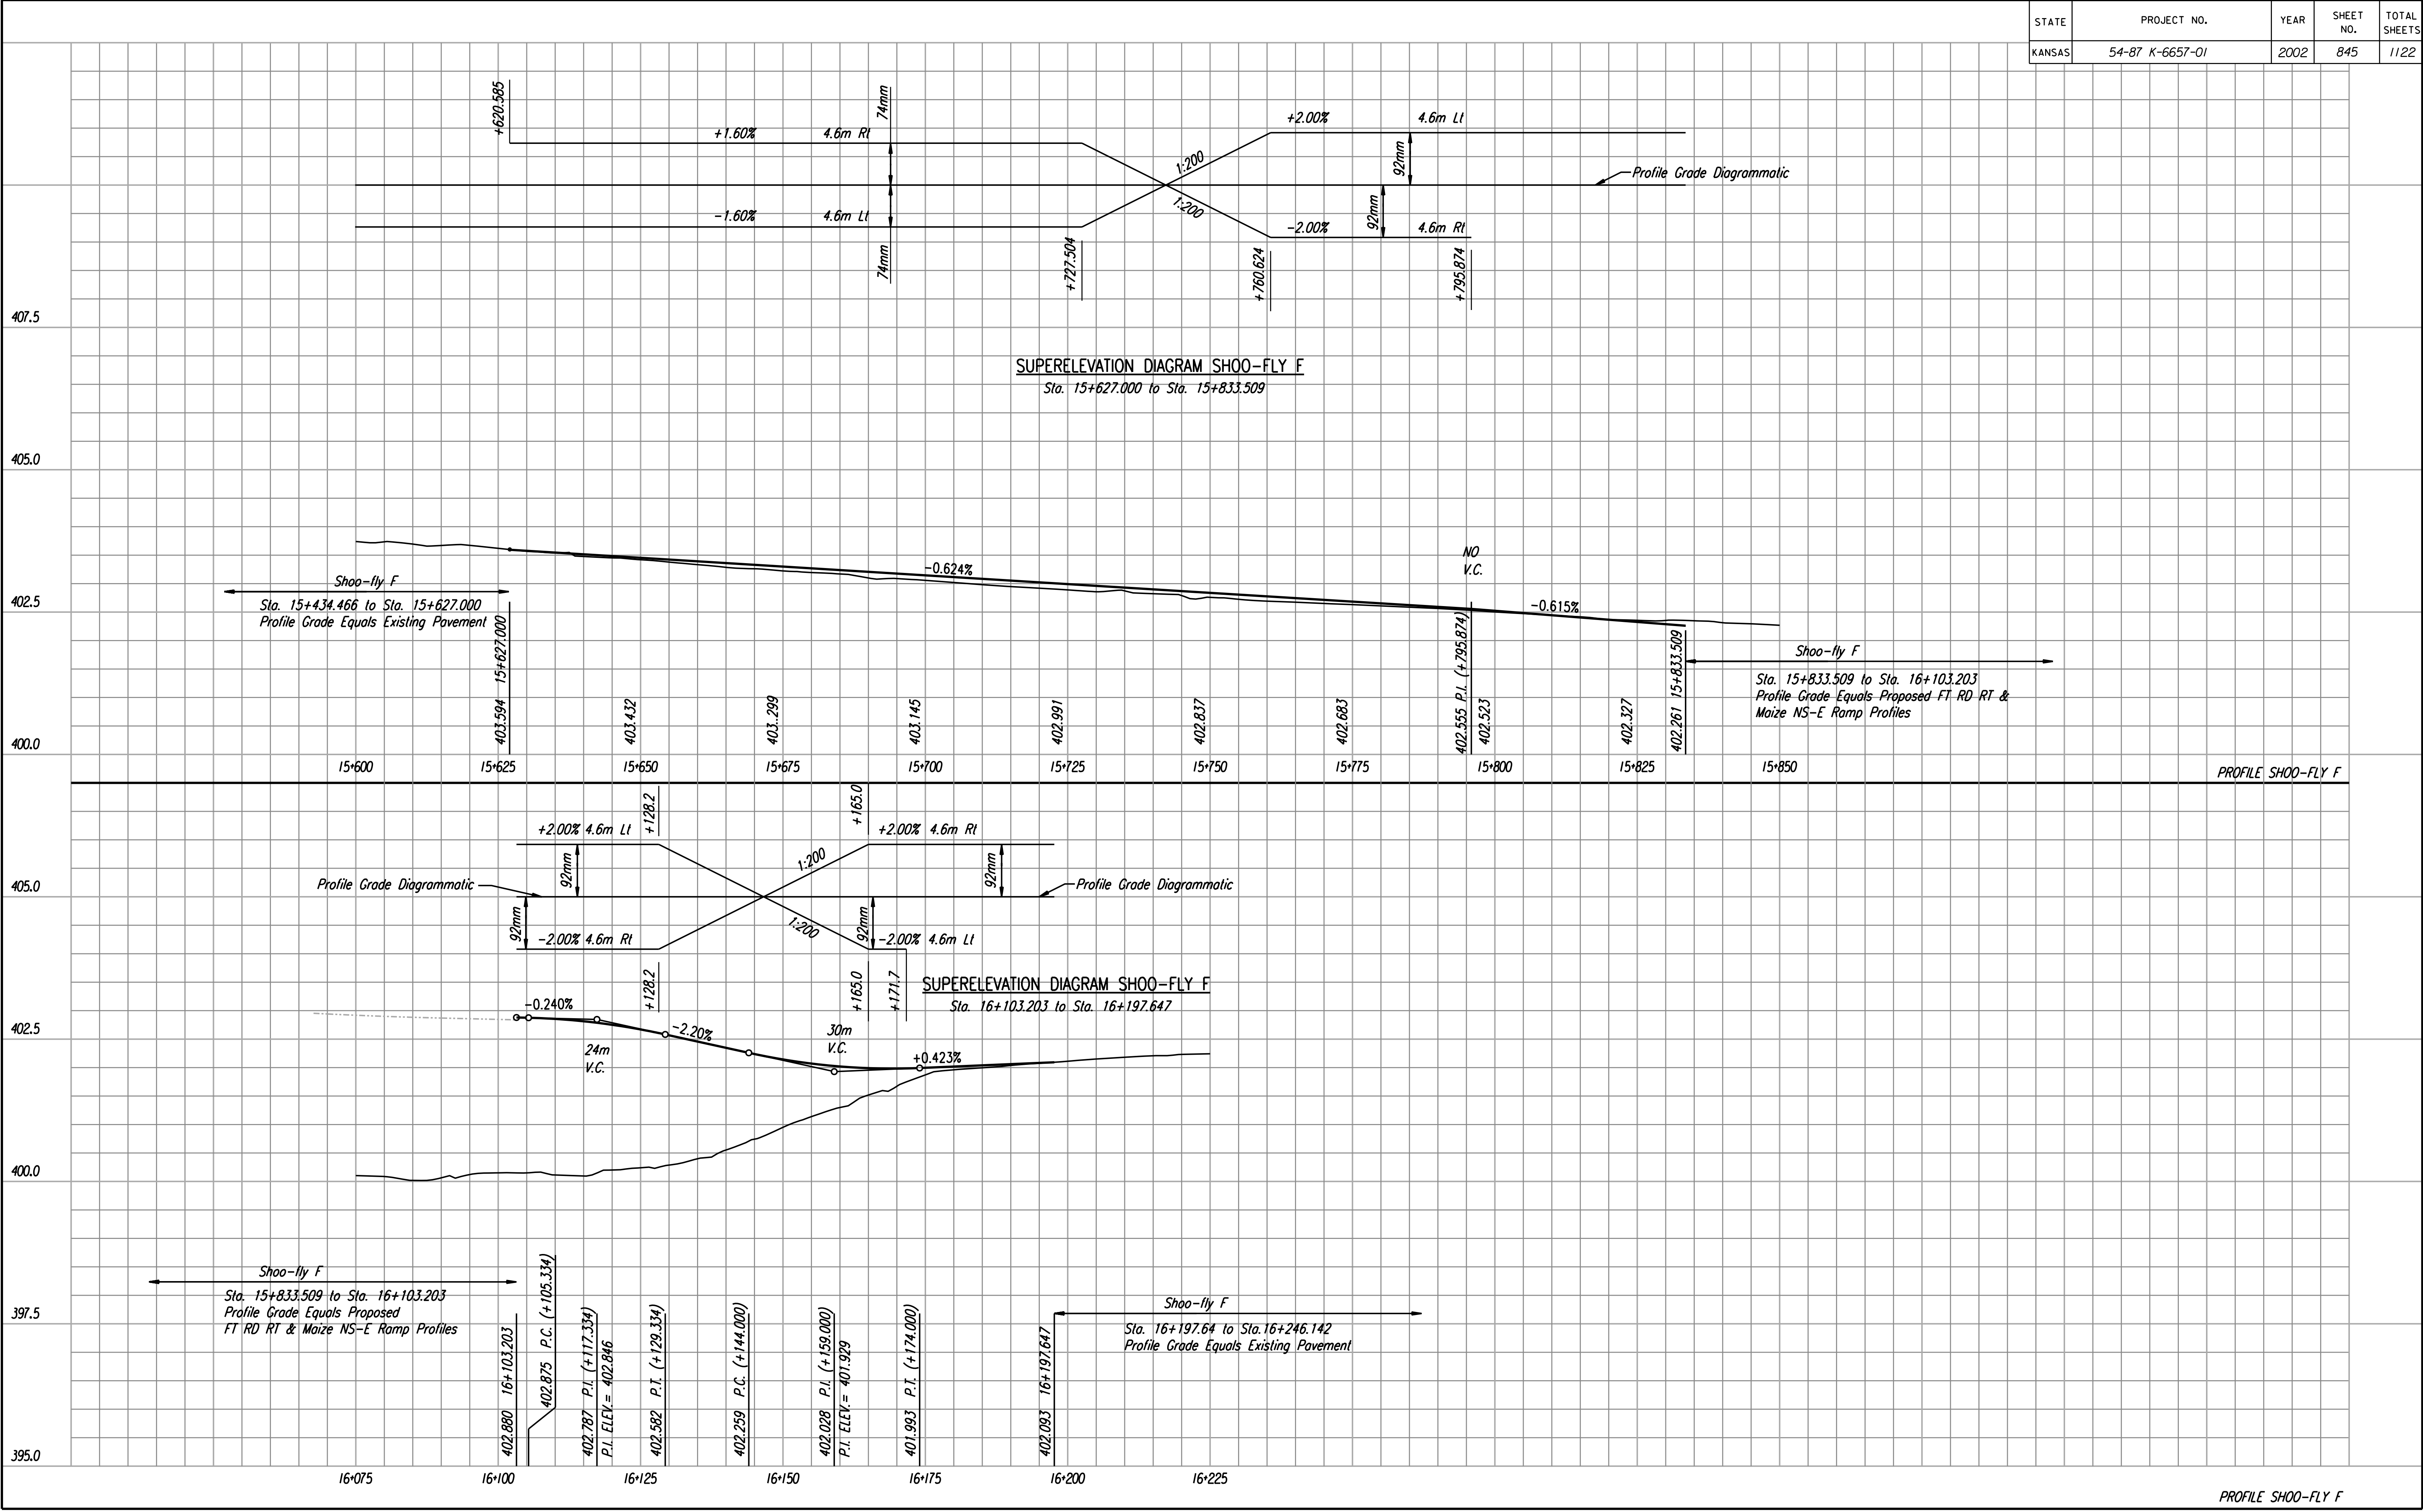

DSMR: RMM OPER: JSB Scale: 1:500  
 11/1997/97362/As-Builts/dgn/s/Vol 4/Sh 845-Shoo-fly-ShooF.dgn Last Rev. 10-8-07 By: gdr