


REG. NO.	STATE	PROJECT NO.	YEAR	SHEET NO.	TOTAL SHEETS
7	KANSAS	54-87 K-6657-01	2002	899	1122

FINAL SURVEY NO.	DATE
SURVEYED BY	
PLOTTED BY	
TEMPLATE AREAS CHECKED	
NO. AREAS CHECKED	

Scale : 100  
 Last Rev. : 10-12-07 By: gdr  
 Design File : i:/1997/9762/As-Built/dgn/s/Vol 5/Sh 0899-Mainline-xst3987Rt.dgn

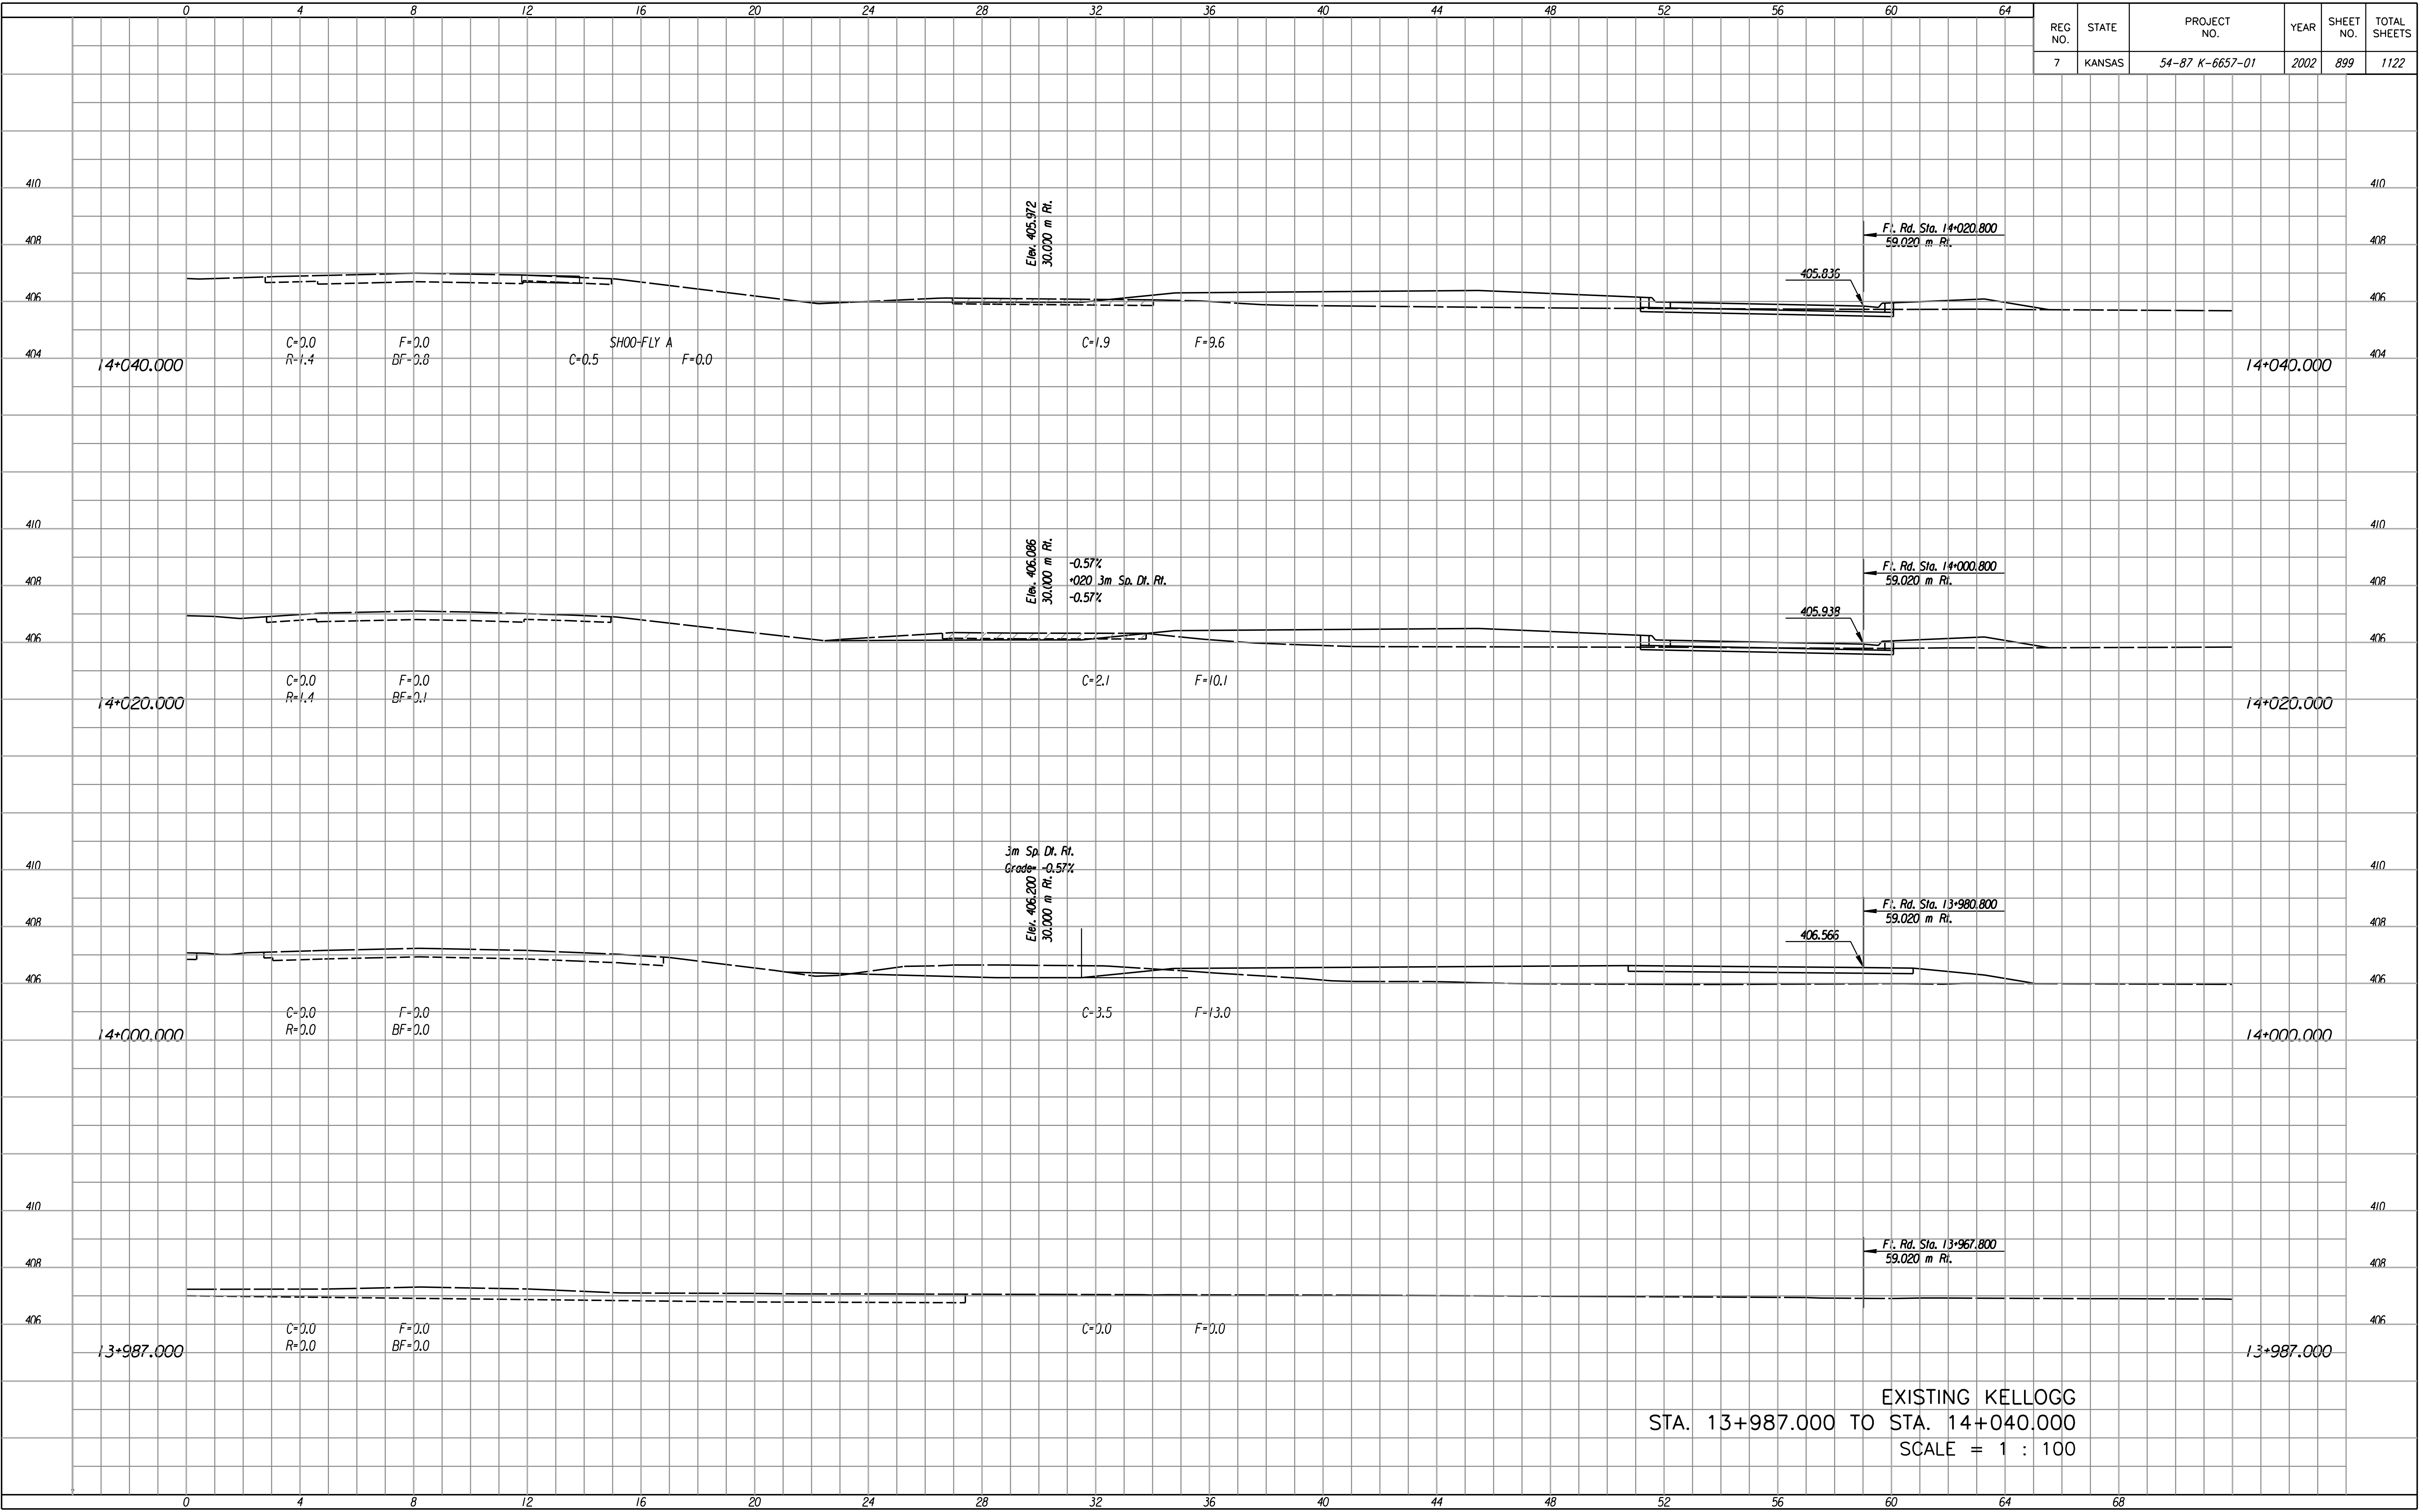

EXISTING KELLOGG  
 STA. 13+987.000 TO STA. 14+040.000  
 SCALE = 1 : 100