


REG NO.	STATE	PROJECT NO.	YEAR	SHEET NO.	TOTAL SHEETS
7	KANSAS	54-87 K-6657-01	2002	902	1122

FINAL SURVEY NO.	DATE
SURVEYED BY	DATE
PLOTTED BY	DATE
TEMPERATURE AREAS CHECKED	

Scale : 100
 Last Rev. : 10-12-07 By: gdr
 Design File : i:/1997/97162/As-Builts/dgn's/Vol 5/Sh 0902-Mainline-xst1201.dgn

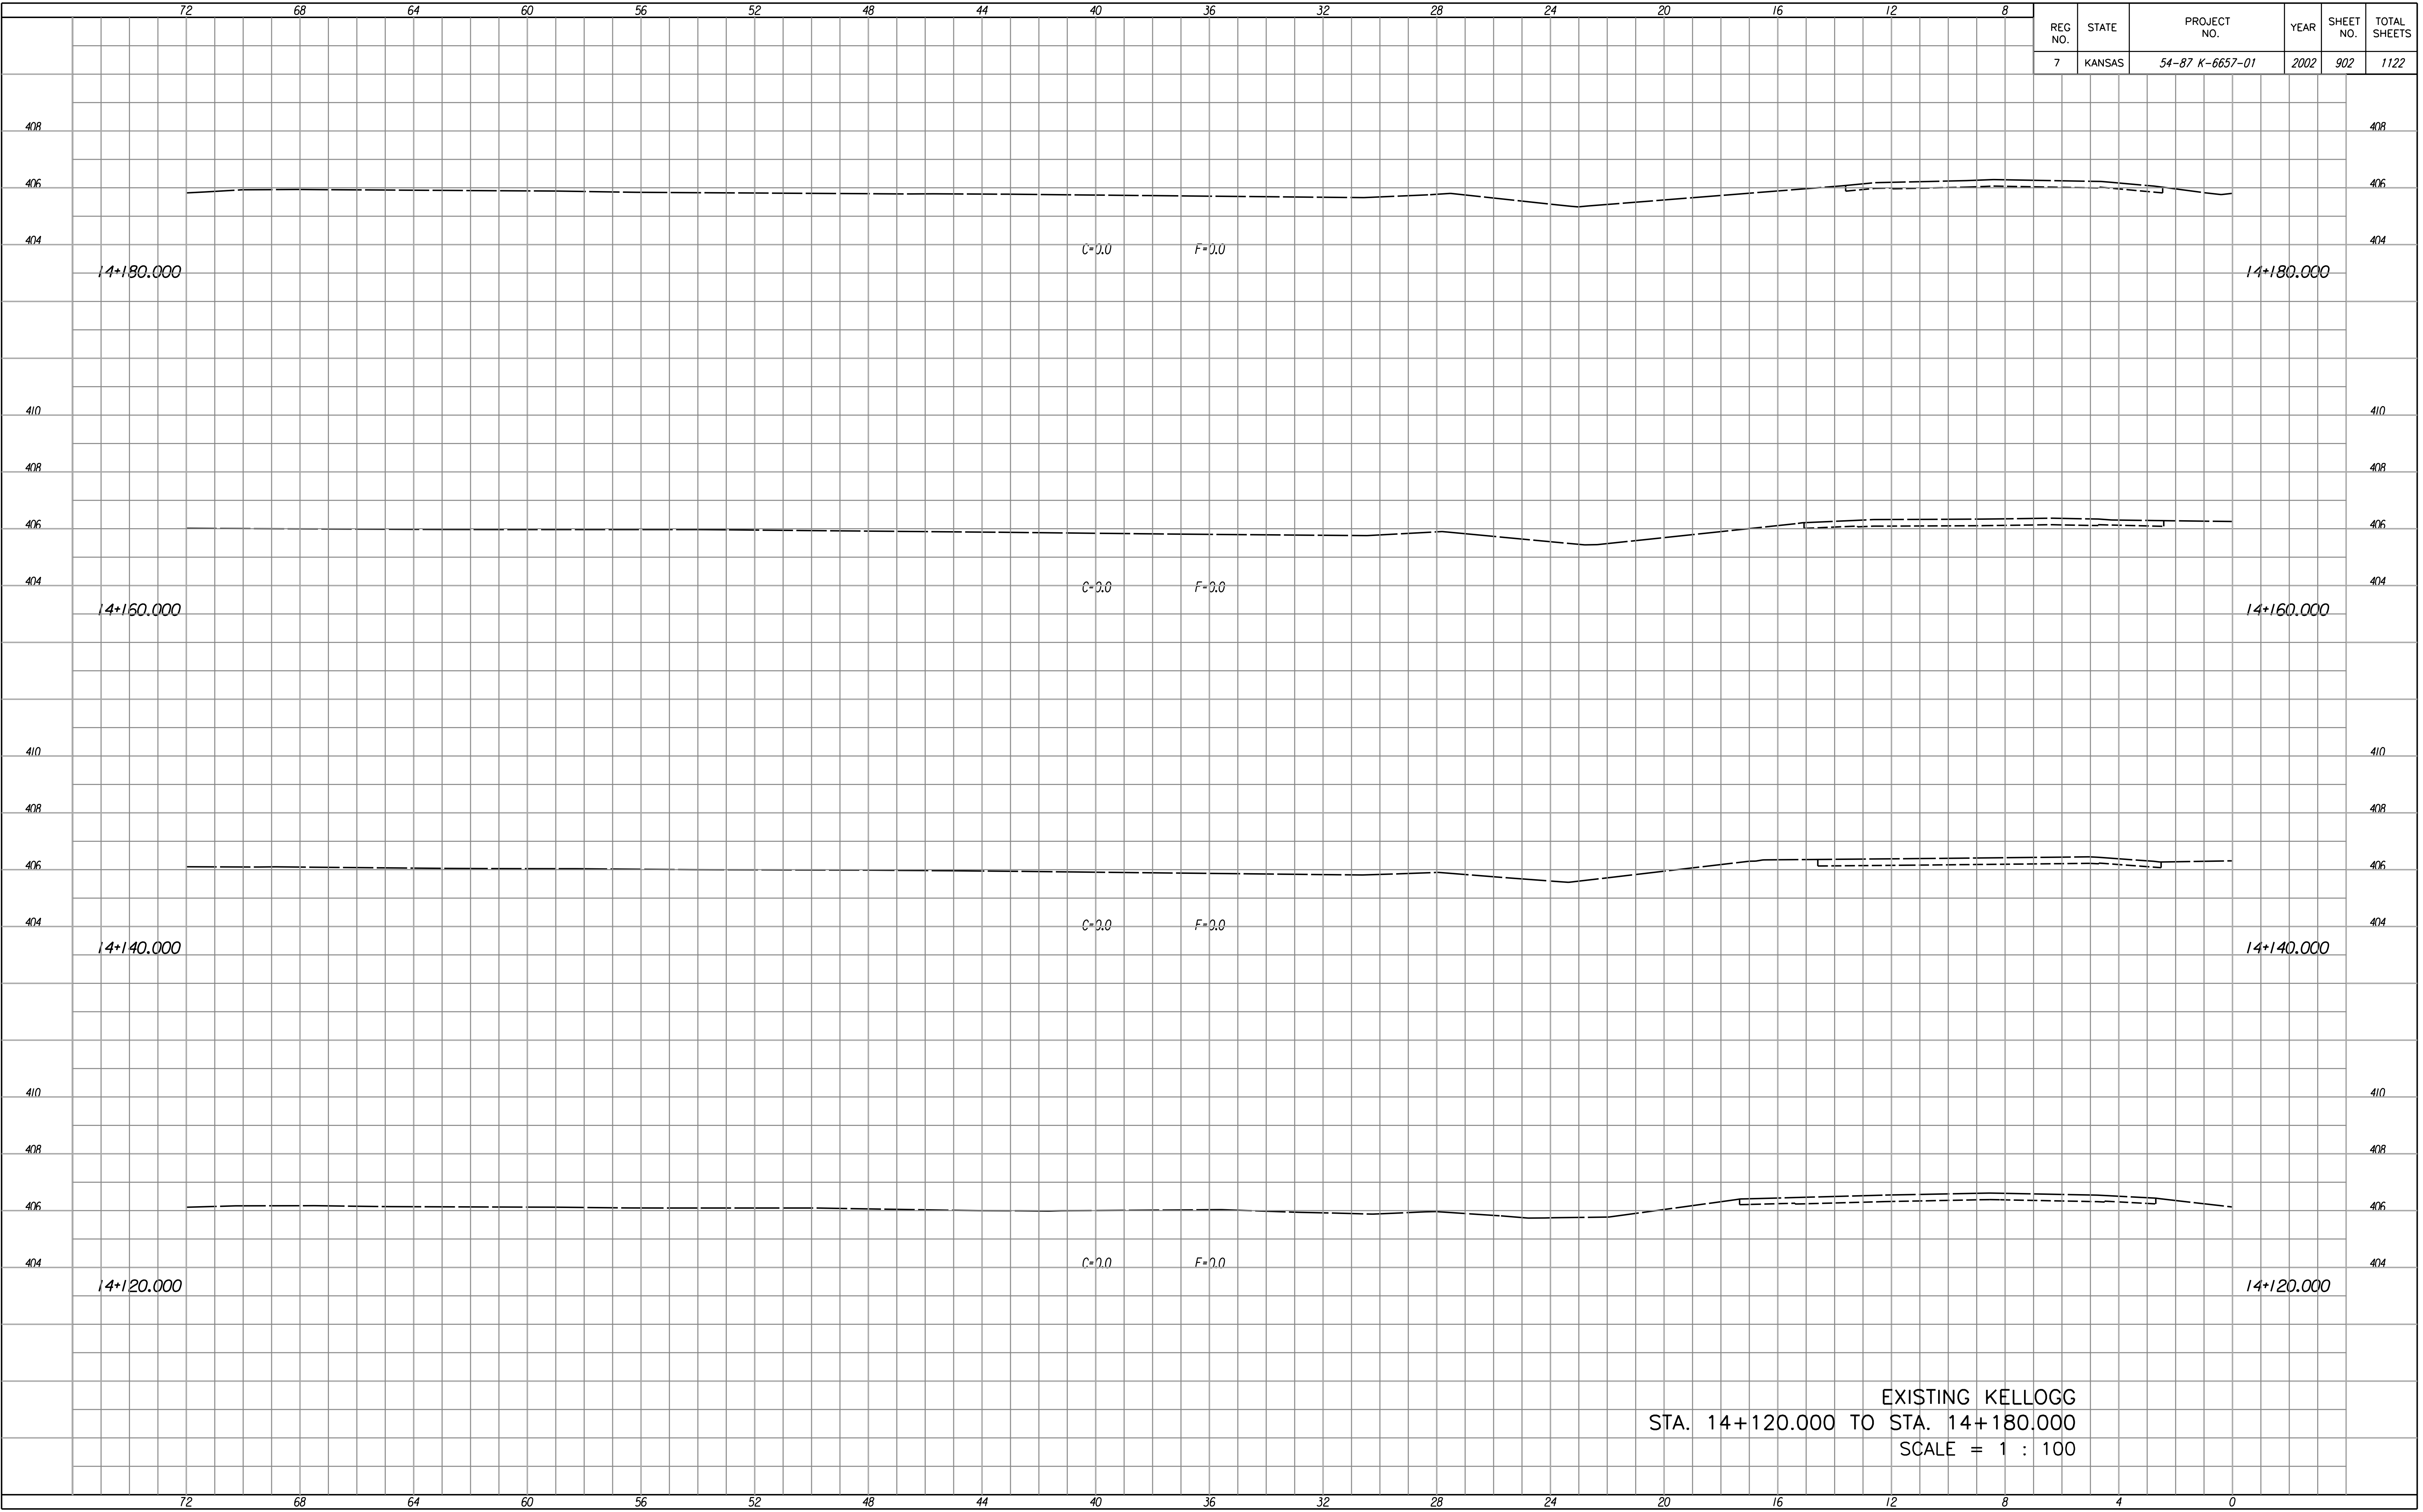

EXISTING KELLOGG
 STA. 14+120.000 TO STA. 14+180.000
 SCALE = 1 : 100