


REG. NO.	STATE	PROJECT NO.	YEAR	SHEET NO.	TOTAL SHEETS
7	KANSAS	54-87 K-6657-01	2002	903	1122

FINAL SURVEY NO.	DATE	BY

Scale : 100  
 Last Rev. : 10-12-07 By: gdr  
 Design File : i:/1997/97362/As-Builts/agn/s/Vol 5/Sh 0903-Mainline--xs14120R.dgn

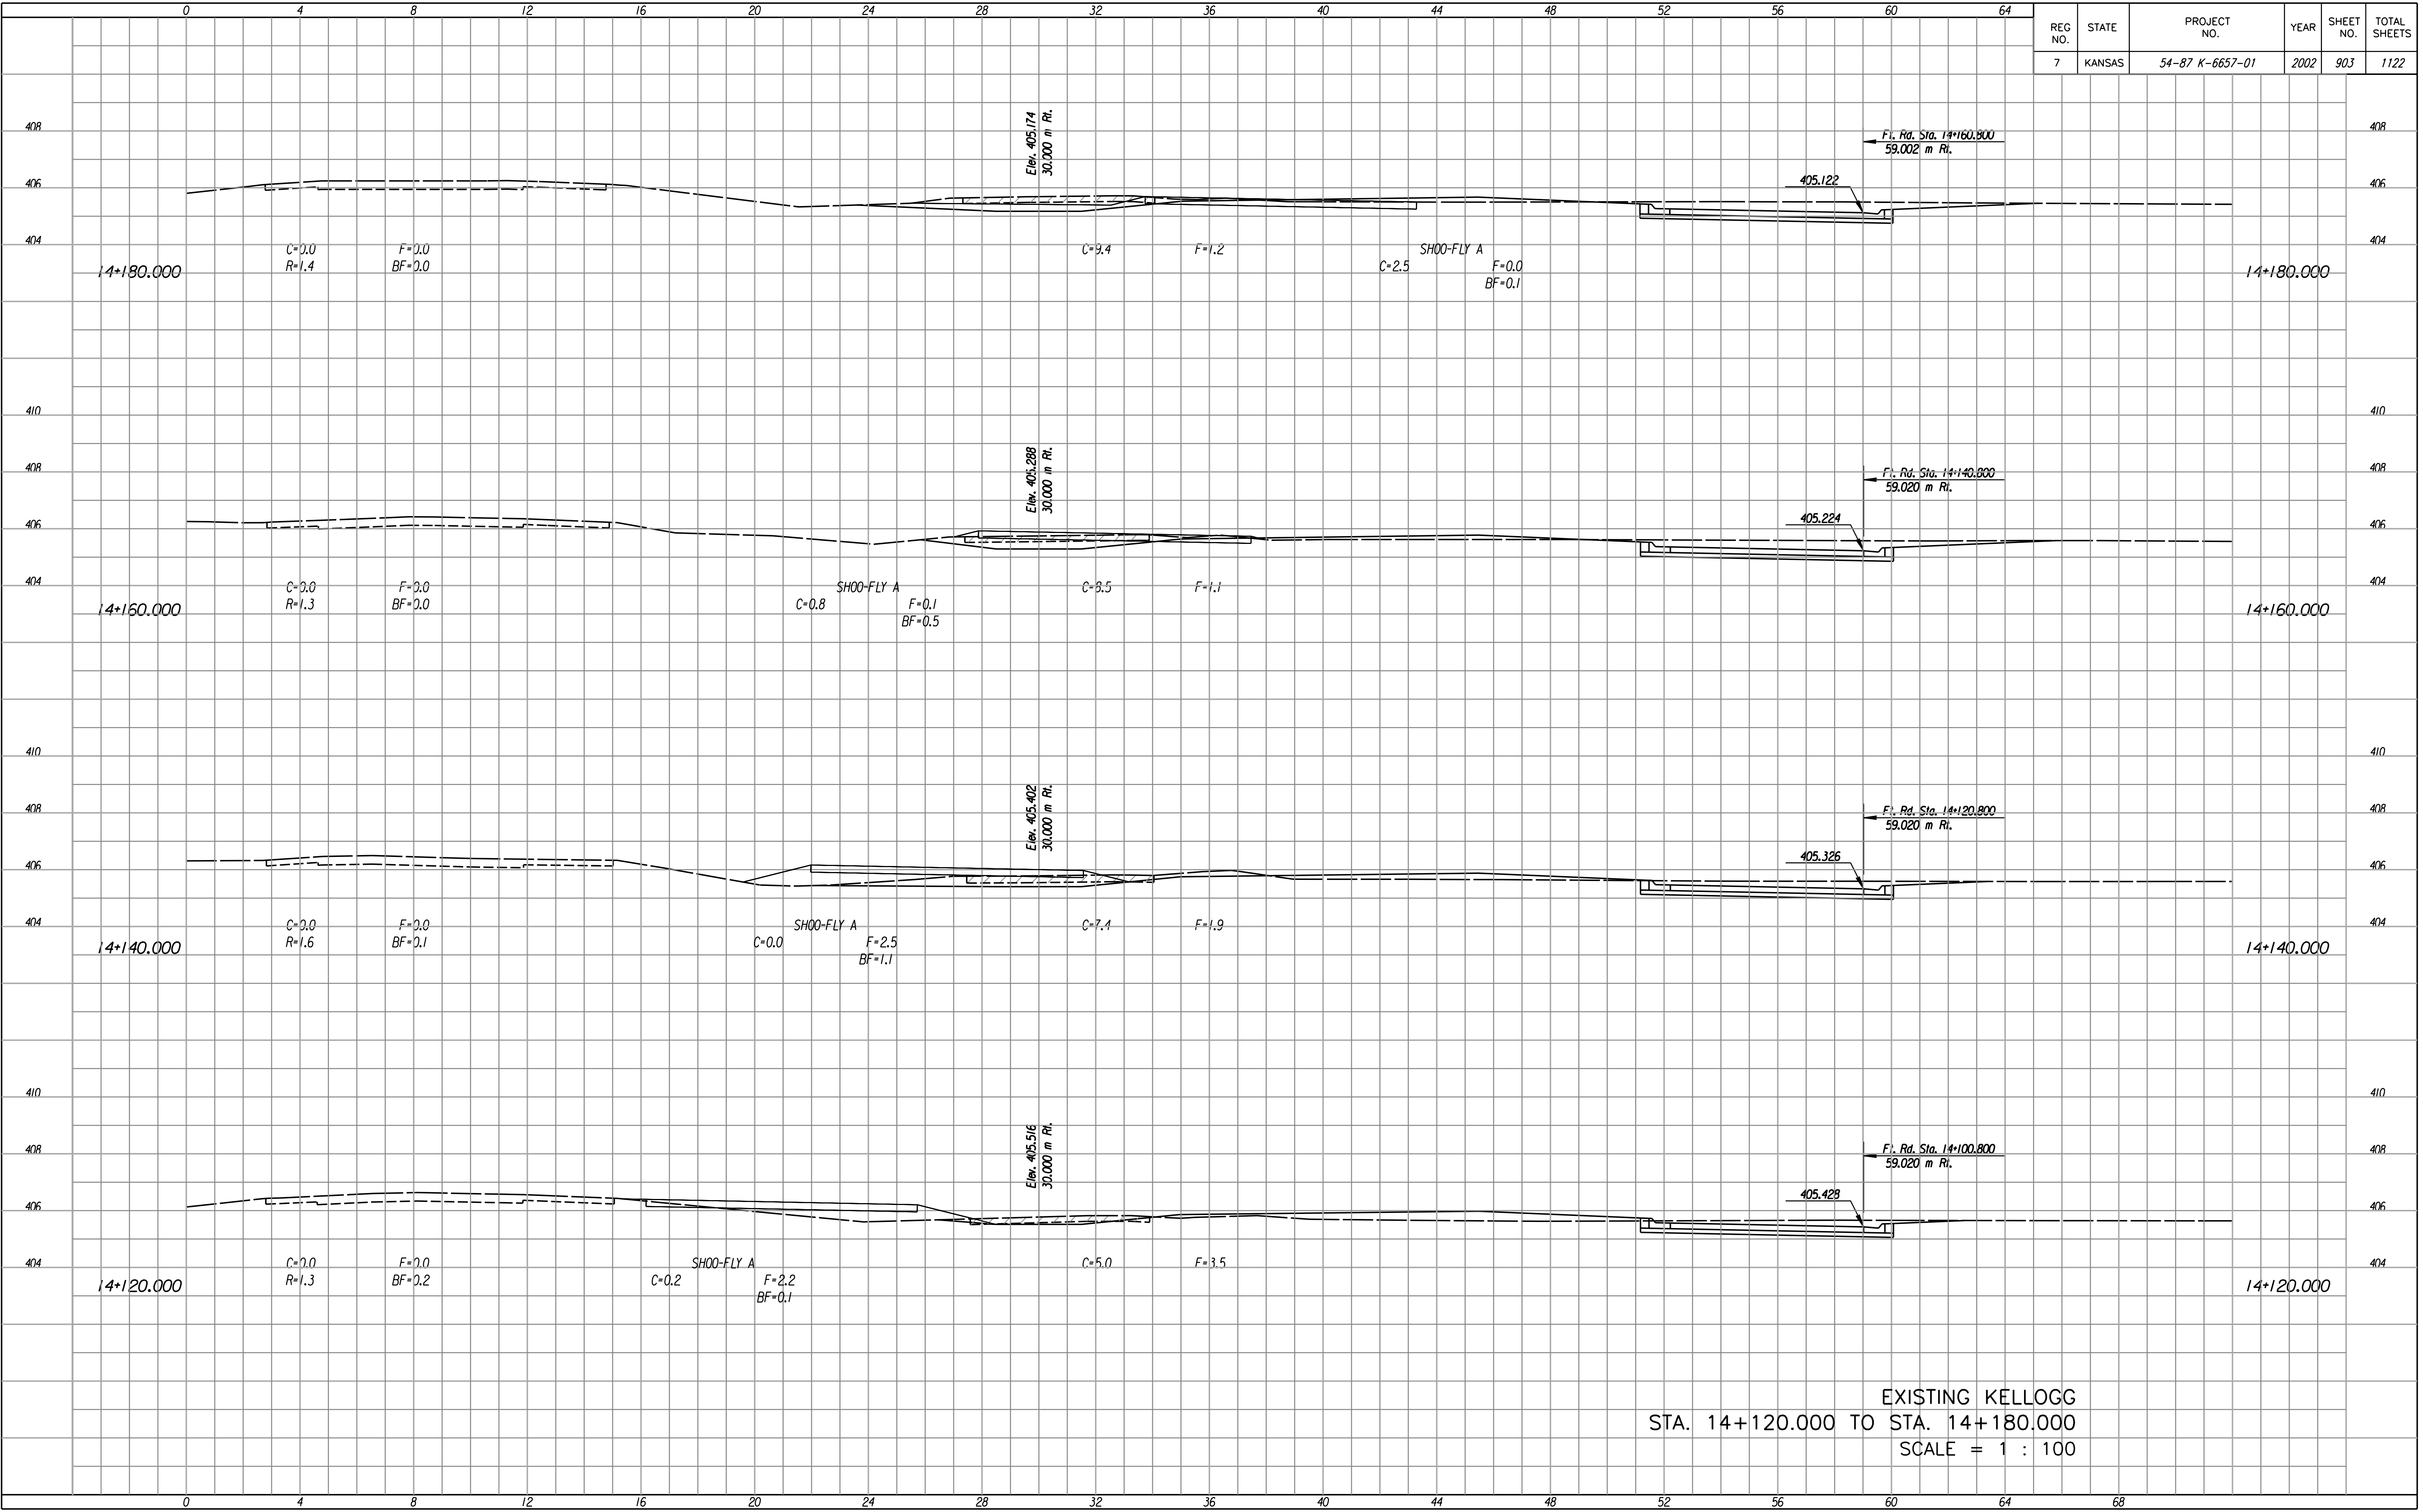

EXISTING KELLOGG  
 STA. 14+120.000 TO STA. 14+180.000  
 SCALE = 1 : 100