


REG. NO.	STATE	PROJECT NO.	YEAR	SHEET NO.	TOTAL SHEETS
7	KANSAS	54-87 K-6657-01	2002	909	1122

FINAL SURVEY NO.	DATE
SURVEYED BY	
PLOTTED BY	
TEMPLATE AREAS CHECKED	
NO.	

Scale : 100
 Last Rev. : 10-12-07 By: gdr
 Design File : i:/1997/97362/As-Builts/agn/s/Vol 5/Sh 0909-Mainline--xs14360R.dgn

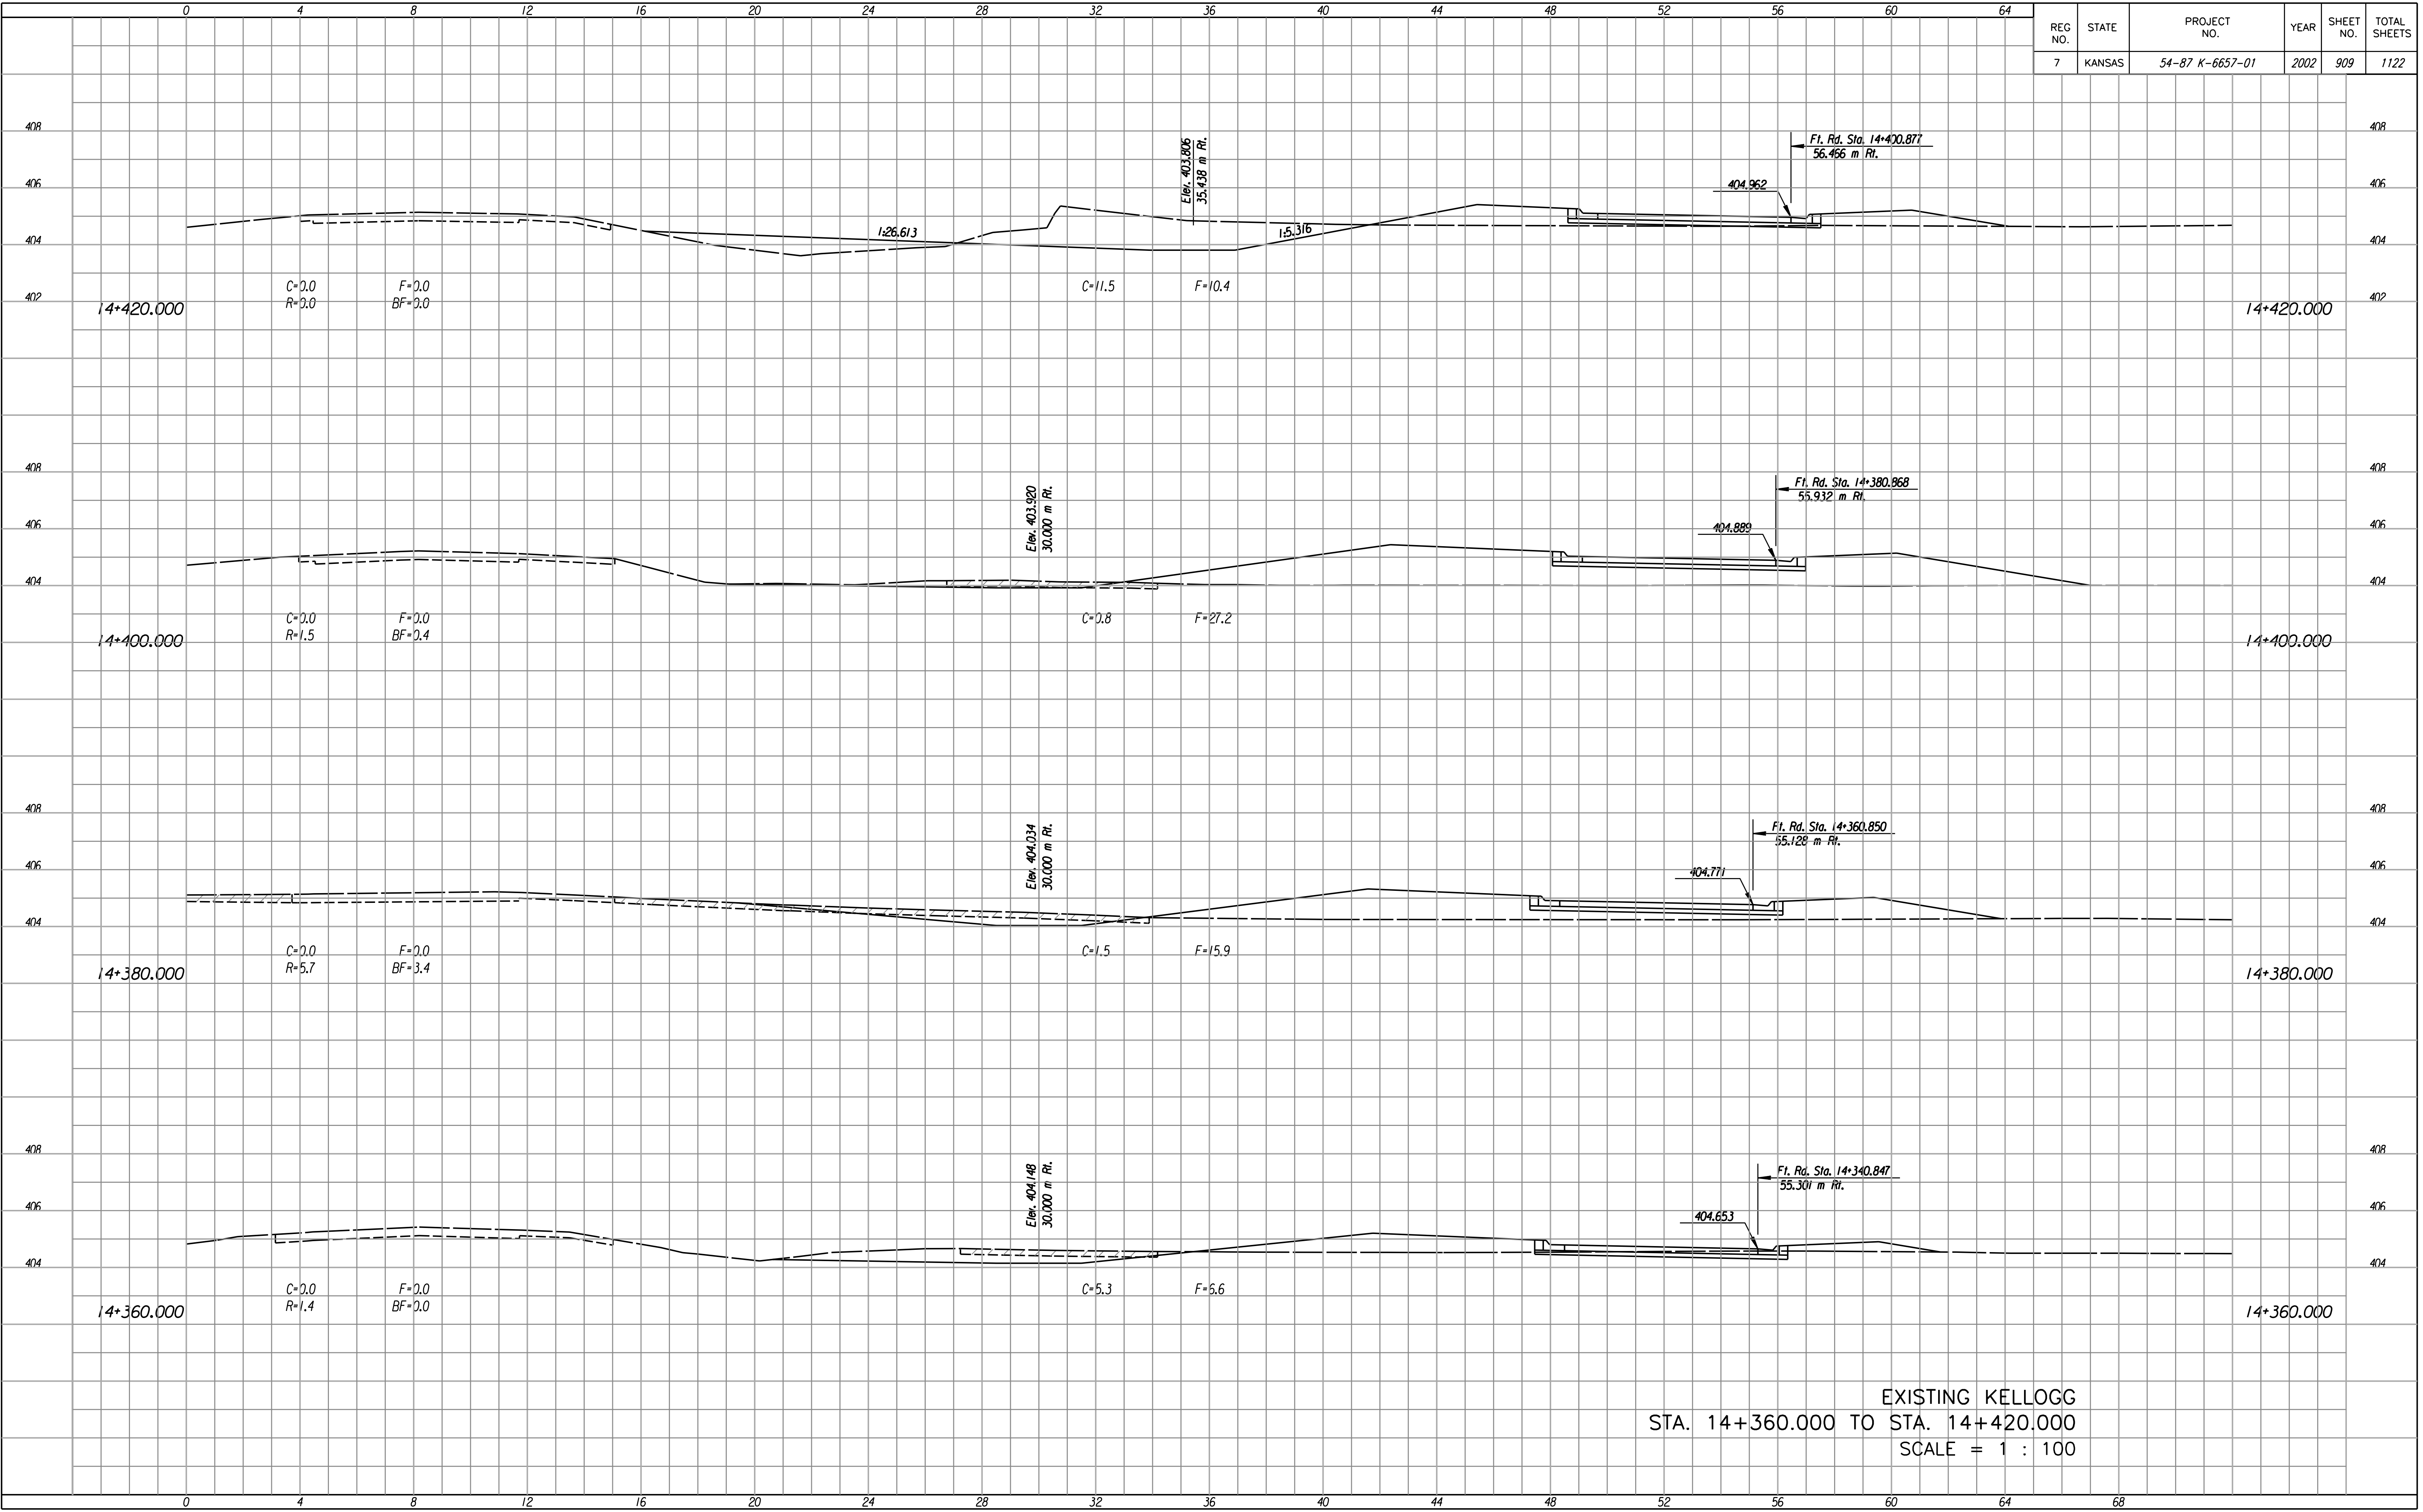

EXISTING KELLOGG
 STA. 14+360.000 TO STA. 14+420.000
 SCALE = 1 : 100