


REG NO.	STATE	PROJECT NO.	YEAR	SHEET NO.	TOTAL SHEETS
7	KANSAS	54-87 K-6657-01	2002	910	1122

FINAL SURVEY NO.	BY	DATE
SURVEYED		
PLOTTED		
TEMPLATE		
AREAS		
CHECKED		

Scale : 100
 Last Rev. : 10-12-07 By: gdr
 Design File : i:/1997/97662/As-Builts/dgn/s/Vol 5/Sh 0910-Mainline-xS144401.dgn

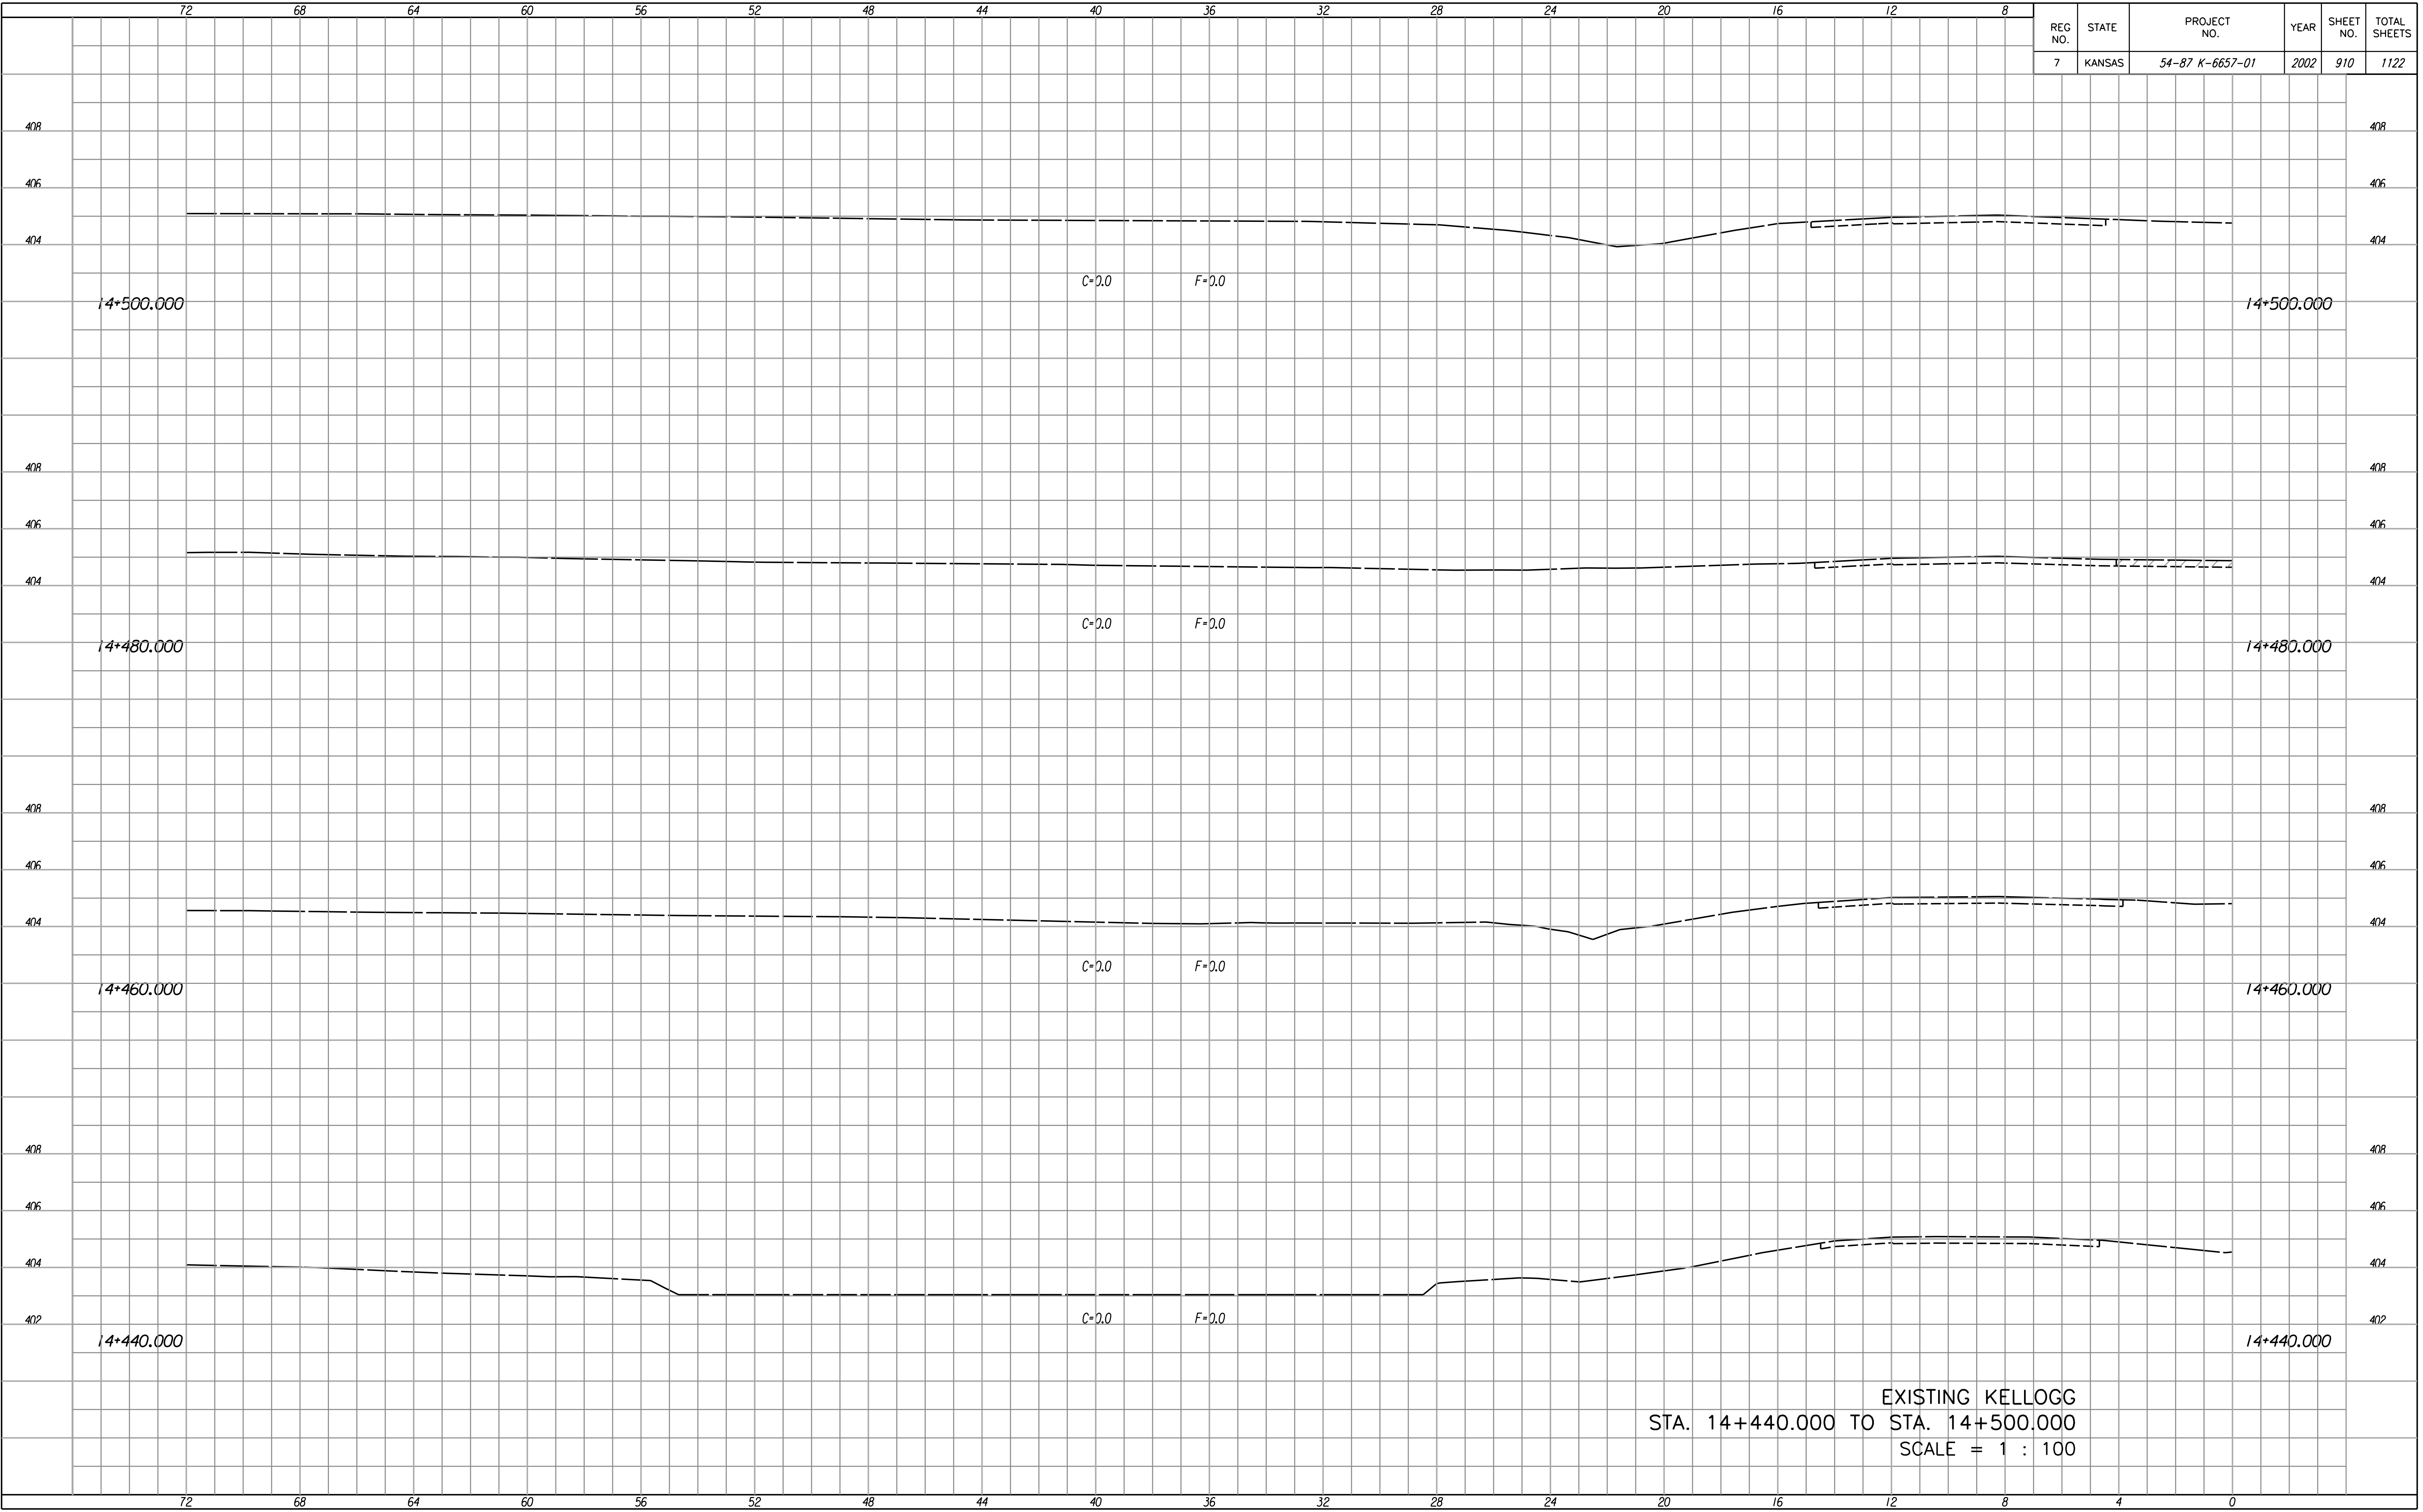

EXISTING KELLOGG
 STA. 14+440.000 TO STA. 14+500.000
 SCALE = 1 : 100