


REG. NO.	STATE	PROJECT NO.	YEAR	SHEET NO.	TOTAL SHEETS
7	KANSAS	54-87 K-6657-01	2002	911	1122

FINAL SURVEY NO.	DATE
SURVEYED BY	DATE
PLOTTED BY	DATE
TEMPLE AREAS CHECKED	DATE

Scale : 100
 Last Rev. : 10-12-07 By: gdr
 Design File : i:/1997/97362/As-Builts/dgn's/Vol 5/Sh 0911-Mainline-xs14440R.dgn

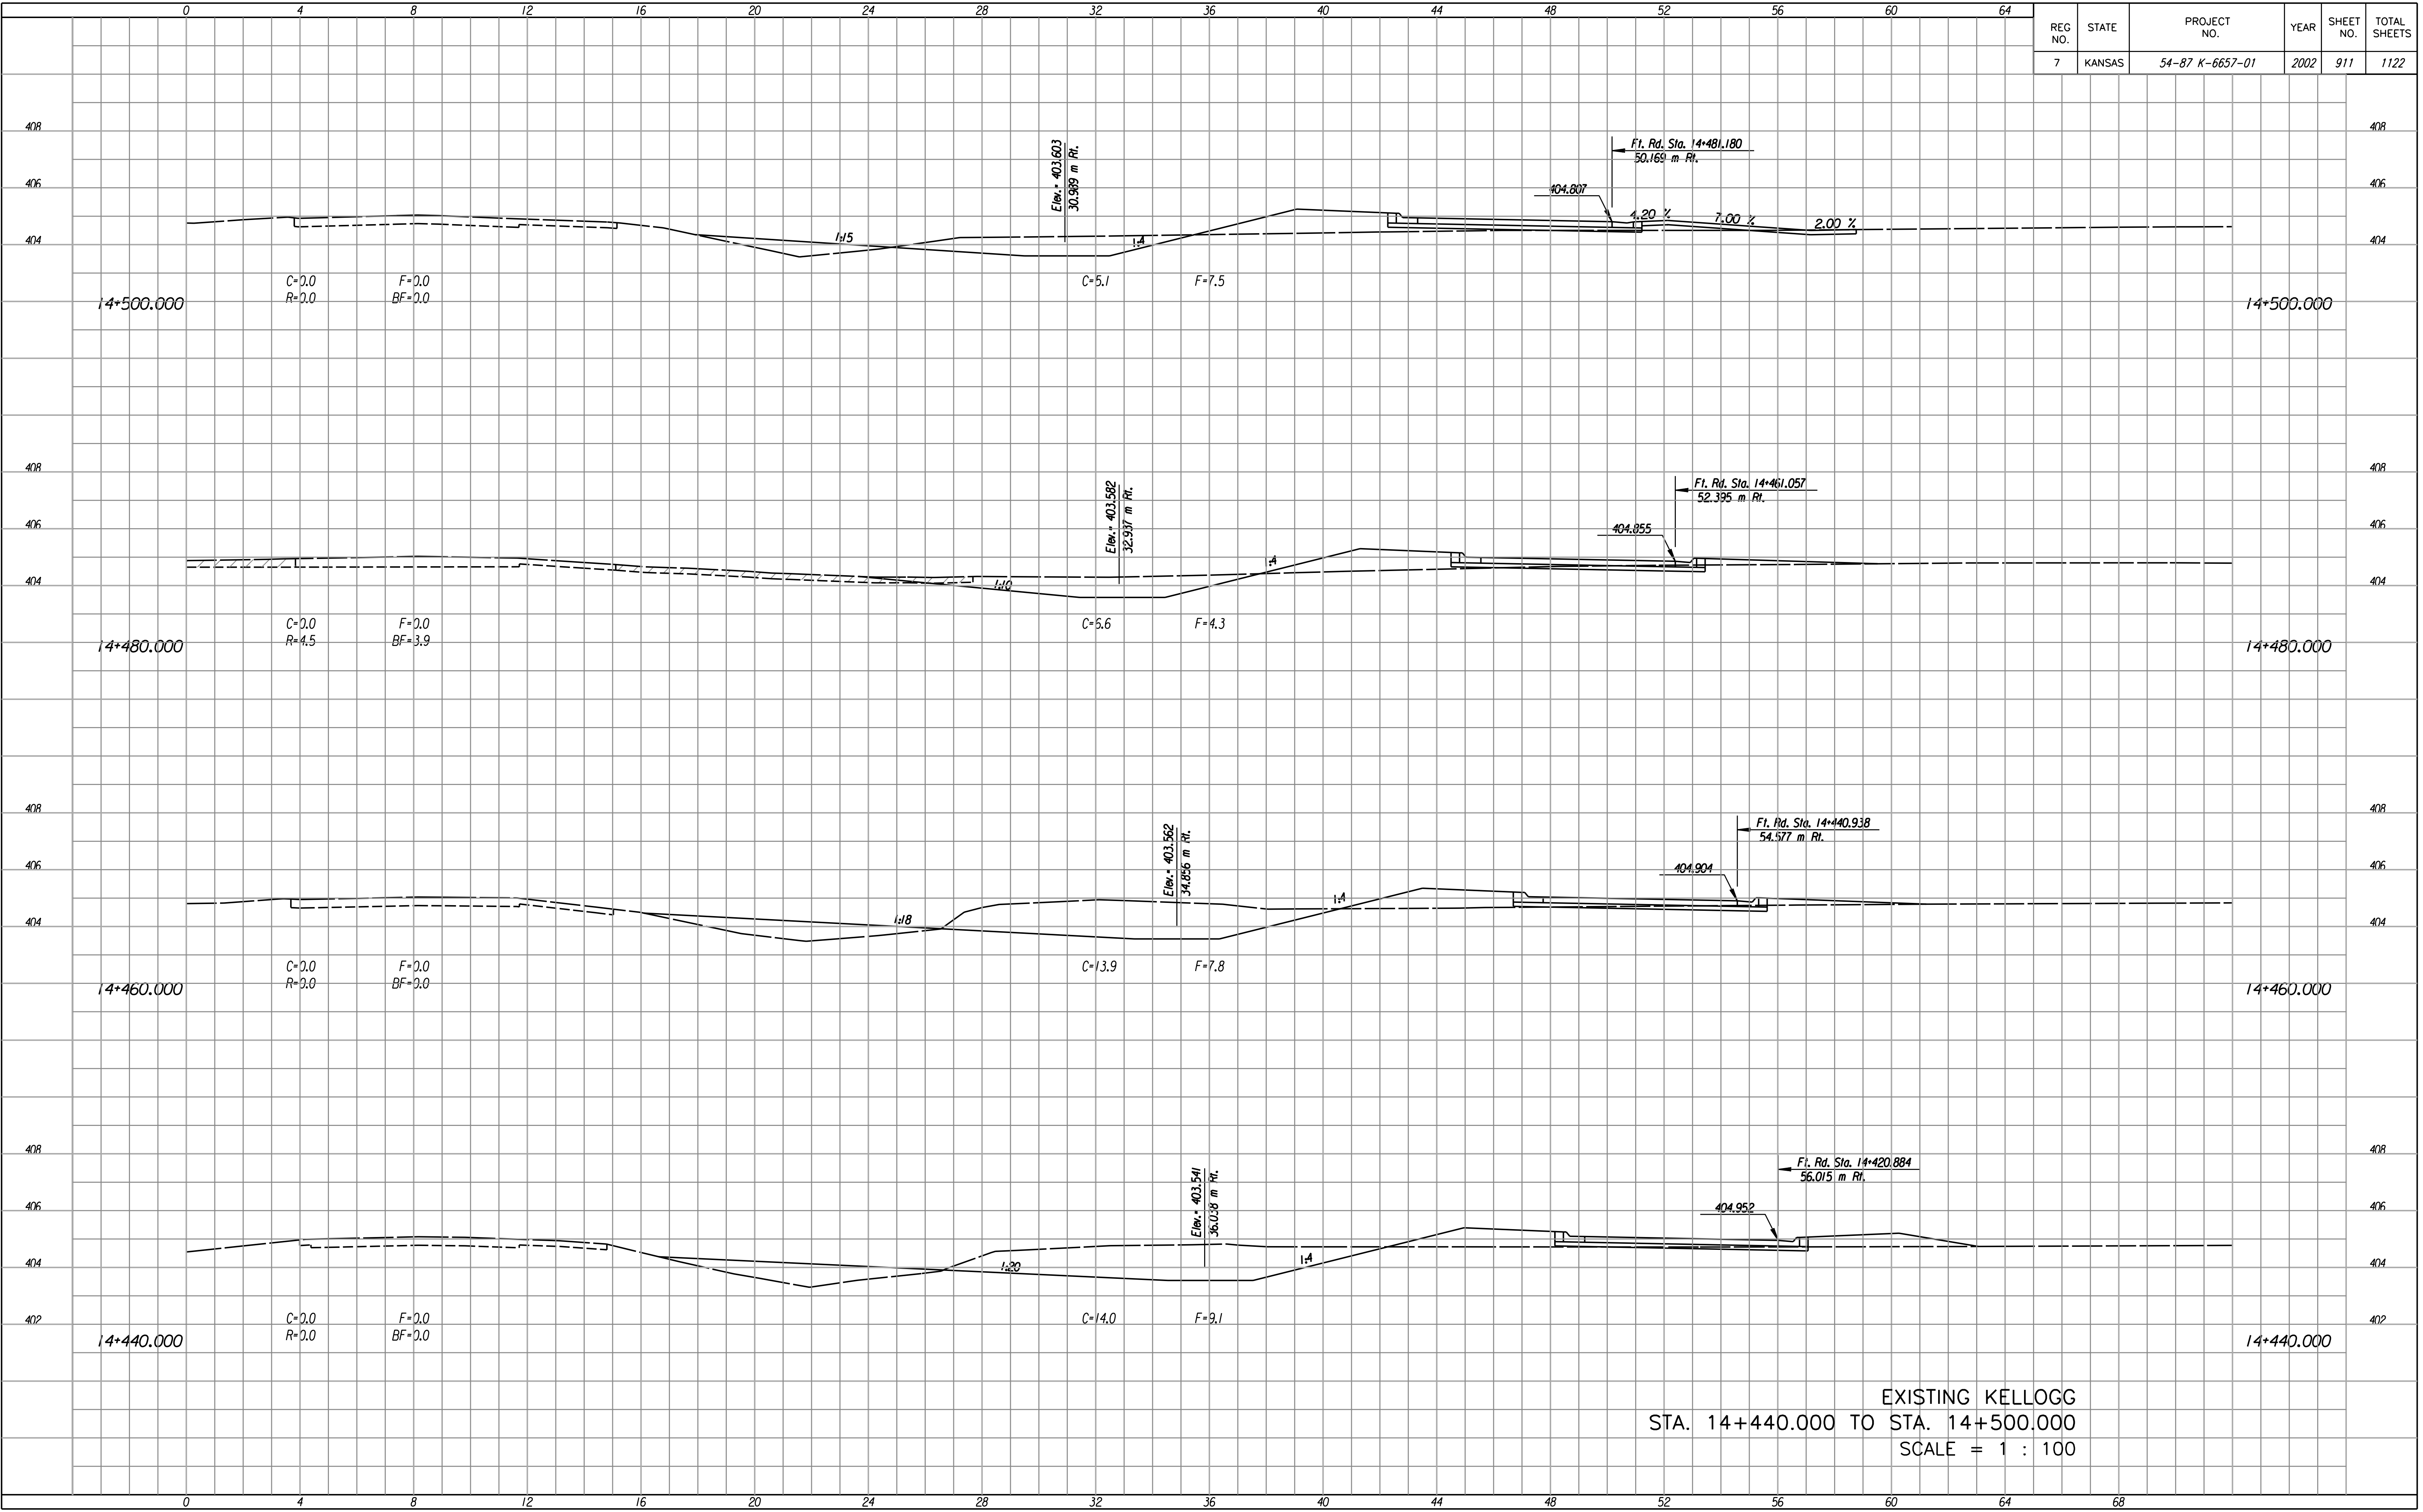

EXISTING KELLOGG
 STA. 14+440.000 TO STA. 14+500.000
 SCALE = 1 : 100