


REG. NO.	STATE	PROJECT NO.	YEAR	SHEET NO.	TOTAL SHEETS
7	KANSAS	54-87 K-6657-01	2002	913	1122

FINAL SURVEY NO.	DATE
SURVEYED	
PLOTTED	
TEMPLATE AREAS CHECKED	
NO. OF AREAS CHECKED	

Scale : 100
 Last Rev. : 10-12-07 By: gdr
 Design File : i:/1997/97362/As-Builts/agn/s/Vol 5/Sh 0913-Mainline--xs14520R1.dgn

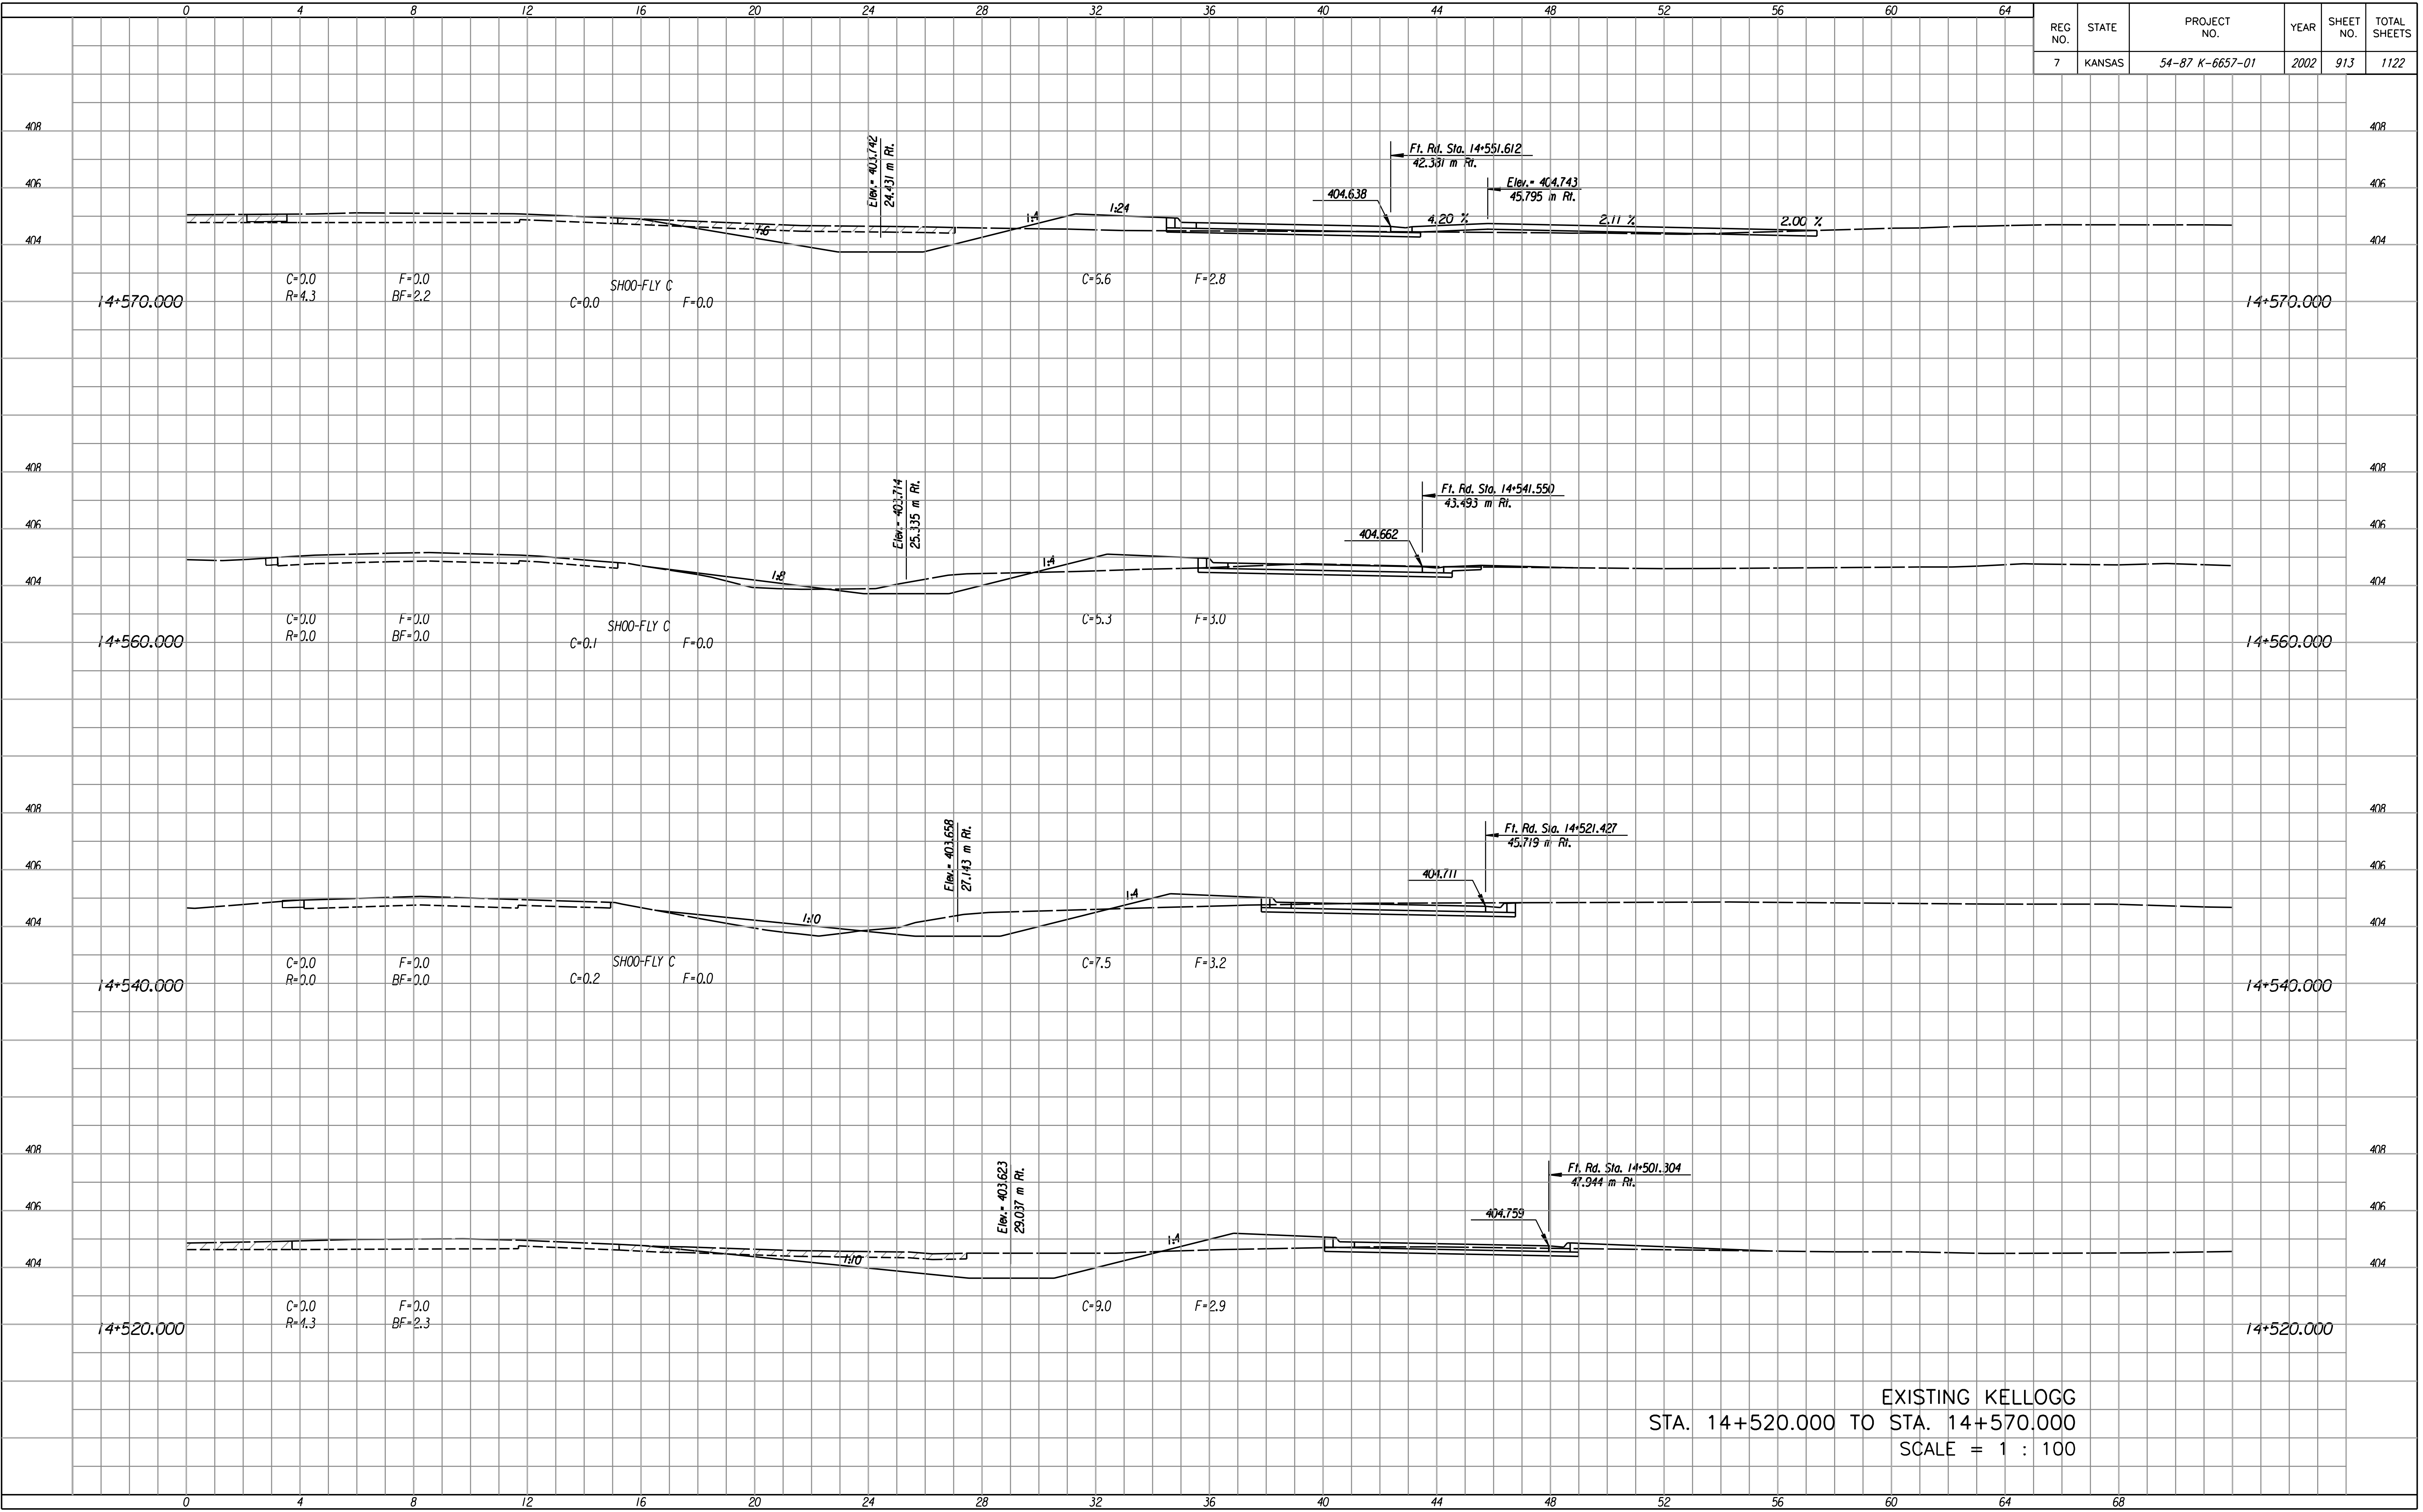

EXISTING KELLOGG
 STA. 14+520.000 TO STA. 14+570.000
 SCALE = 1 : 100