


REG NO.	STATE	PROJECT NO.	YEAR	SHEET NO.	TOTAL SHEETS
7	KANSAS	54-87 K-6657-01	2002	920	1122

FINAL SURVEY NO.	BY	DATE

Scale : 100
 Last Rev. : 10-12-07 By: gdr
 Design File : i:/1997/97562/As-Builts/dgn/s/Vol 5/Sh 0920-Mainline-rs14800L.dgn

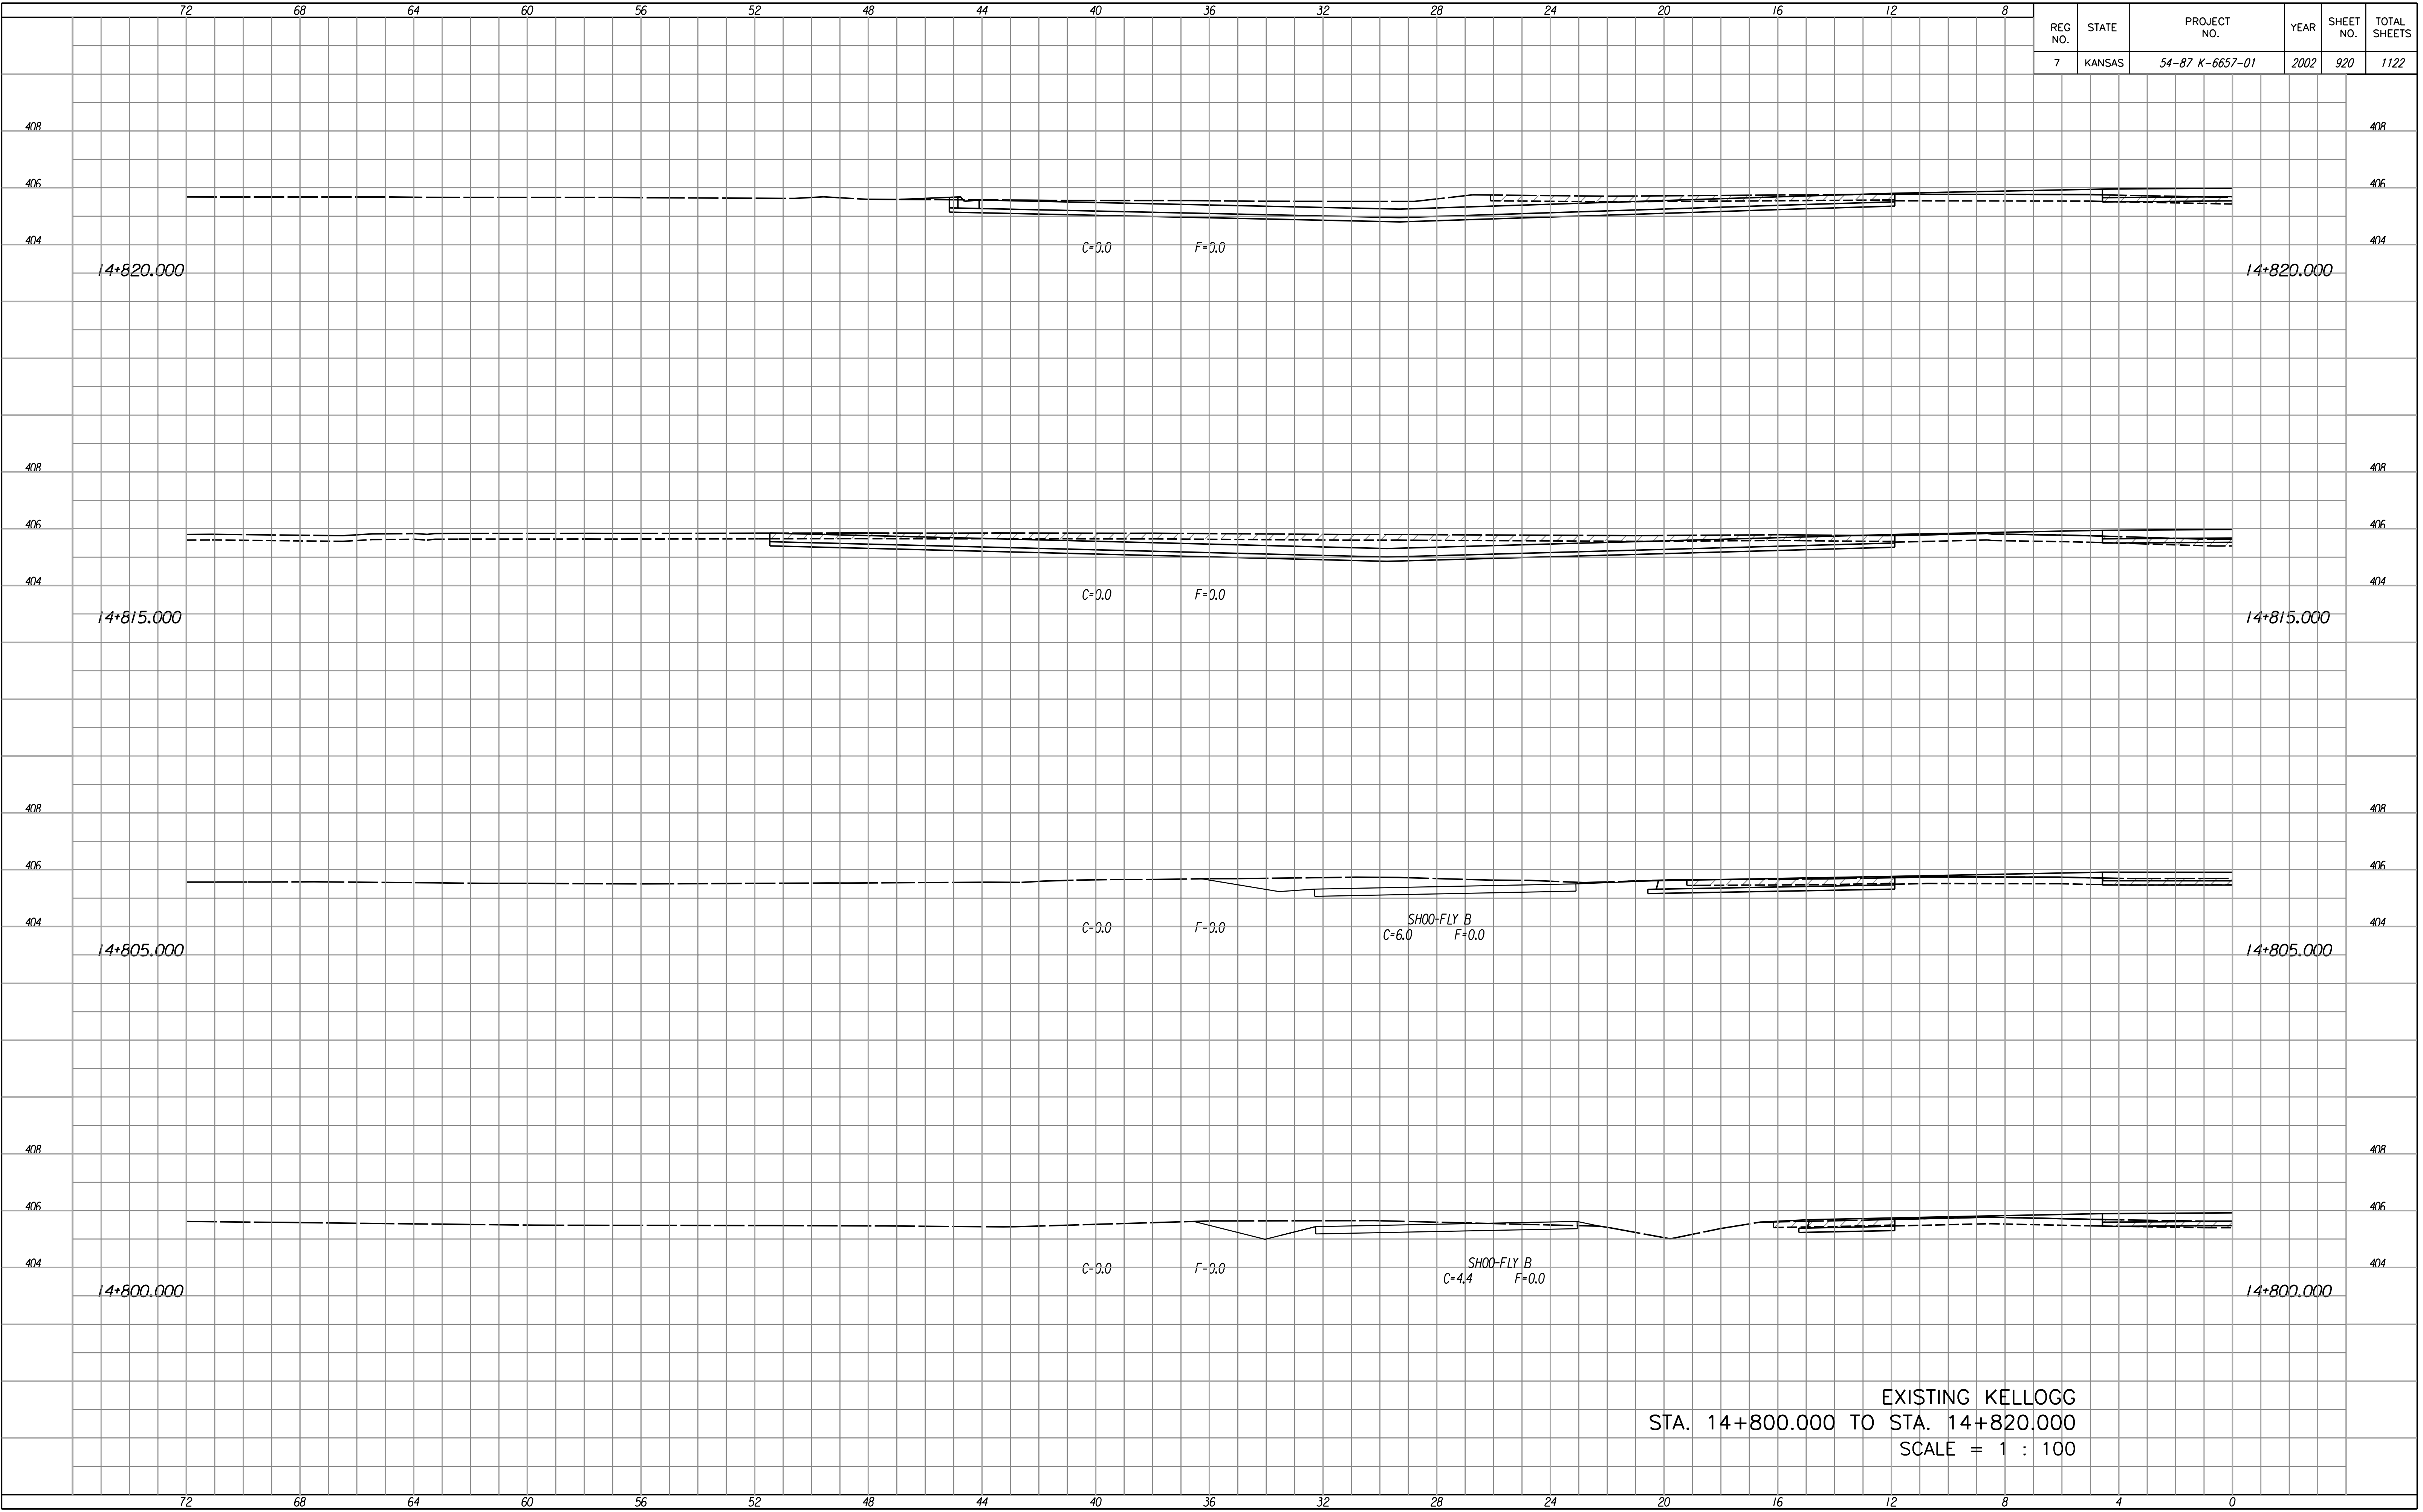

EXISTING KELLOGG
 STA. 14+800.000 TO STA. 14+820.000
 SCALE = 1 : 100