


REG. NO.	STATE	PROJECT NO.	YEAR	SHEET NO.	TOTAL SHEETS
7	KANSAS	54-87 K-6657-01	2002	921	1122

FINAL SURVEY NO.	DATE
SURVEYED	
PLOTTED	
TEMPLATE	
AREAS	
CHECKED	

Scale : 100
 Last Rev. : 10-12-07 By: gdr
 Design File : i:/1997/97362/As-Builts/agn/s/vol 5/Sh 0921-Mainline--xs14800R.dgn

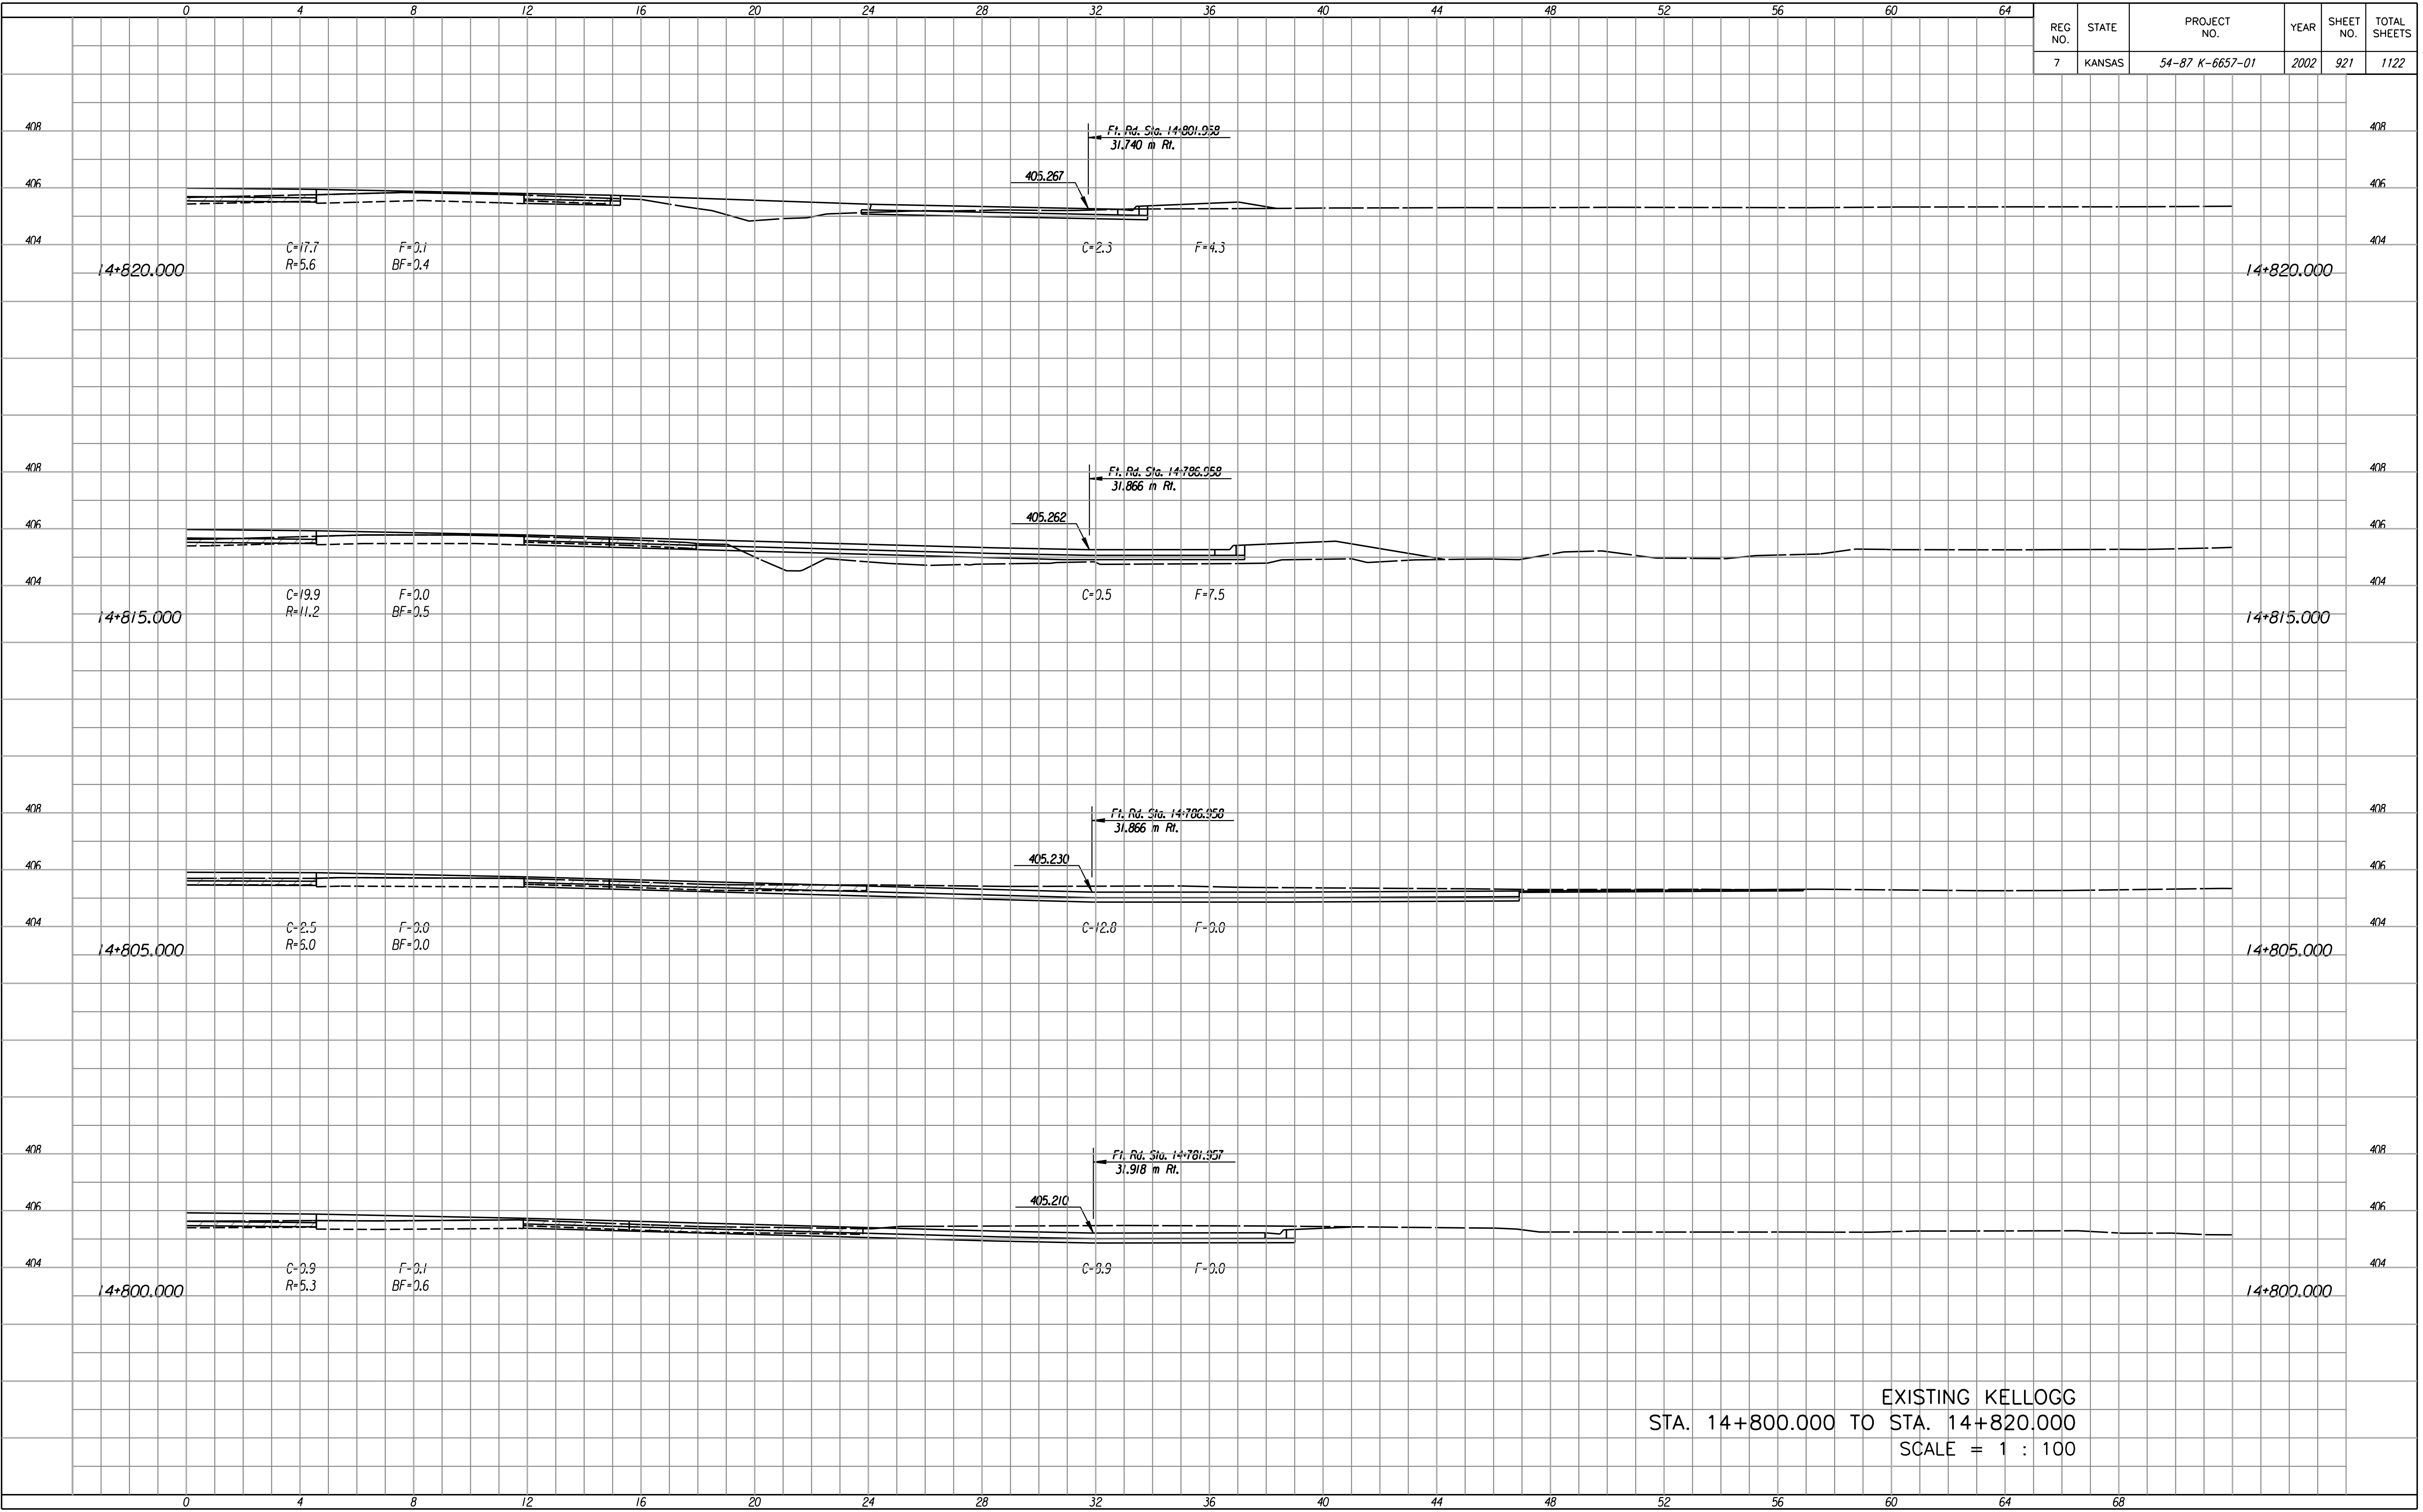

EXISTING KELLOGG
 STA. 14+800.000 TO STA. 14+820.000
 SCALE = 1 : 100