


| REG. NO. | STATE | PROJECT NO. | YEAR | SHEET NO. | TOTAL SHEETS |
|----------|--------|-----------------|------|-----------|--------------|
| 7 | KANSAS | 54-87 K-6657-01 | 2002 | 933 | 1122 |

| FINAL SURVEY NO. | SURVEYED BY | DATE |
|------------------|-------------|------|
| | | |

Last Rev : 10-12-07 By: gdr
 Scale : 100
 Design File : I:\1997\97362\As-Built\ dgn\Vol 5\Sh 0933-Mainline-ss15100Rt.dgn

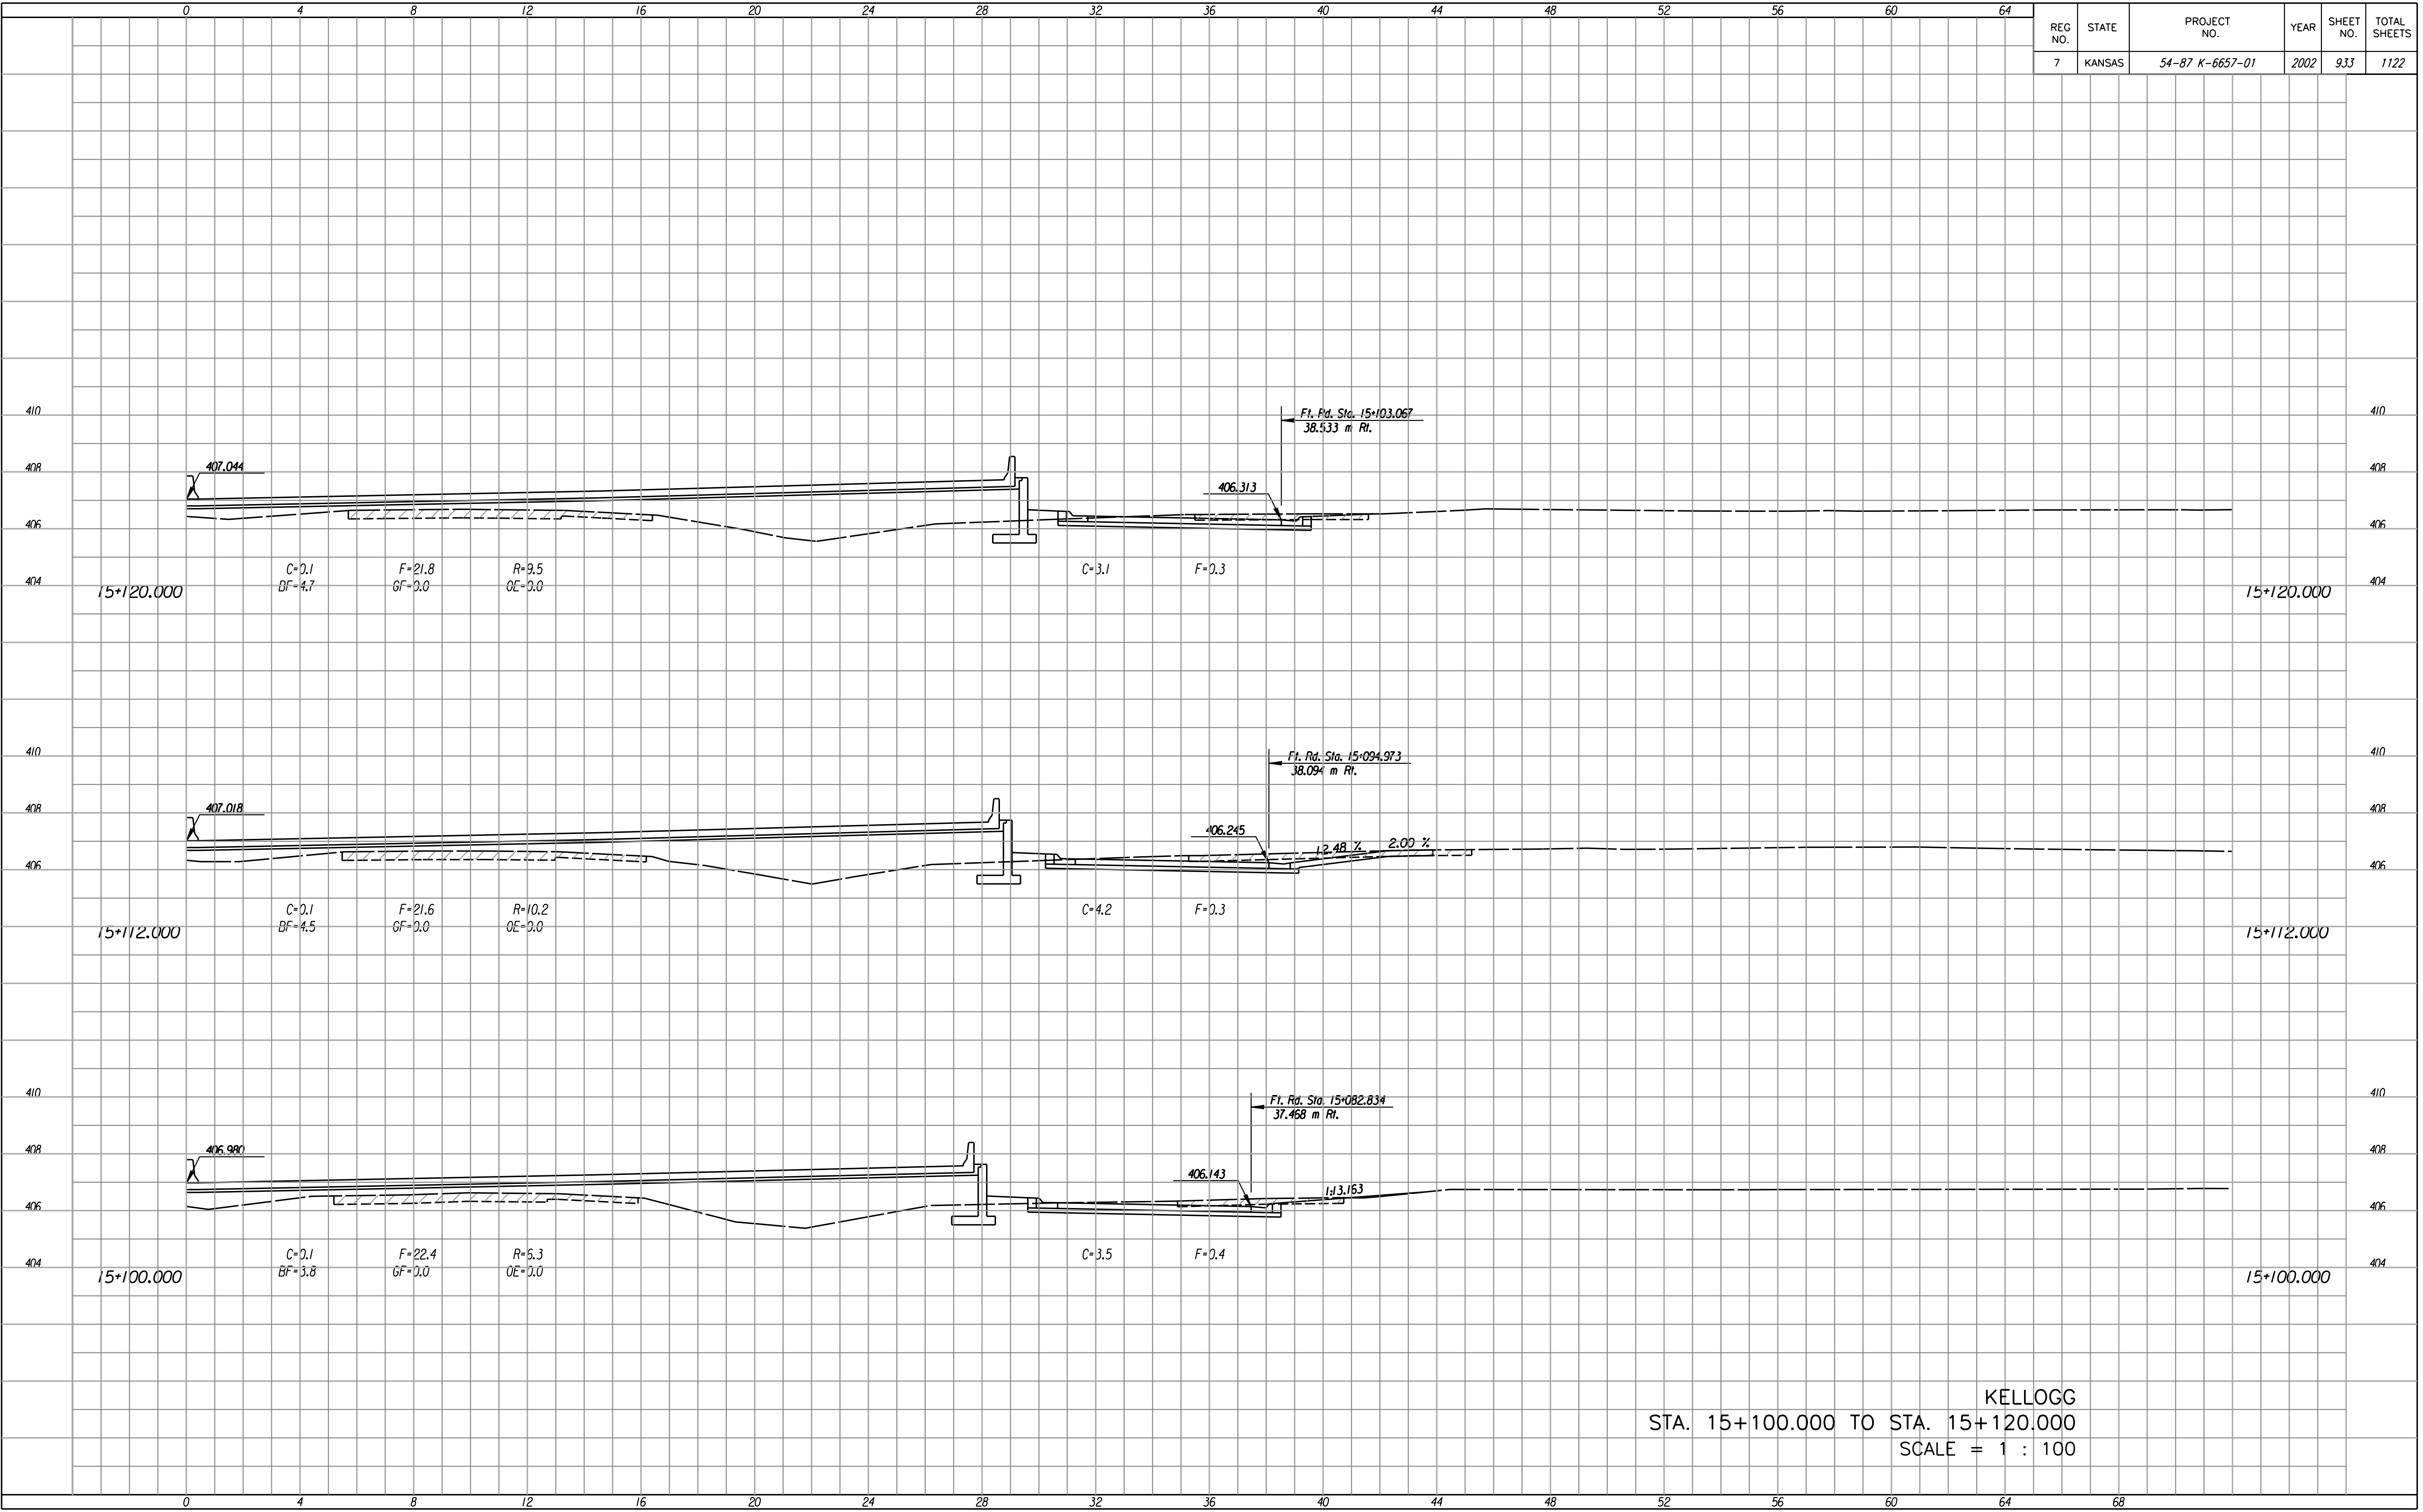

KELLOGG
 STA. 15+100.000 TO STA. 15+120.000
 SCALE = 1 : 100