


REG. NO.	STATE	PROJECT NO.	YEAR	SHEET NO.	TOTAL SHEETS
7	KANSAS	54-87 K-6657-01	2002	937	1122

FINAL SURVEY NO.	SURVEYED BY	DATE	PLOTTED BY	DATE	TEMPLATE AREAS CHECKED

Last Rev : 10-12-07 By: gdr
 Scale : 100
 Design File : I:\1997\97362\As-Built\As-Built.dgn 5/5/97 0937-Mainline-ss1518001.dgn

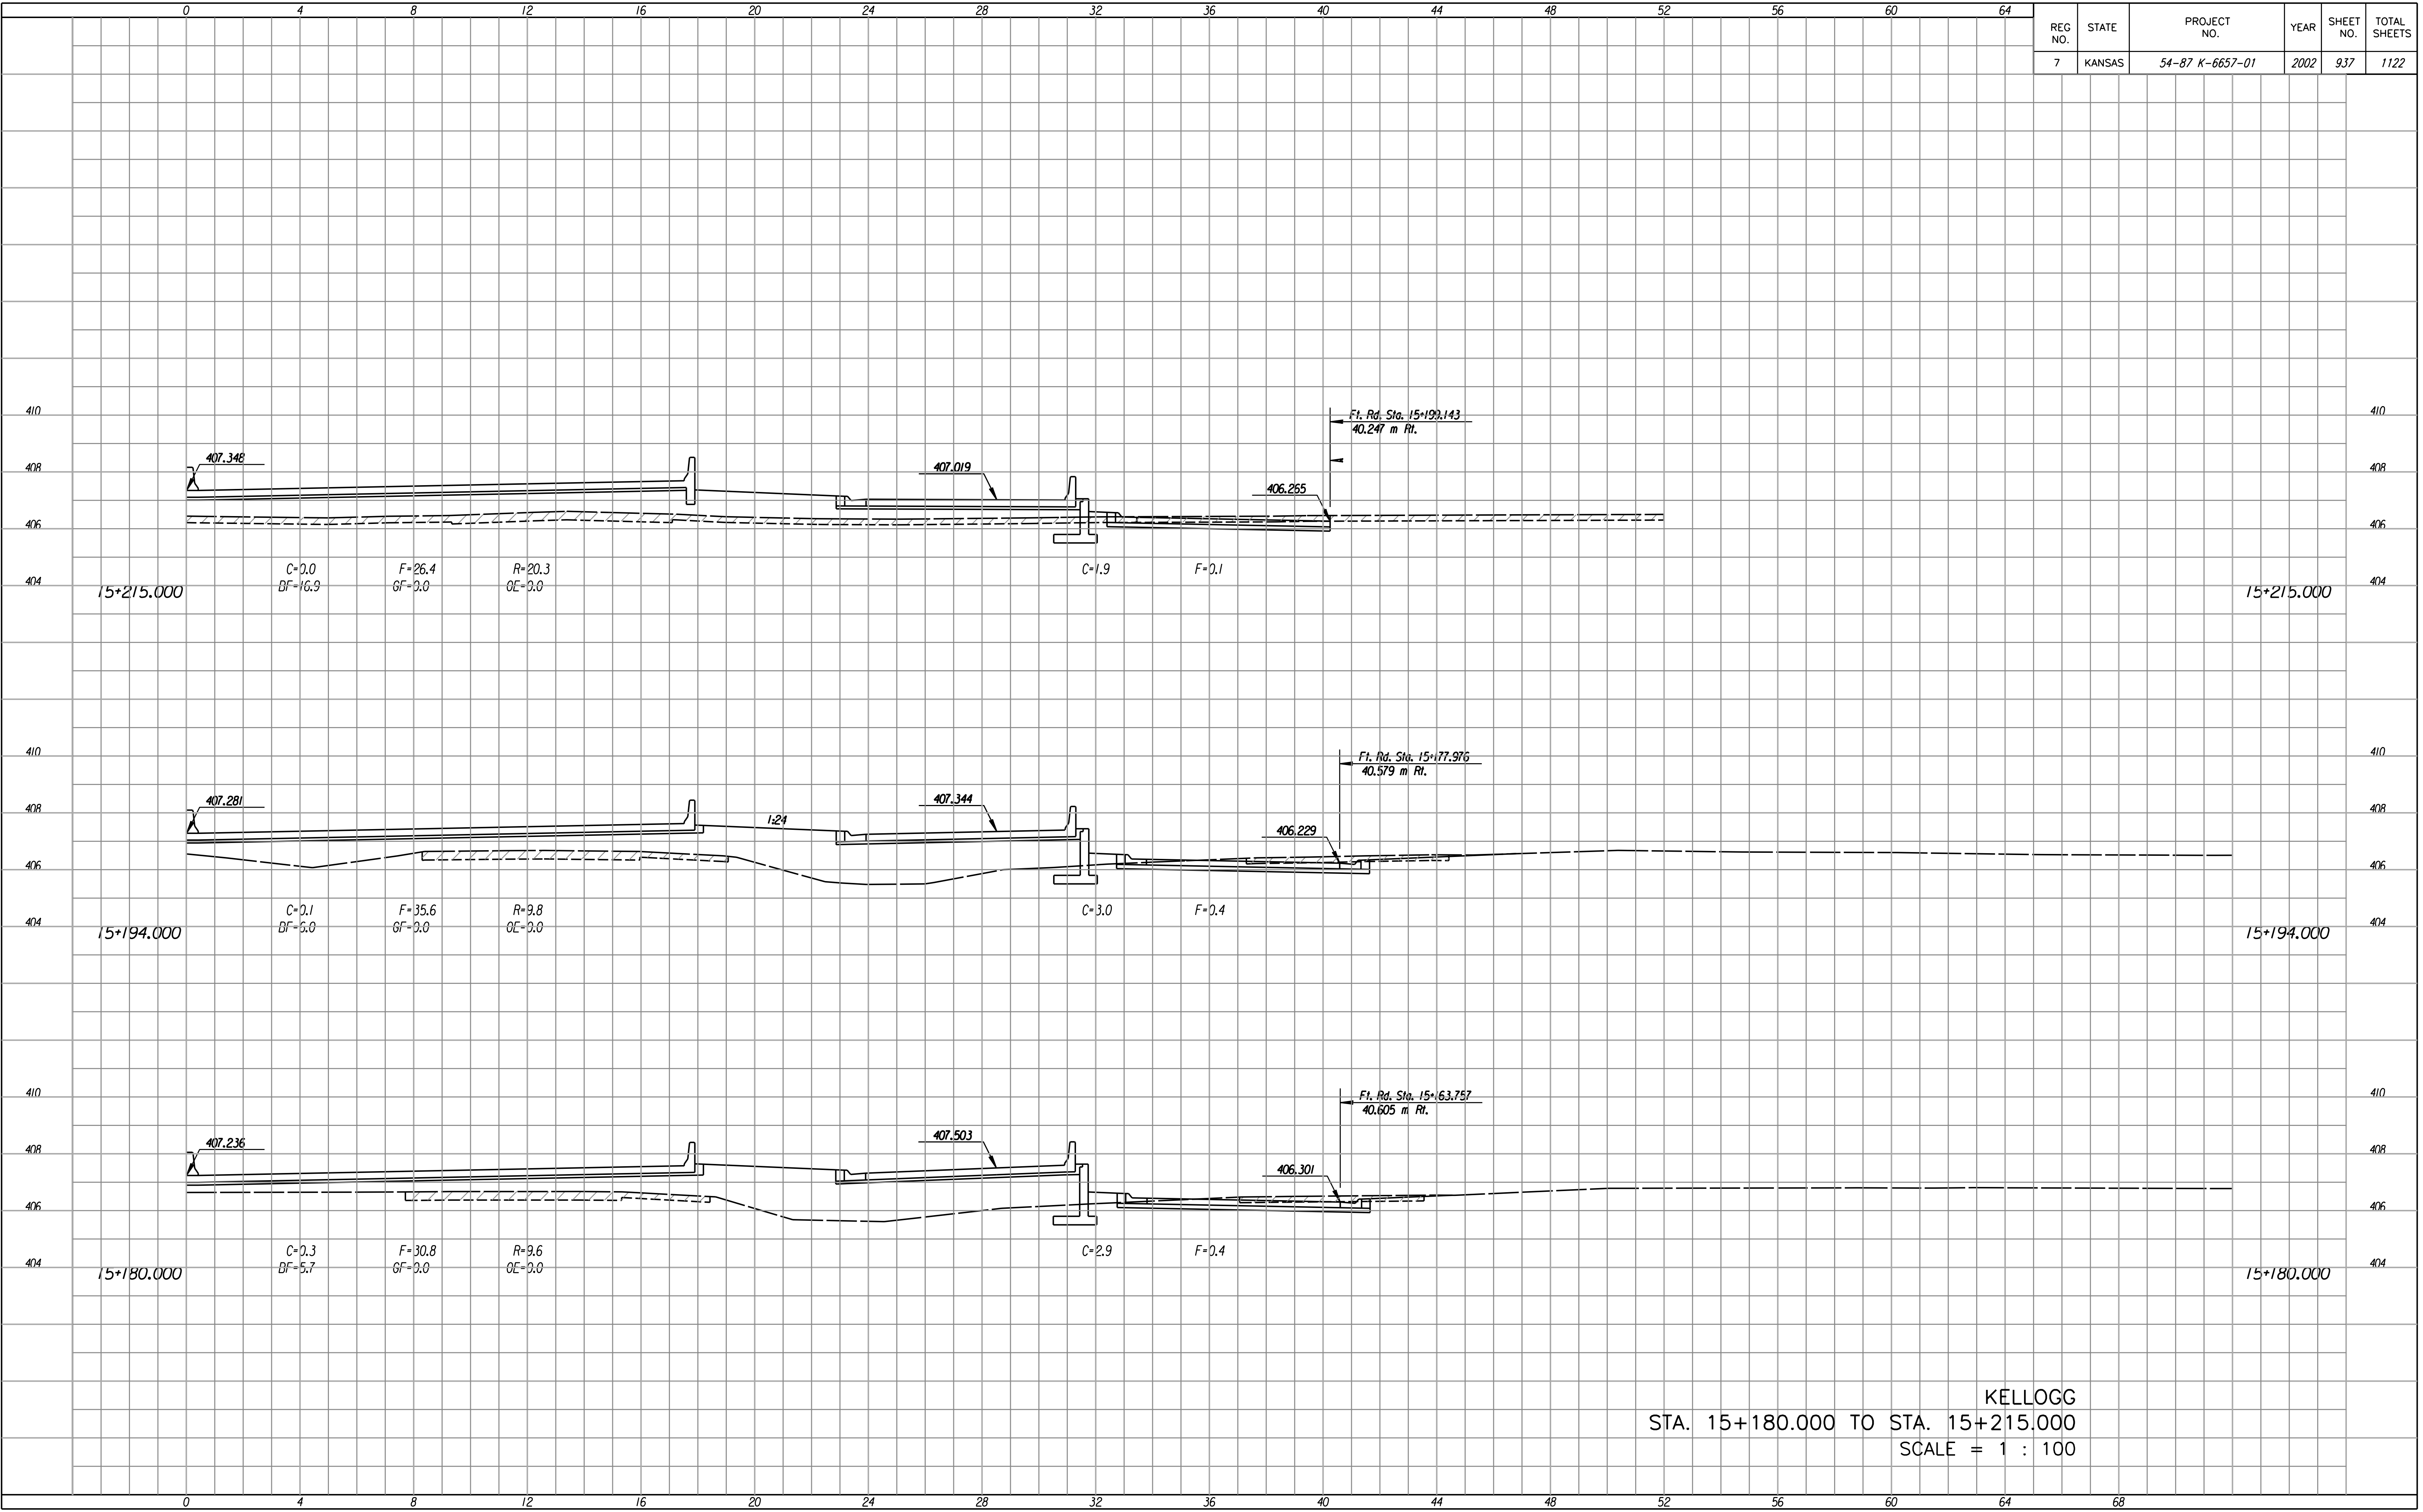

KELLOGG
 STA. 15+180.000 TO STA. 15+215.000
 SCALE = 1 : 100