


REG NO.	STATE	PROJECT NO.	YEAR	SHEET NO.	TOTAL SHEETS
7	KANSAS	54-87 K-6657-01	2002	951	1122

FINAL SURVEY NO.	BY	DATE

Last Rev : 10-12-07 By: gdr  
 Scale : 100  
 Design File : I:\1997\97362\As-Built\As-Built.dgn 5/5/05 0951-Mainline-x315667Pl.dgn

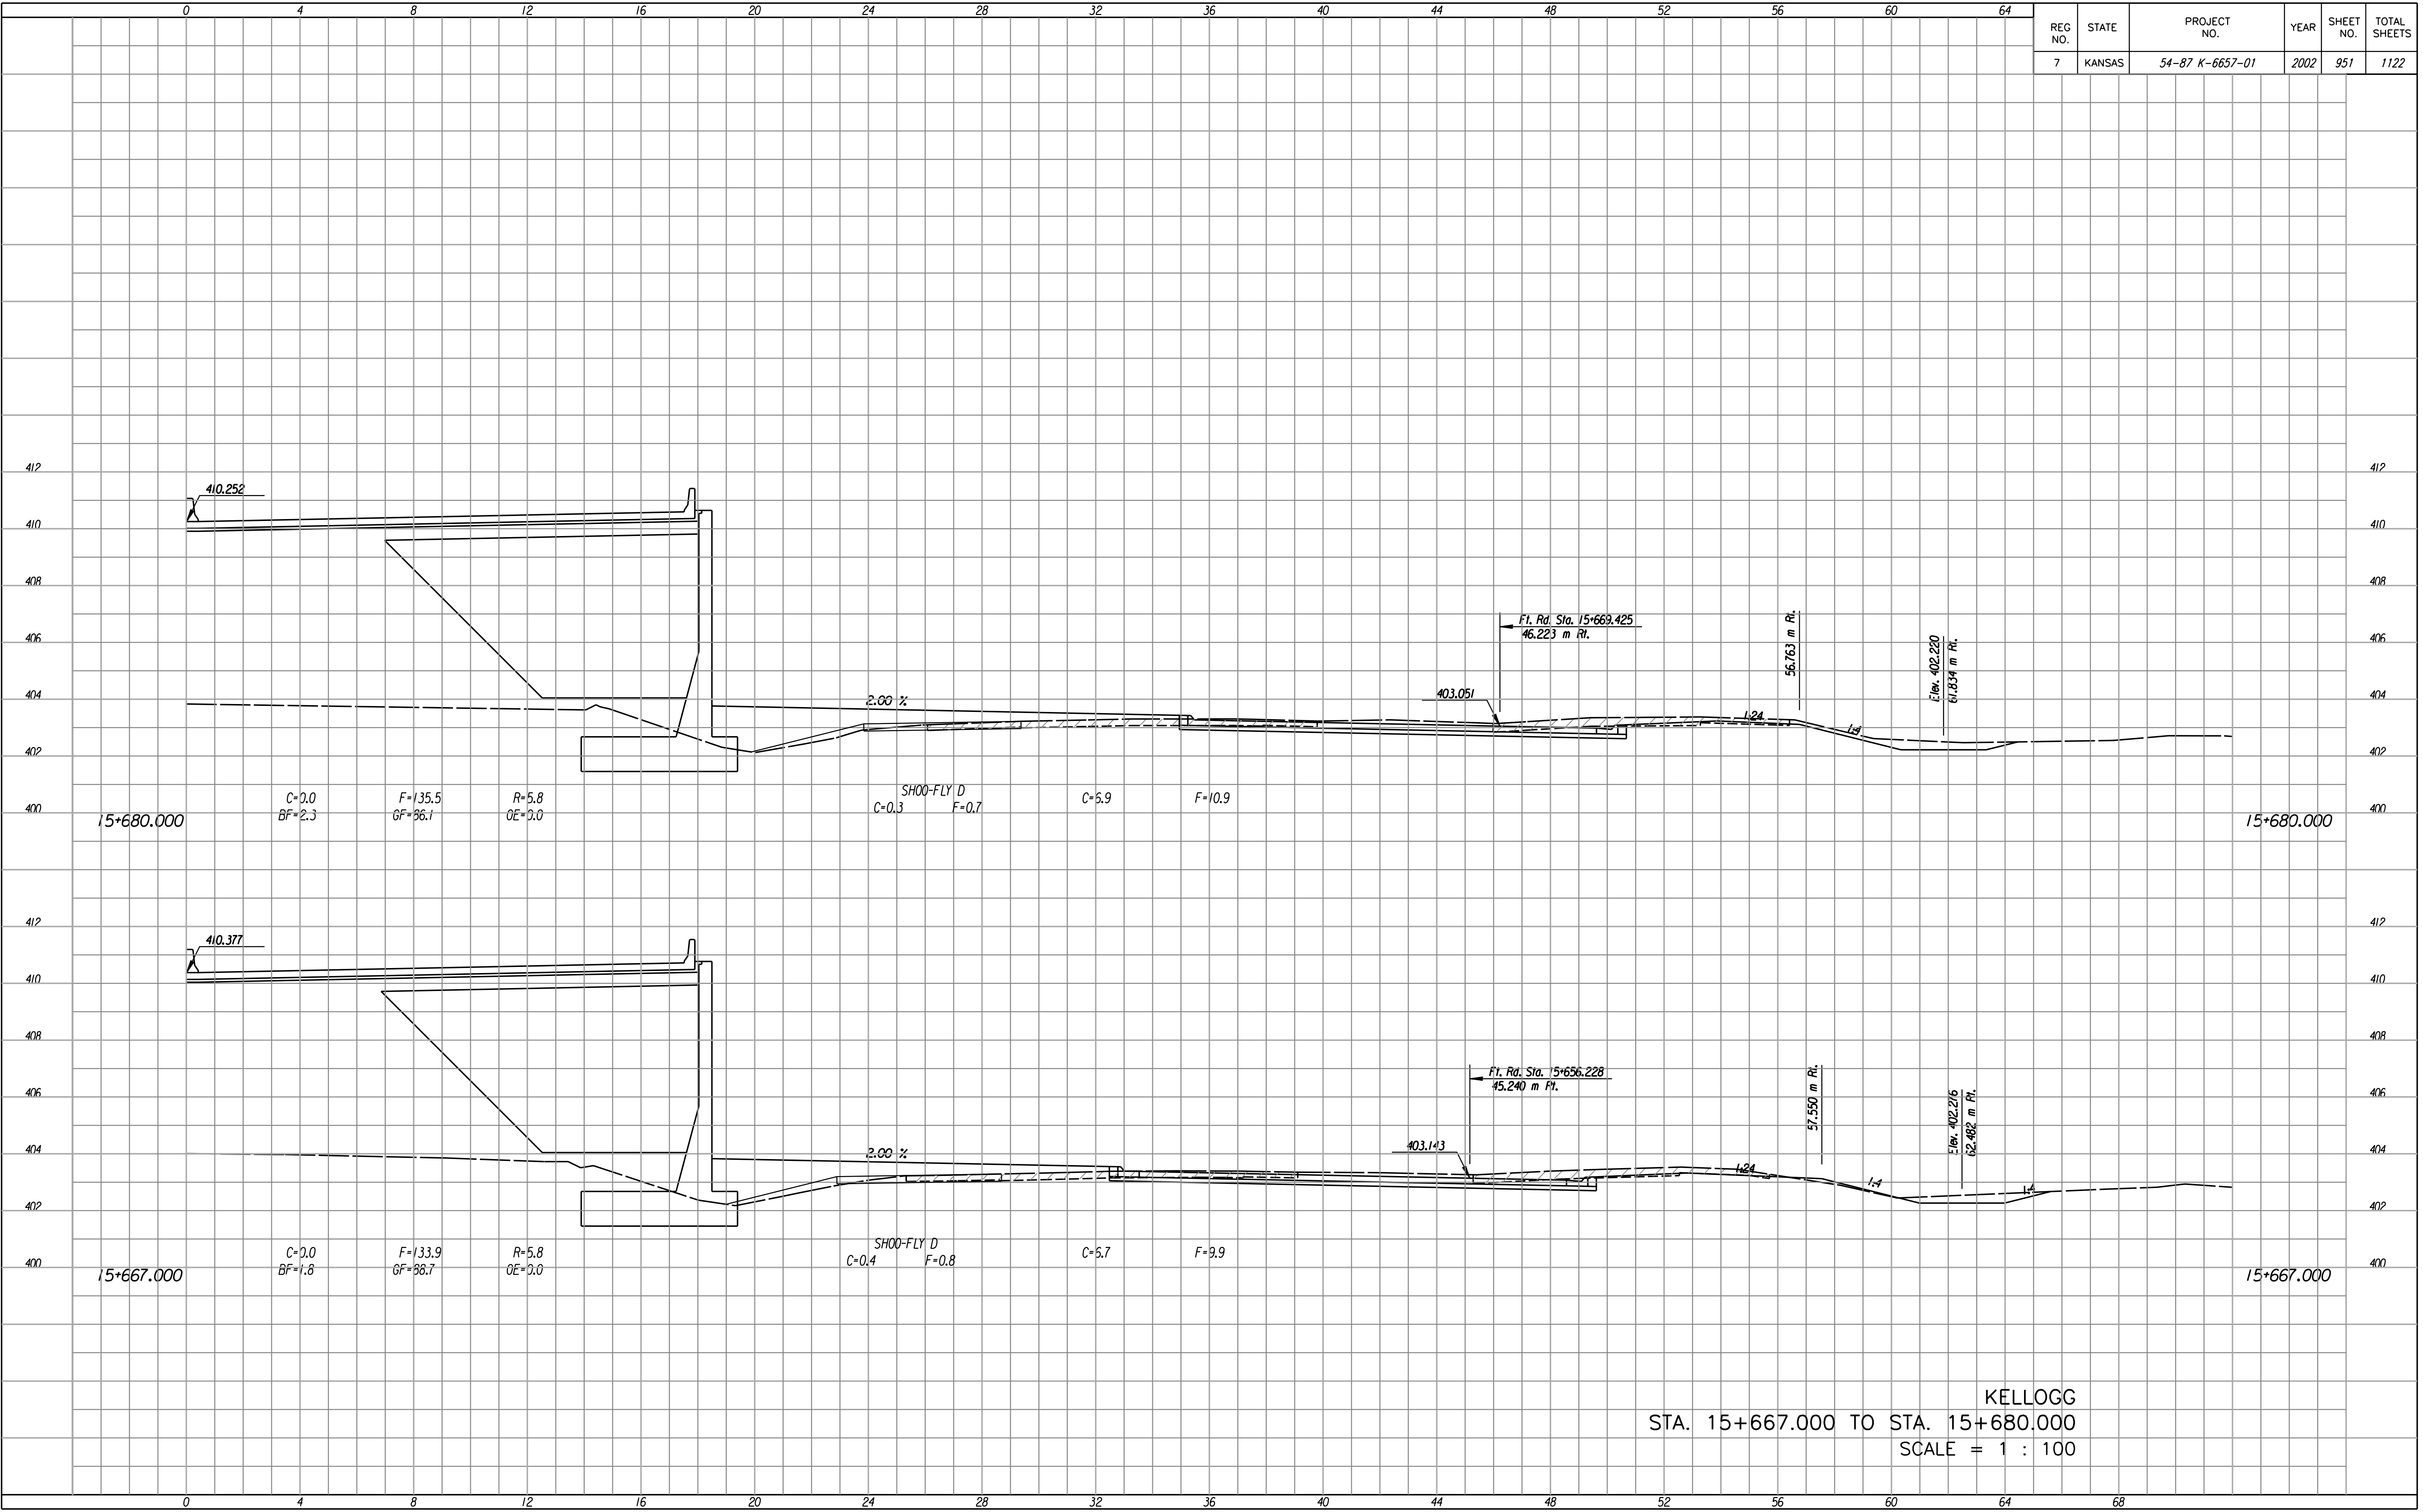

KELLOGG  
 STA. 15+667.000 TO STA. 15+680.000  
 SCALE = 1 : 100