


REG. NO.	STATE	PROJECT NO.	YEAR	SHEET NO.	TOTAL SHEETS
7	KANSAS	54-87 K-6657-01	2002	968	1122

FINAL SURVEY NO.	BY	DATE
SURVEYED		
PLOTTED		
TEMPLATE		
AREAS		
CHECKED		

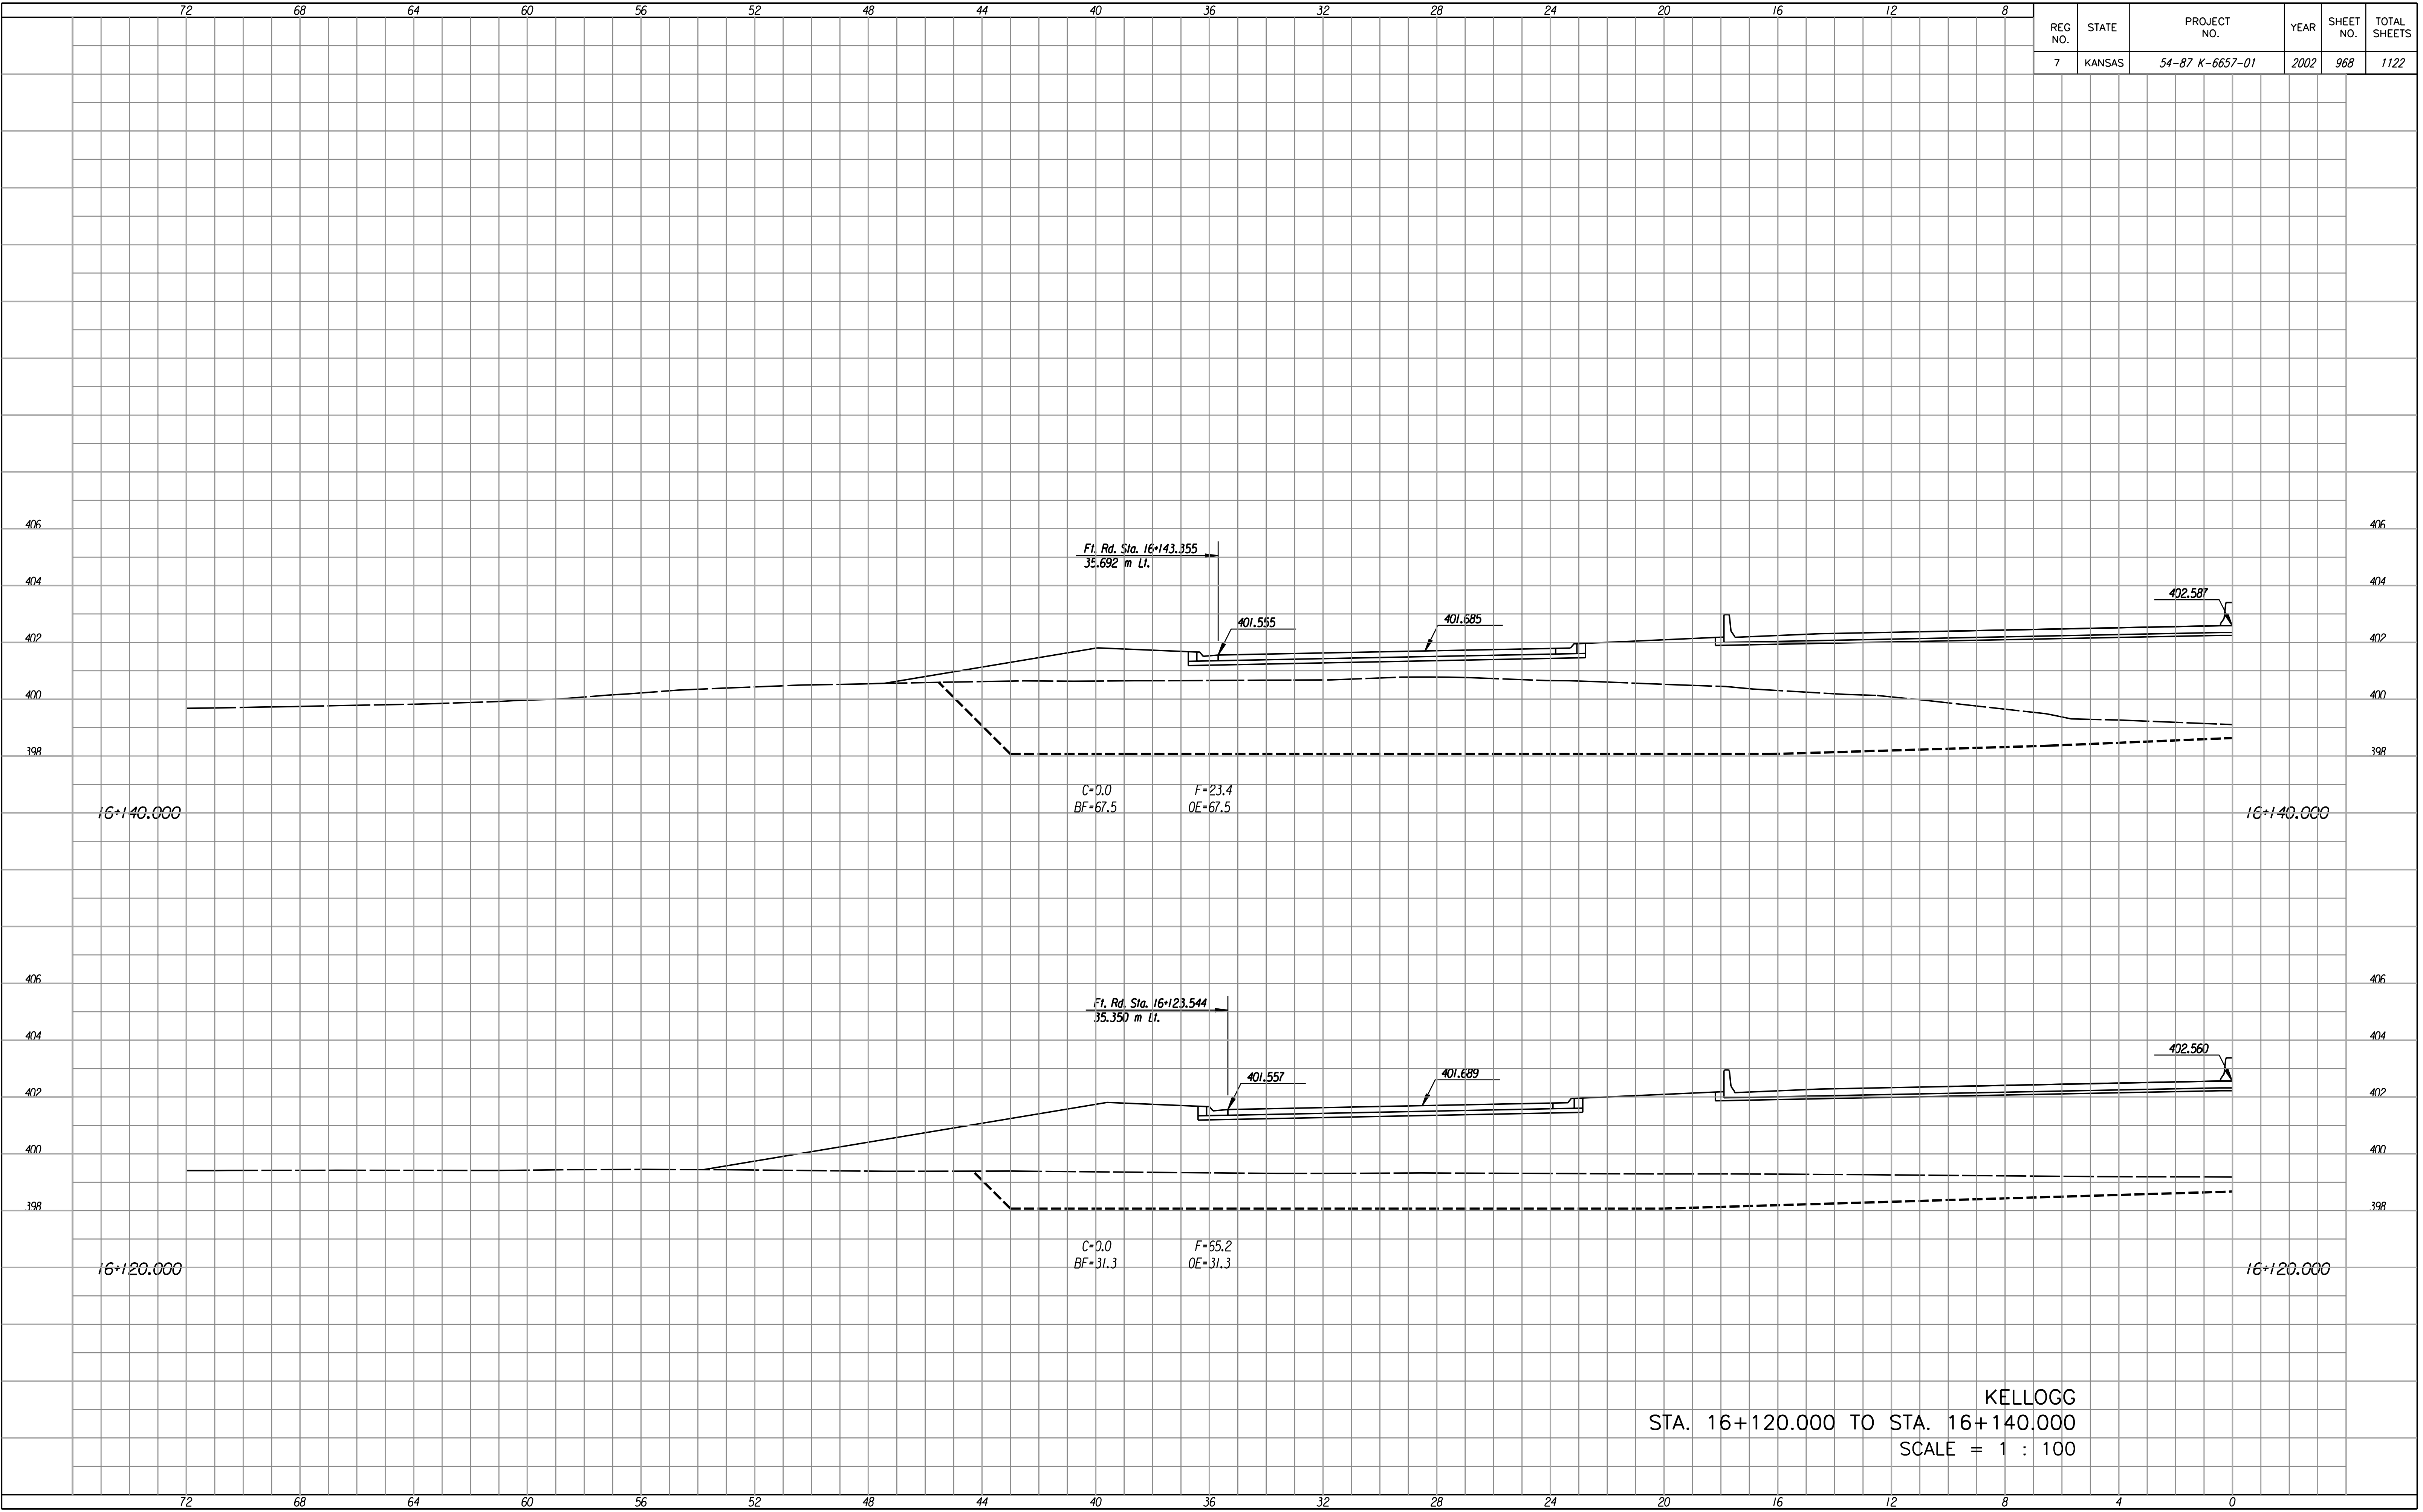

KELLOGG  
 STA. 16+120.000 TO STA. 16+140.000  
 SCALE = 1 : 100

Last Rev. : 10-12-07 By: gdr  
 Scale : 100  
 Design File : i:/1997/97162/As-Builts/dgn's/Vol 5/Sh 0968-Mainline-rs161201.dgn