


REG NO.	STATE	PROJECT NO.	YEAR	SHEET NO.	TOTAL SHEETS
7	KANSAS	54-87 K-6657-01	2002	971	1122

FINAL SURVEY NO.	DATE
SURVEYED	
PLOTTED	
TEMPLATE AREAS CHECKED	
NOTE BOOK NO.	
BY	

Last Rev. : 10-12-07 By: gdr
 Scale : 100
 Design File : i:/1997/97162/As-Builts/dgn/s/Vol 5/Sh 0971-Mainline-rs161800r1.dgn

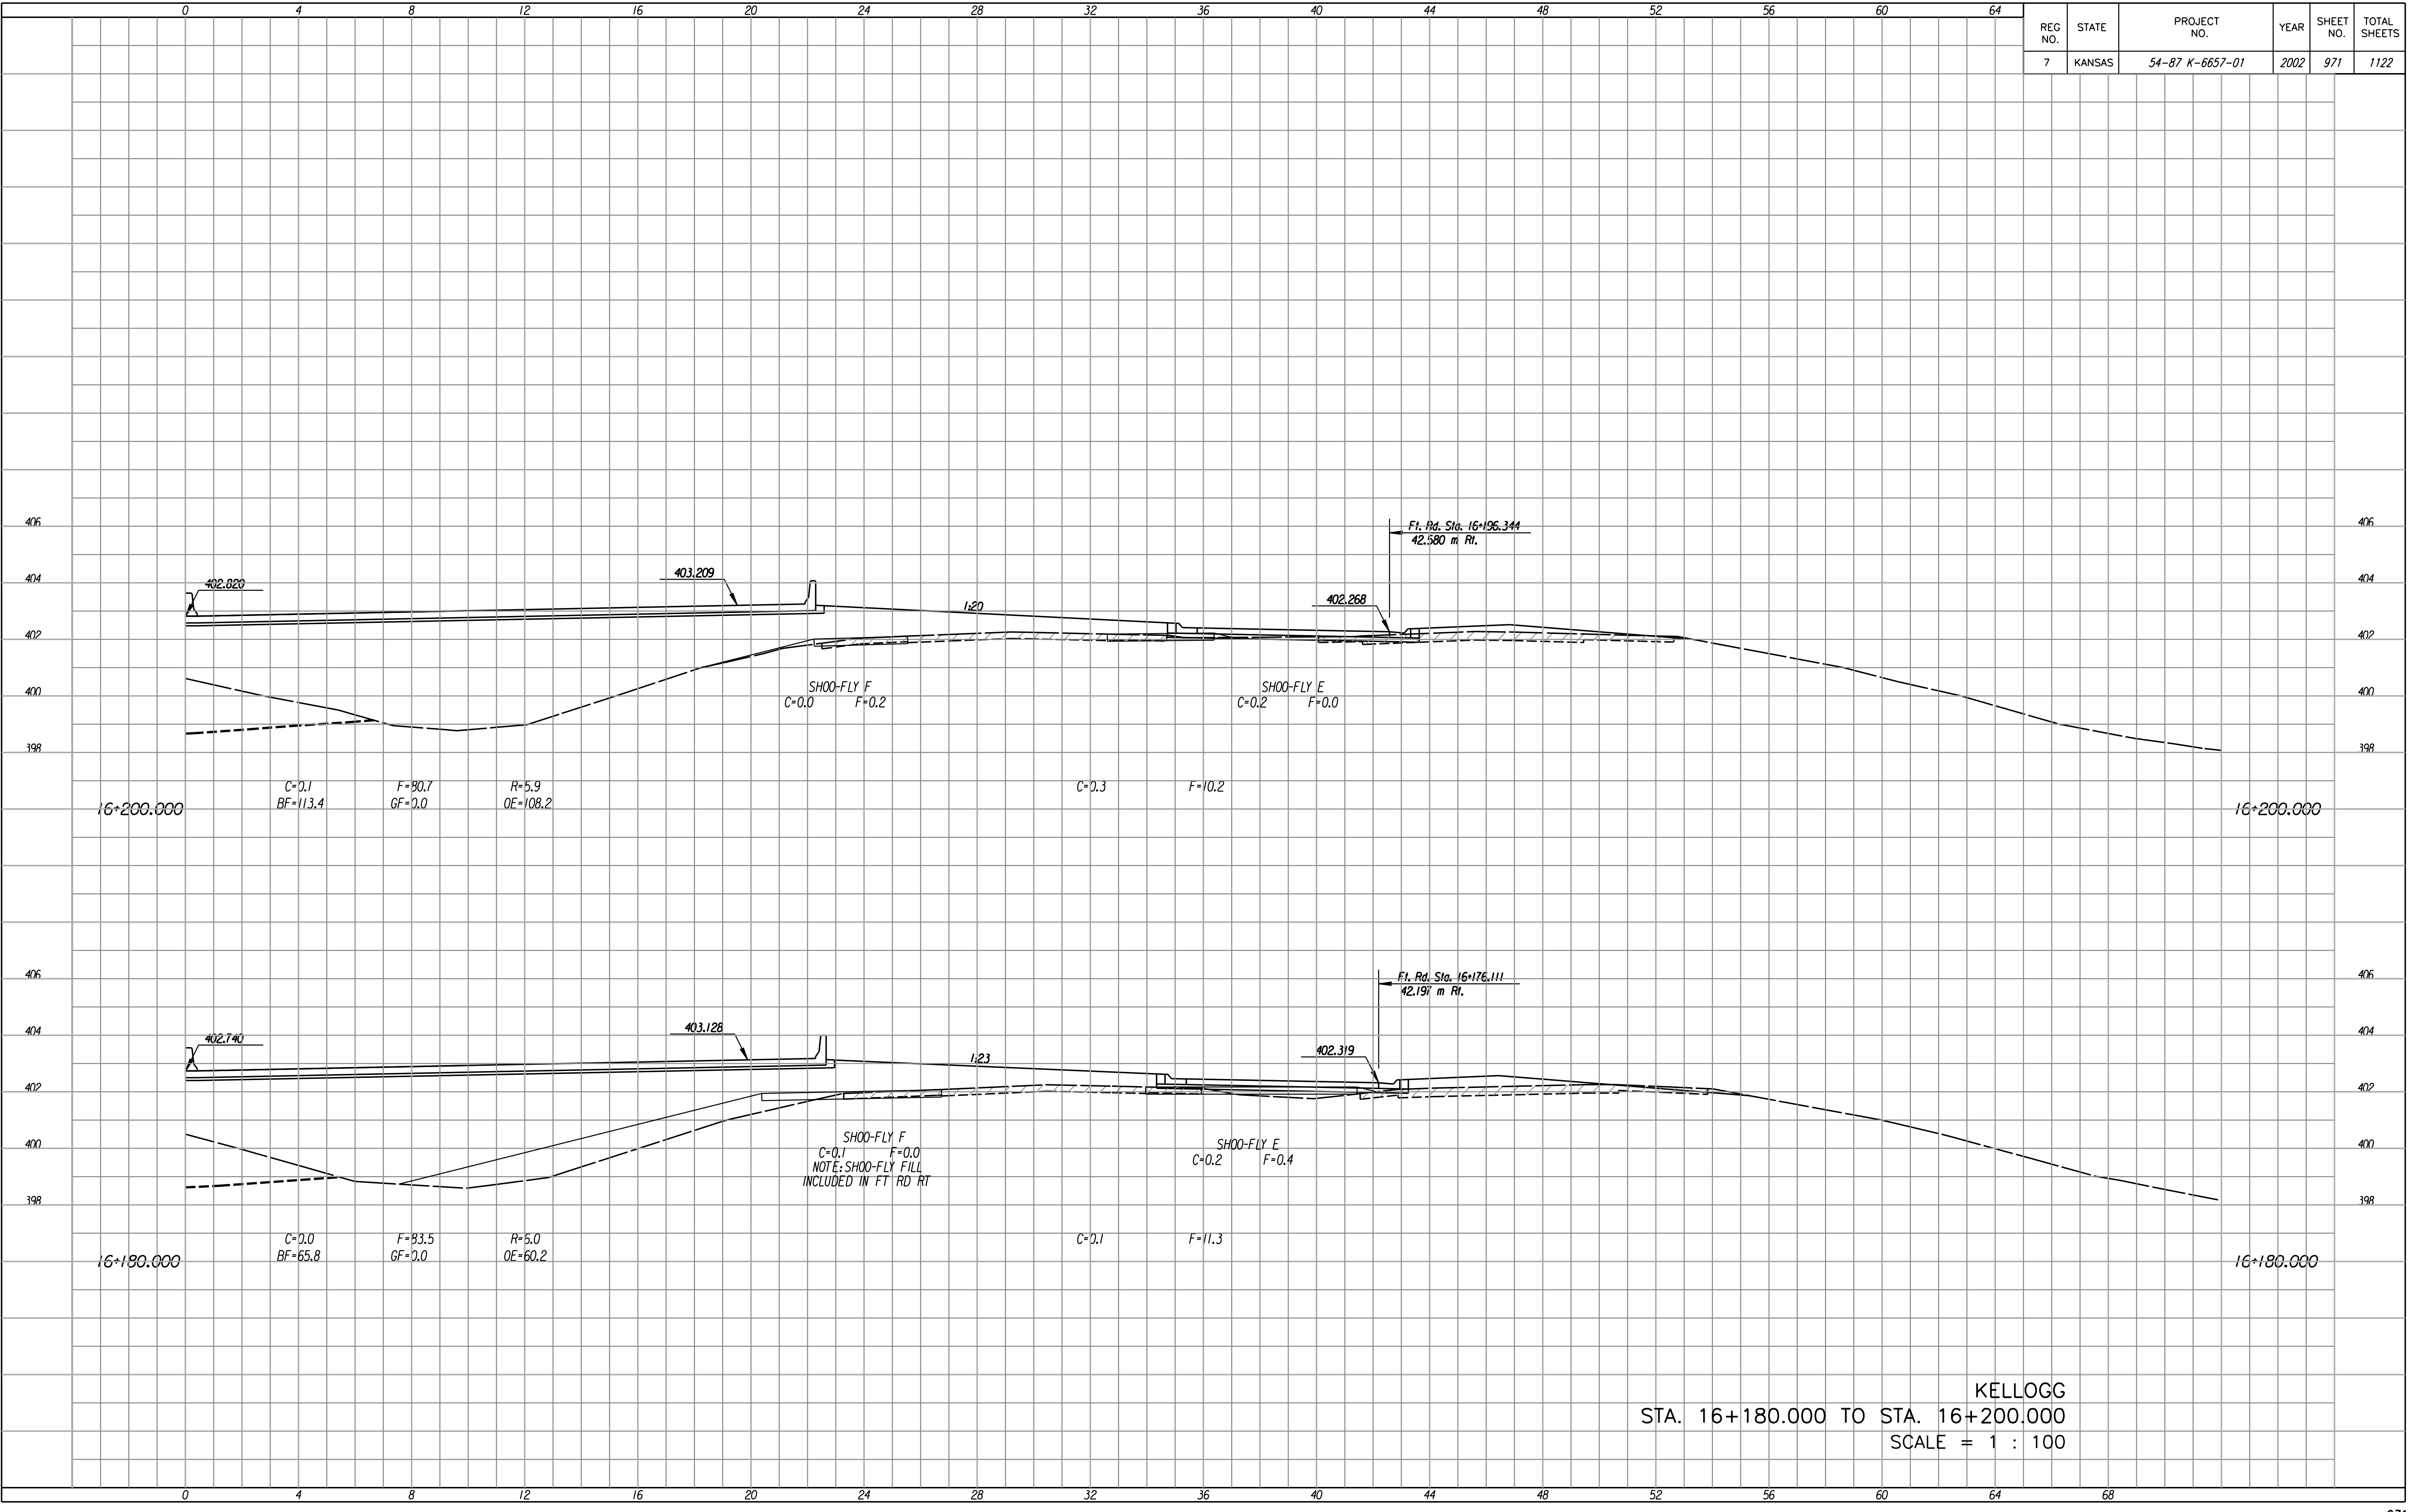

KELLOGG
 STA. 16+180.000 TO STA. 16+200.000
 SCALE = 1 : 100