


REG. NO.	STATE	PROJECT NO.	YEAR	SHEET NO.	TOTAL SHEETS
7	KANSAS	54-87 K-6657-01	2002	972	1122

FINAL SURVEY NO.	BY	DATE

Last Rev. : 10-12-07 By: gdr  
 Scale : 100  
 Design File : i:/1997/97162/As-Builts/dgn/s/1012-Mainline-ss162201.dgn

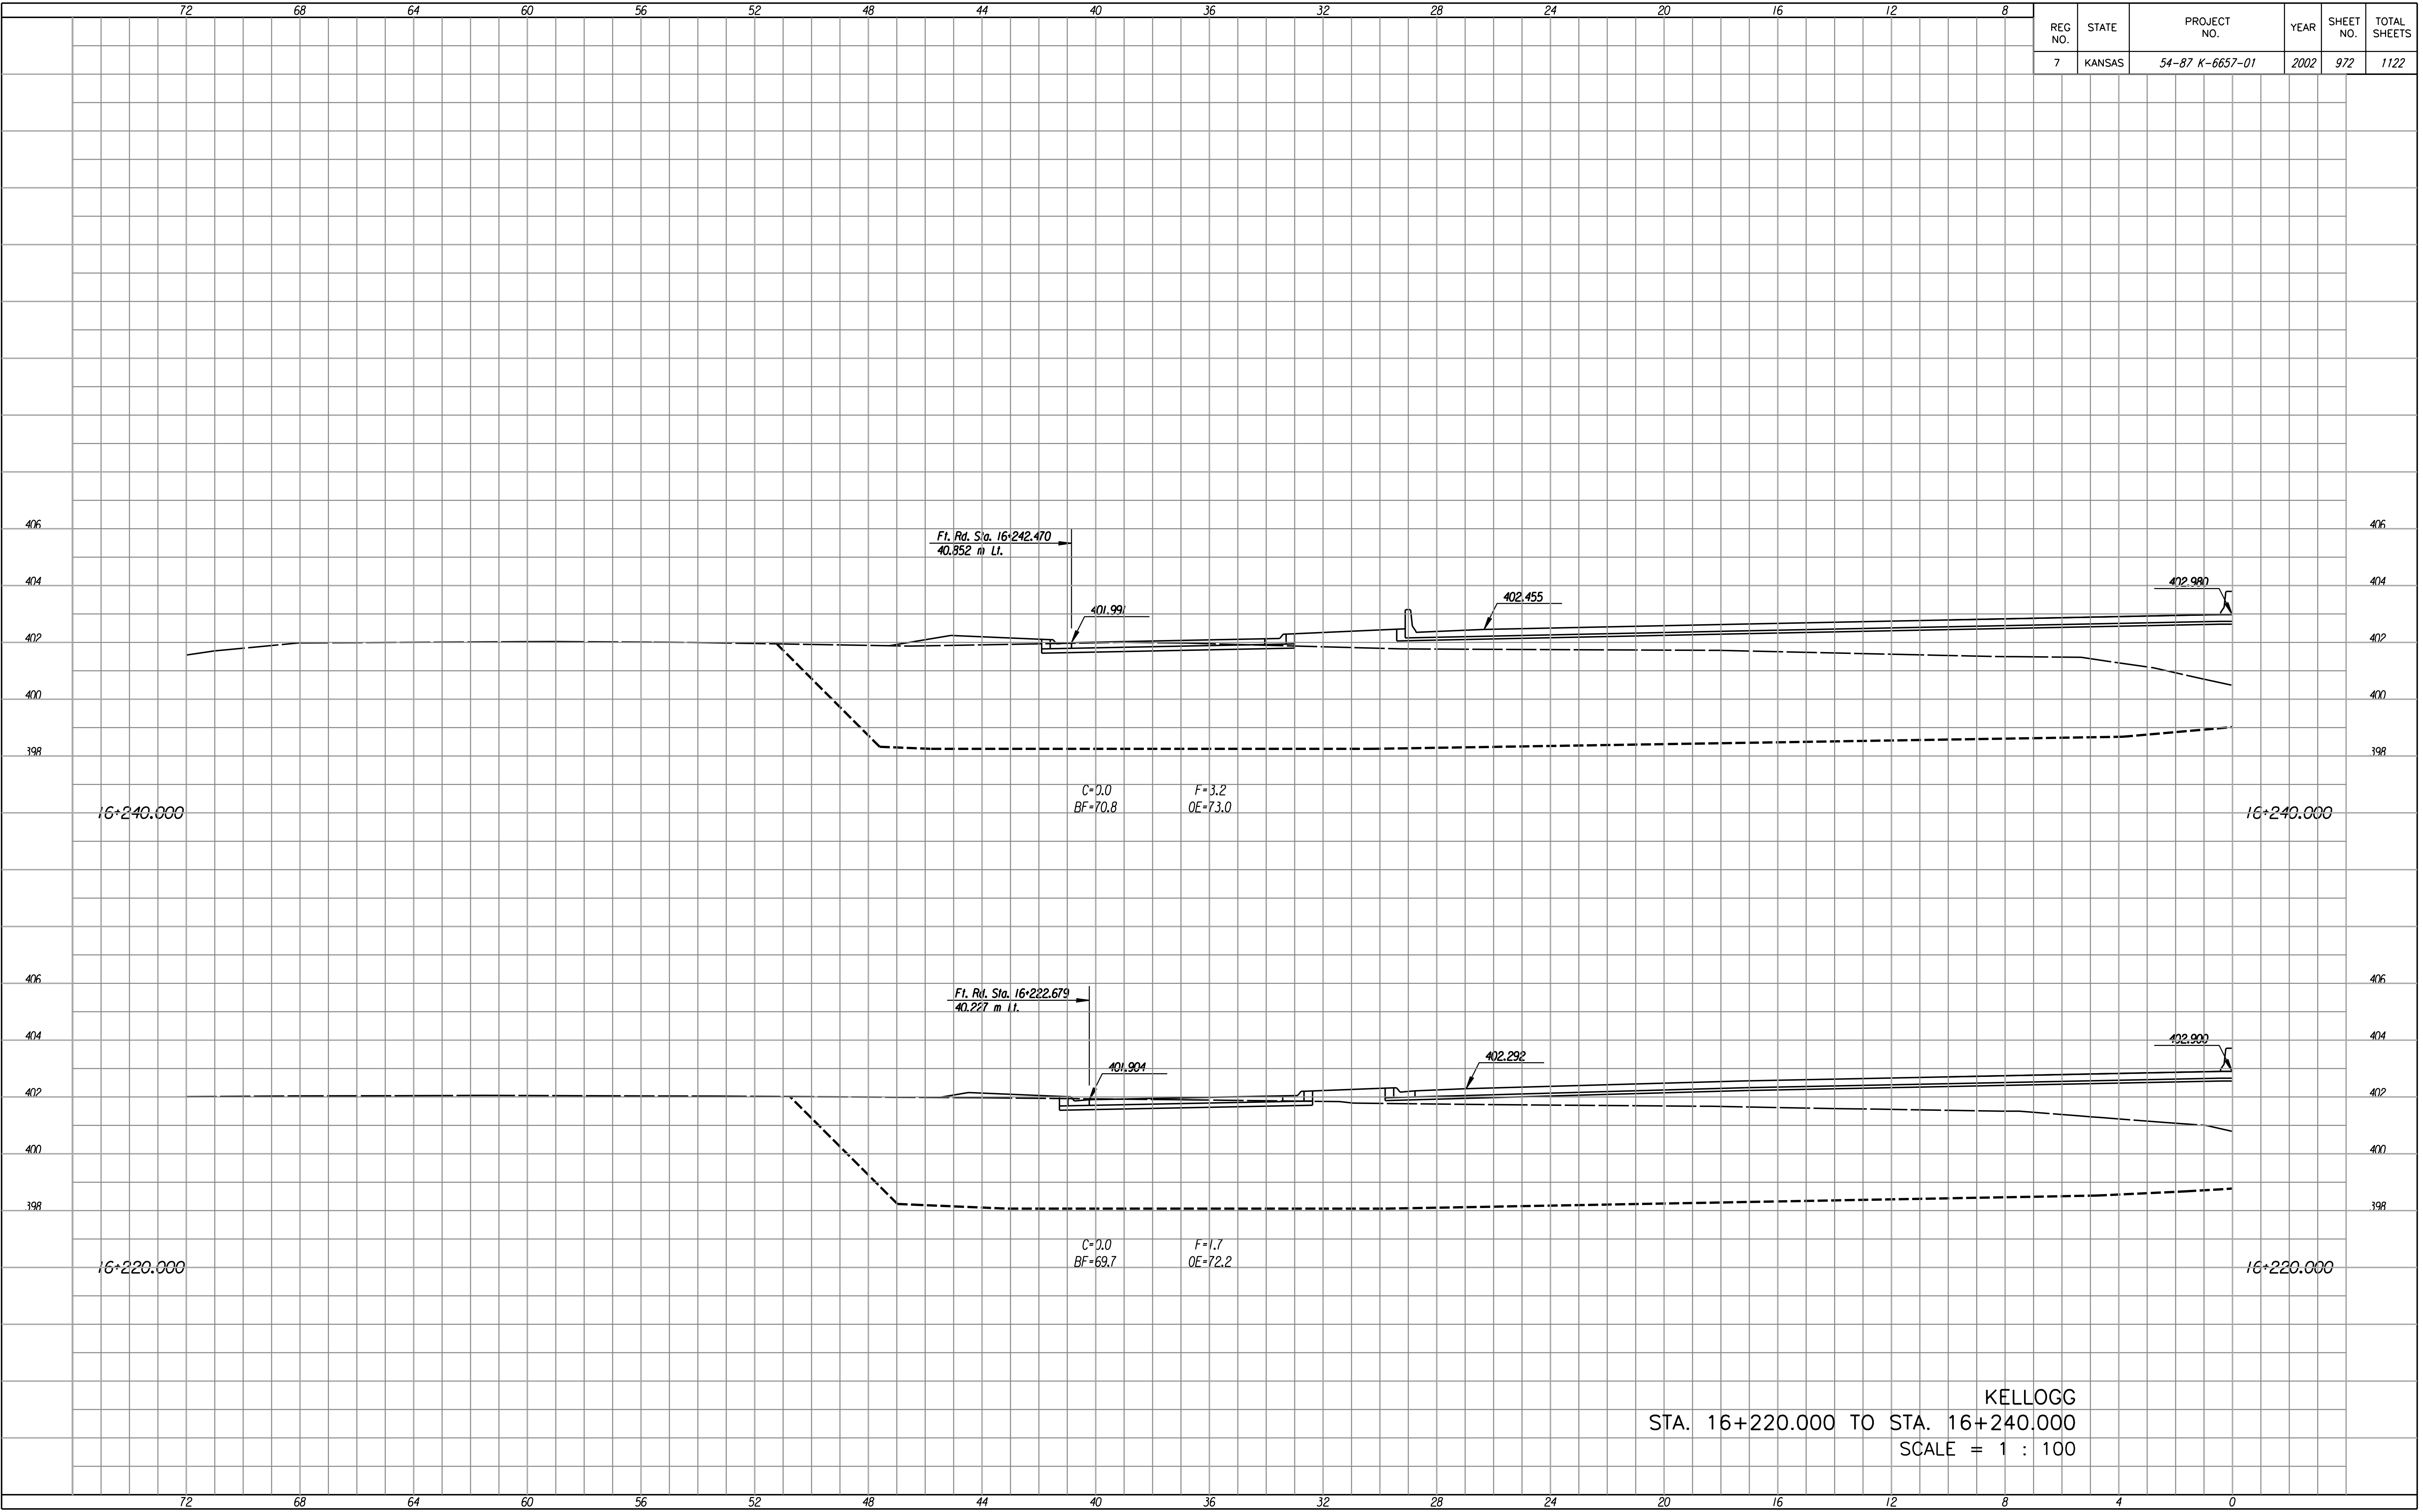

KELLOGG  
 STA. 16+220.000 TO STA. 16+240.000  
 SCALE = 1 : 100