


REG. NO.	STATE	PROJECT NO.	YEAR	SHEET NO.	TOTAL SHEETS
7	KANSAS	54-87 K-6657-01	2002	975	1122

FINAL SURVEY NO.	SURVEYED BY	DATE
NOTE BOOK NO.	PLOTTED BY	
	TEMPLATE AREAS CHECKED	

Last Rev. : 10-12-07 By: gdr
 Scale : 100
 Design File : i:\1997\97162\As-Builts\ dgn\Vol 5\Sh 0975-Mainline-rs1626001.dgn

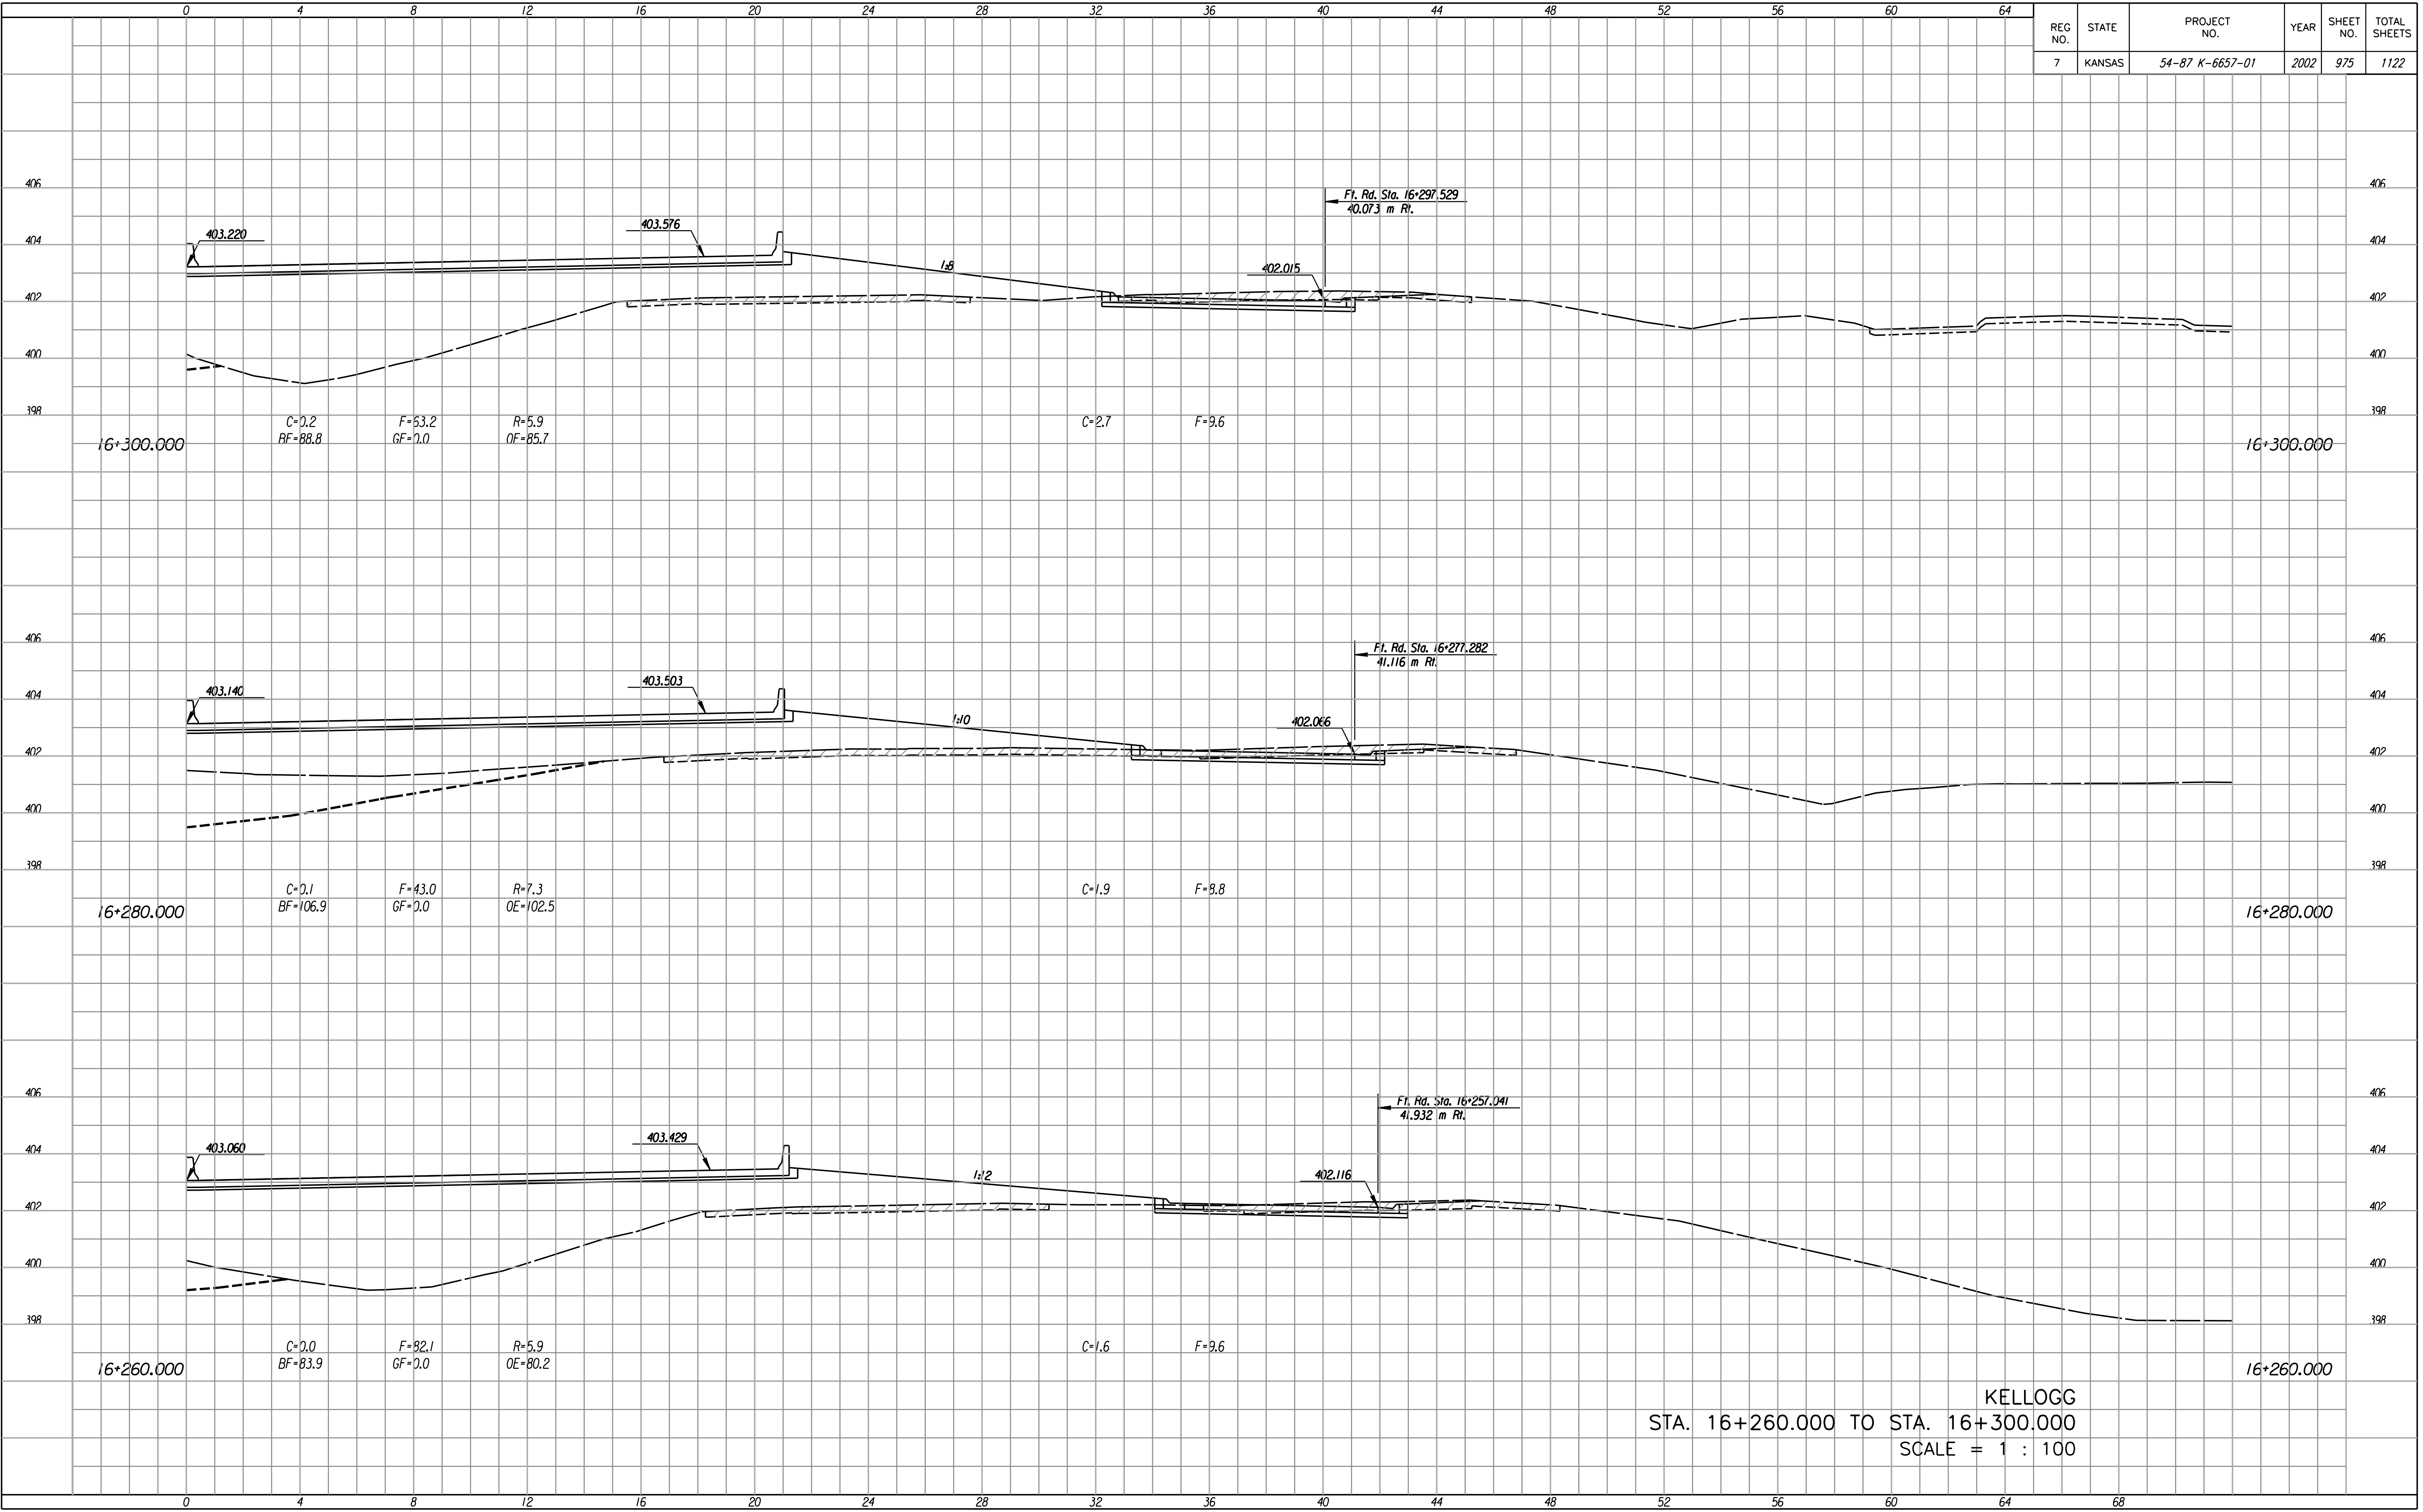

KELLOGG
 STA. 16+260.000 TO STA. 16+300.000
 SCALE = 1 : 100