


REG. NO.	STATE	PROJECT NO.	YEAR	SHEET NO.	TOTAL SHEETS
7	KANSAS	54-87 K-6657-01	2002	976	1122

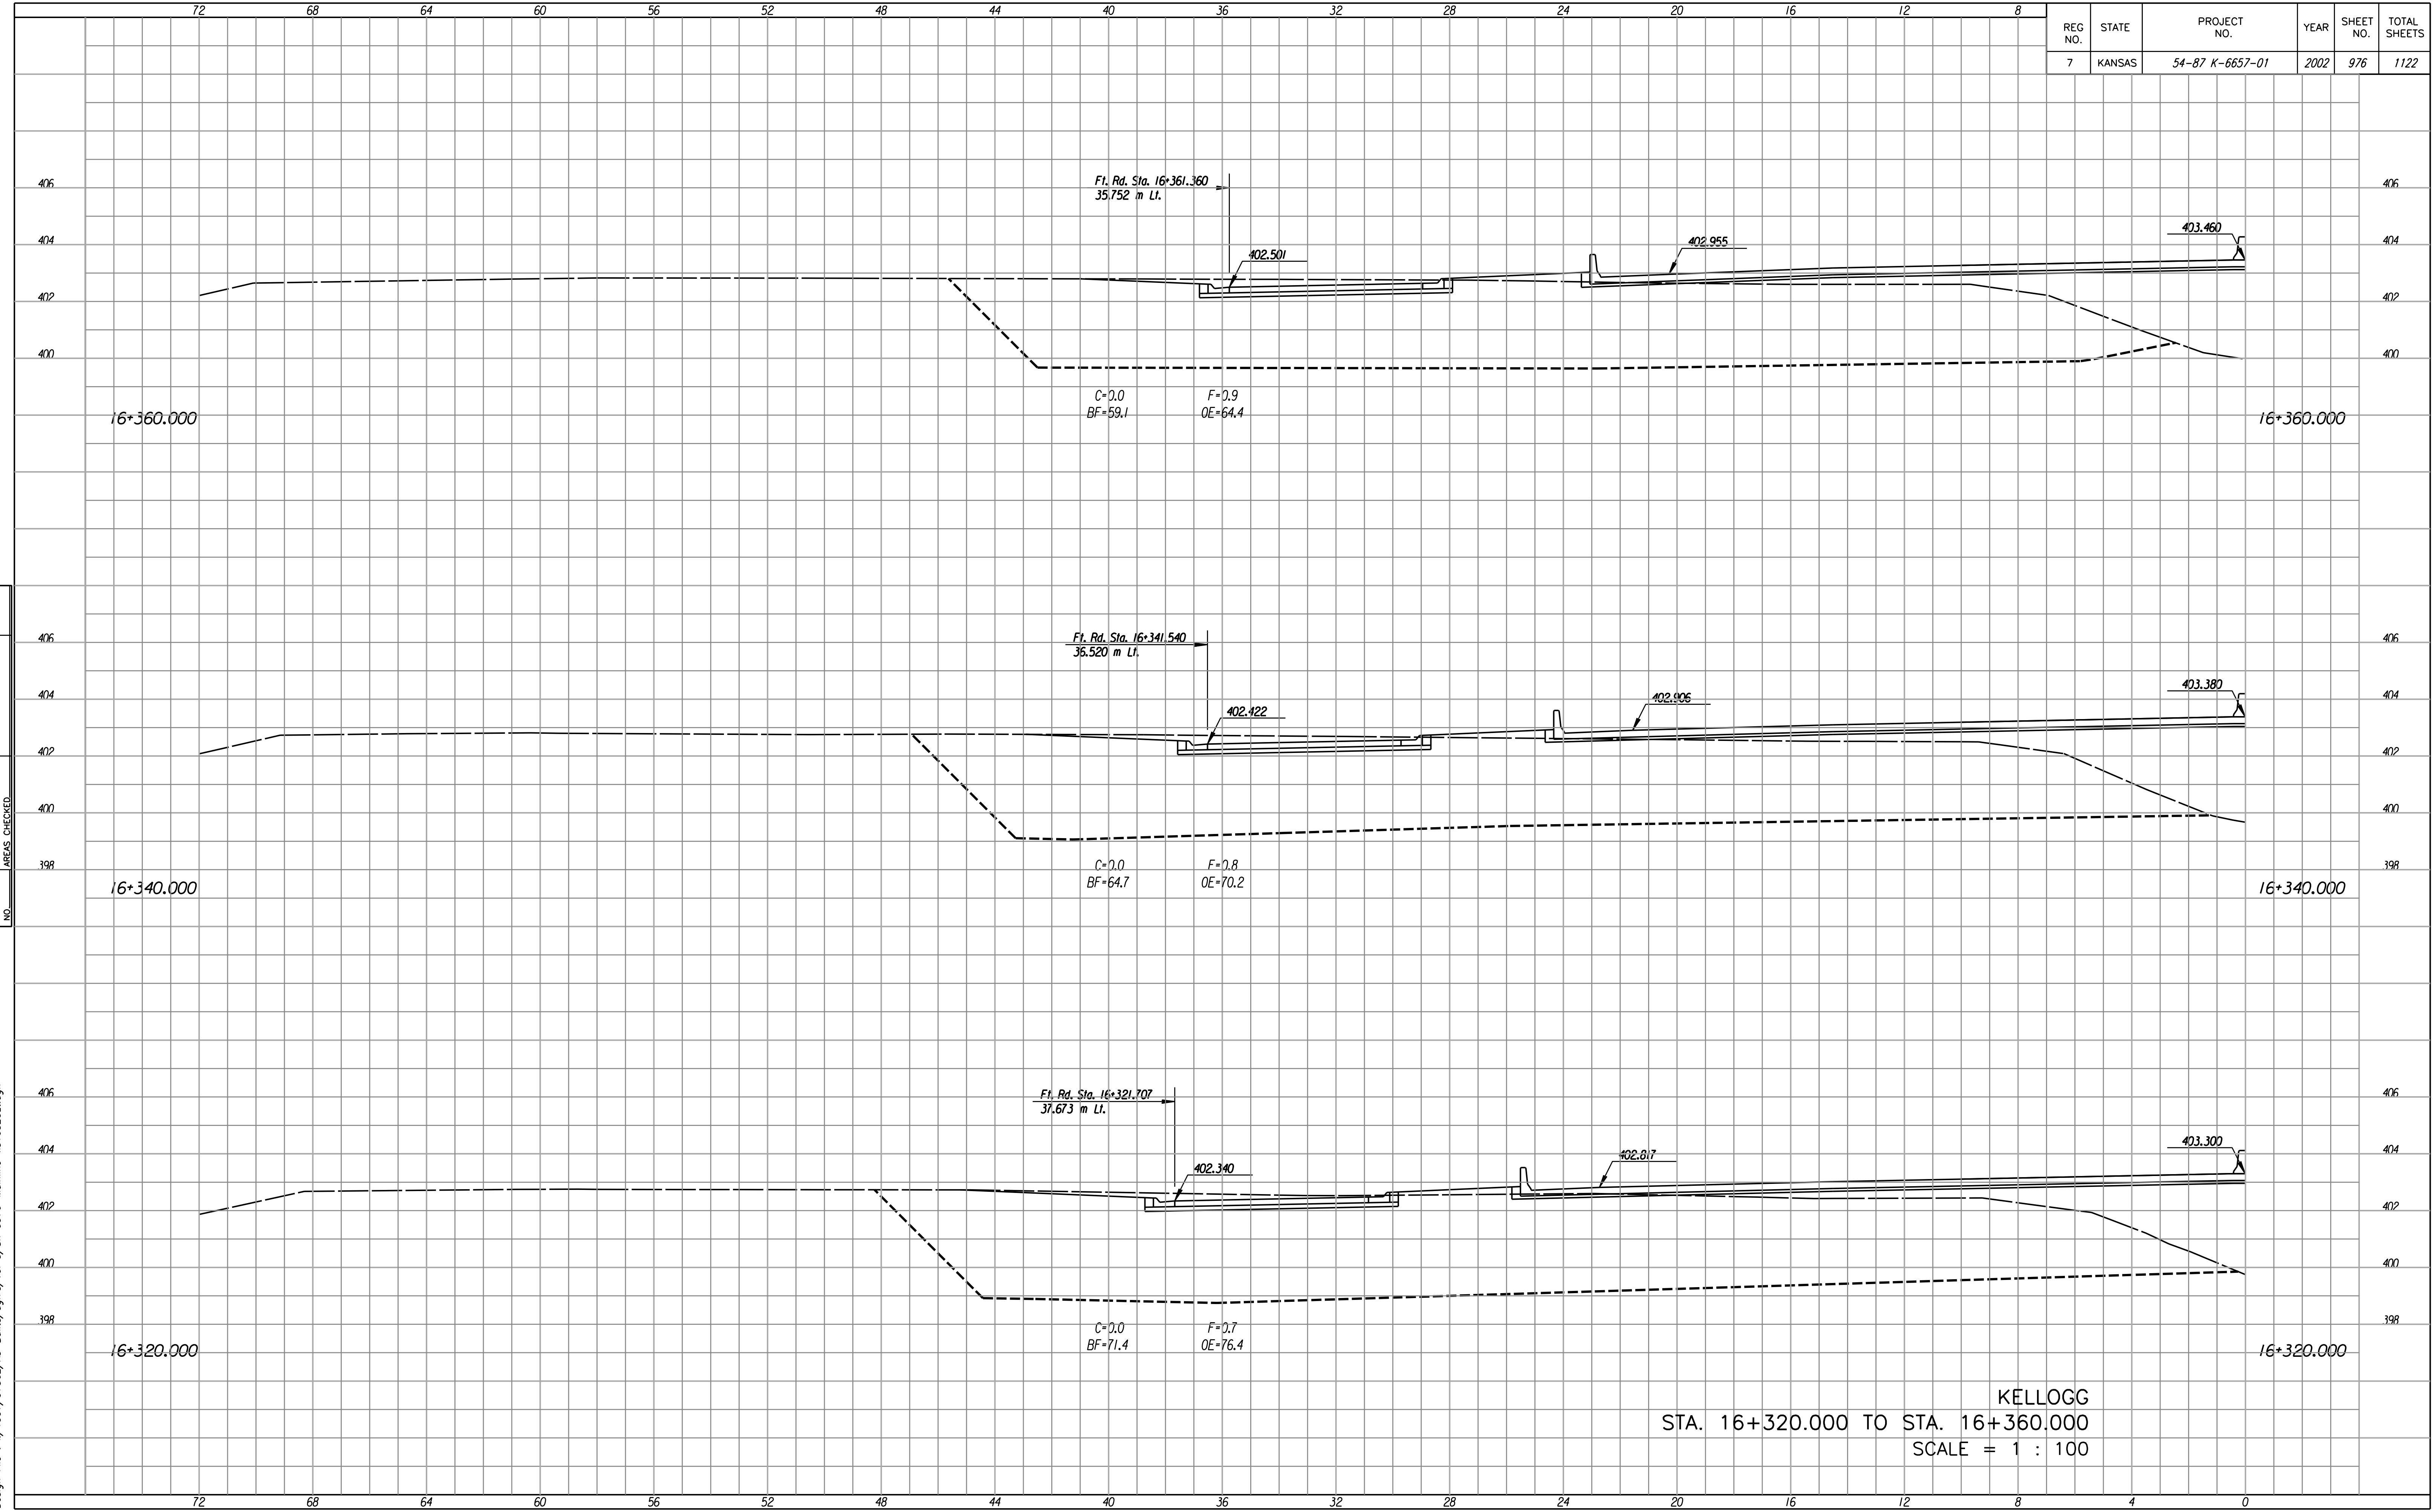

FINAL SURVEY NO.	SURVEYED BY	DATE
NOTE BOOK NO.	PLOTTED BY	DATE
AREAS CHECKED	DATE	BY

Last Rev. : 10-12-07 By: gdr
 Scale : 100
 Design File : i:\1997\97162\As-Builts\dgn\5/5/Sh 0916-Mainline-rs163201.dgn

KELLOGG
 STA. 16+320.000 TO STA. 16+360.000
 SCALE = 1 : 100