


REG. NO.	STATE	PROJECT NO.	YEAR	SHEET NO.	TOTAL SHEETS
7	KANSAS	54-87 K-6657-01	2002	990	1122

FINAL SURVEY NO.	DATE
SURVEYED	
BY	
PLOTTED	
TEMPLATE	
AREAS	
CHECKED	

Last Rev. : 10-12-07 By: gdr
 Scale : 100
 Design File : i:\1997\97162\As-Builts\ dgn\5/5h 0990-Mainline-rs167601.dgn

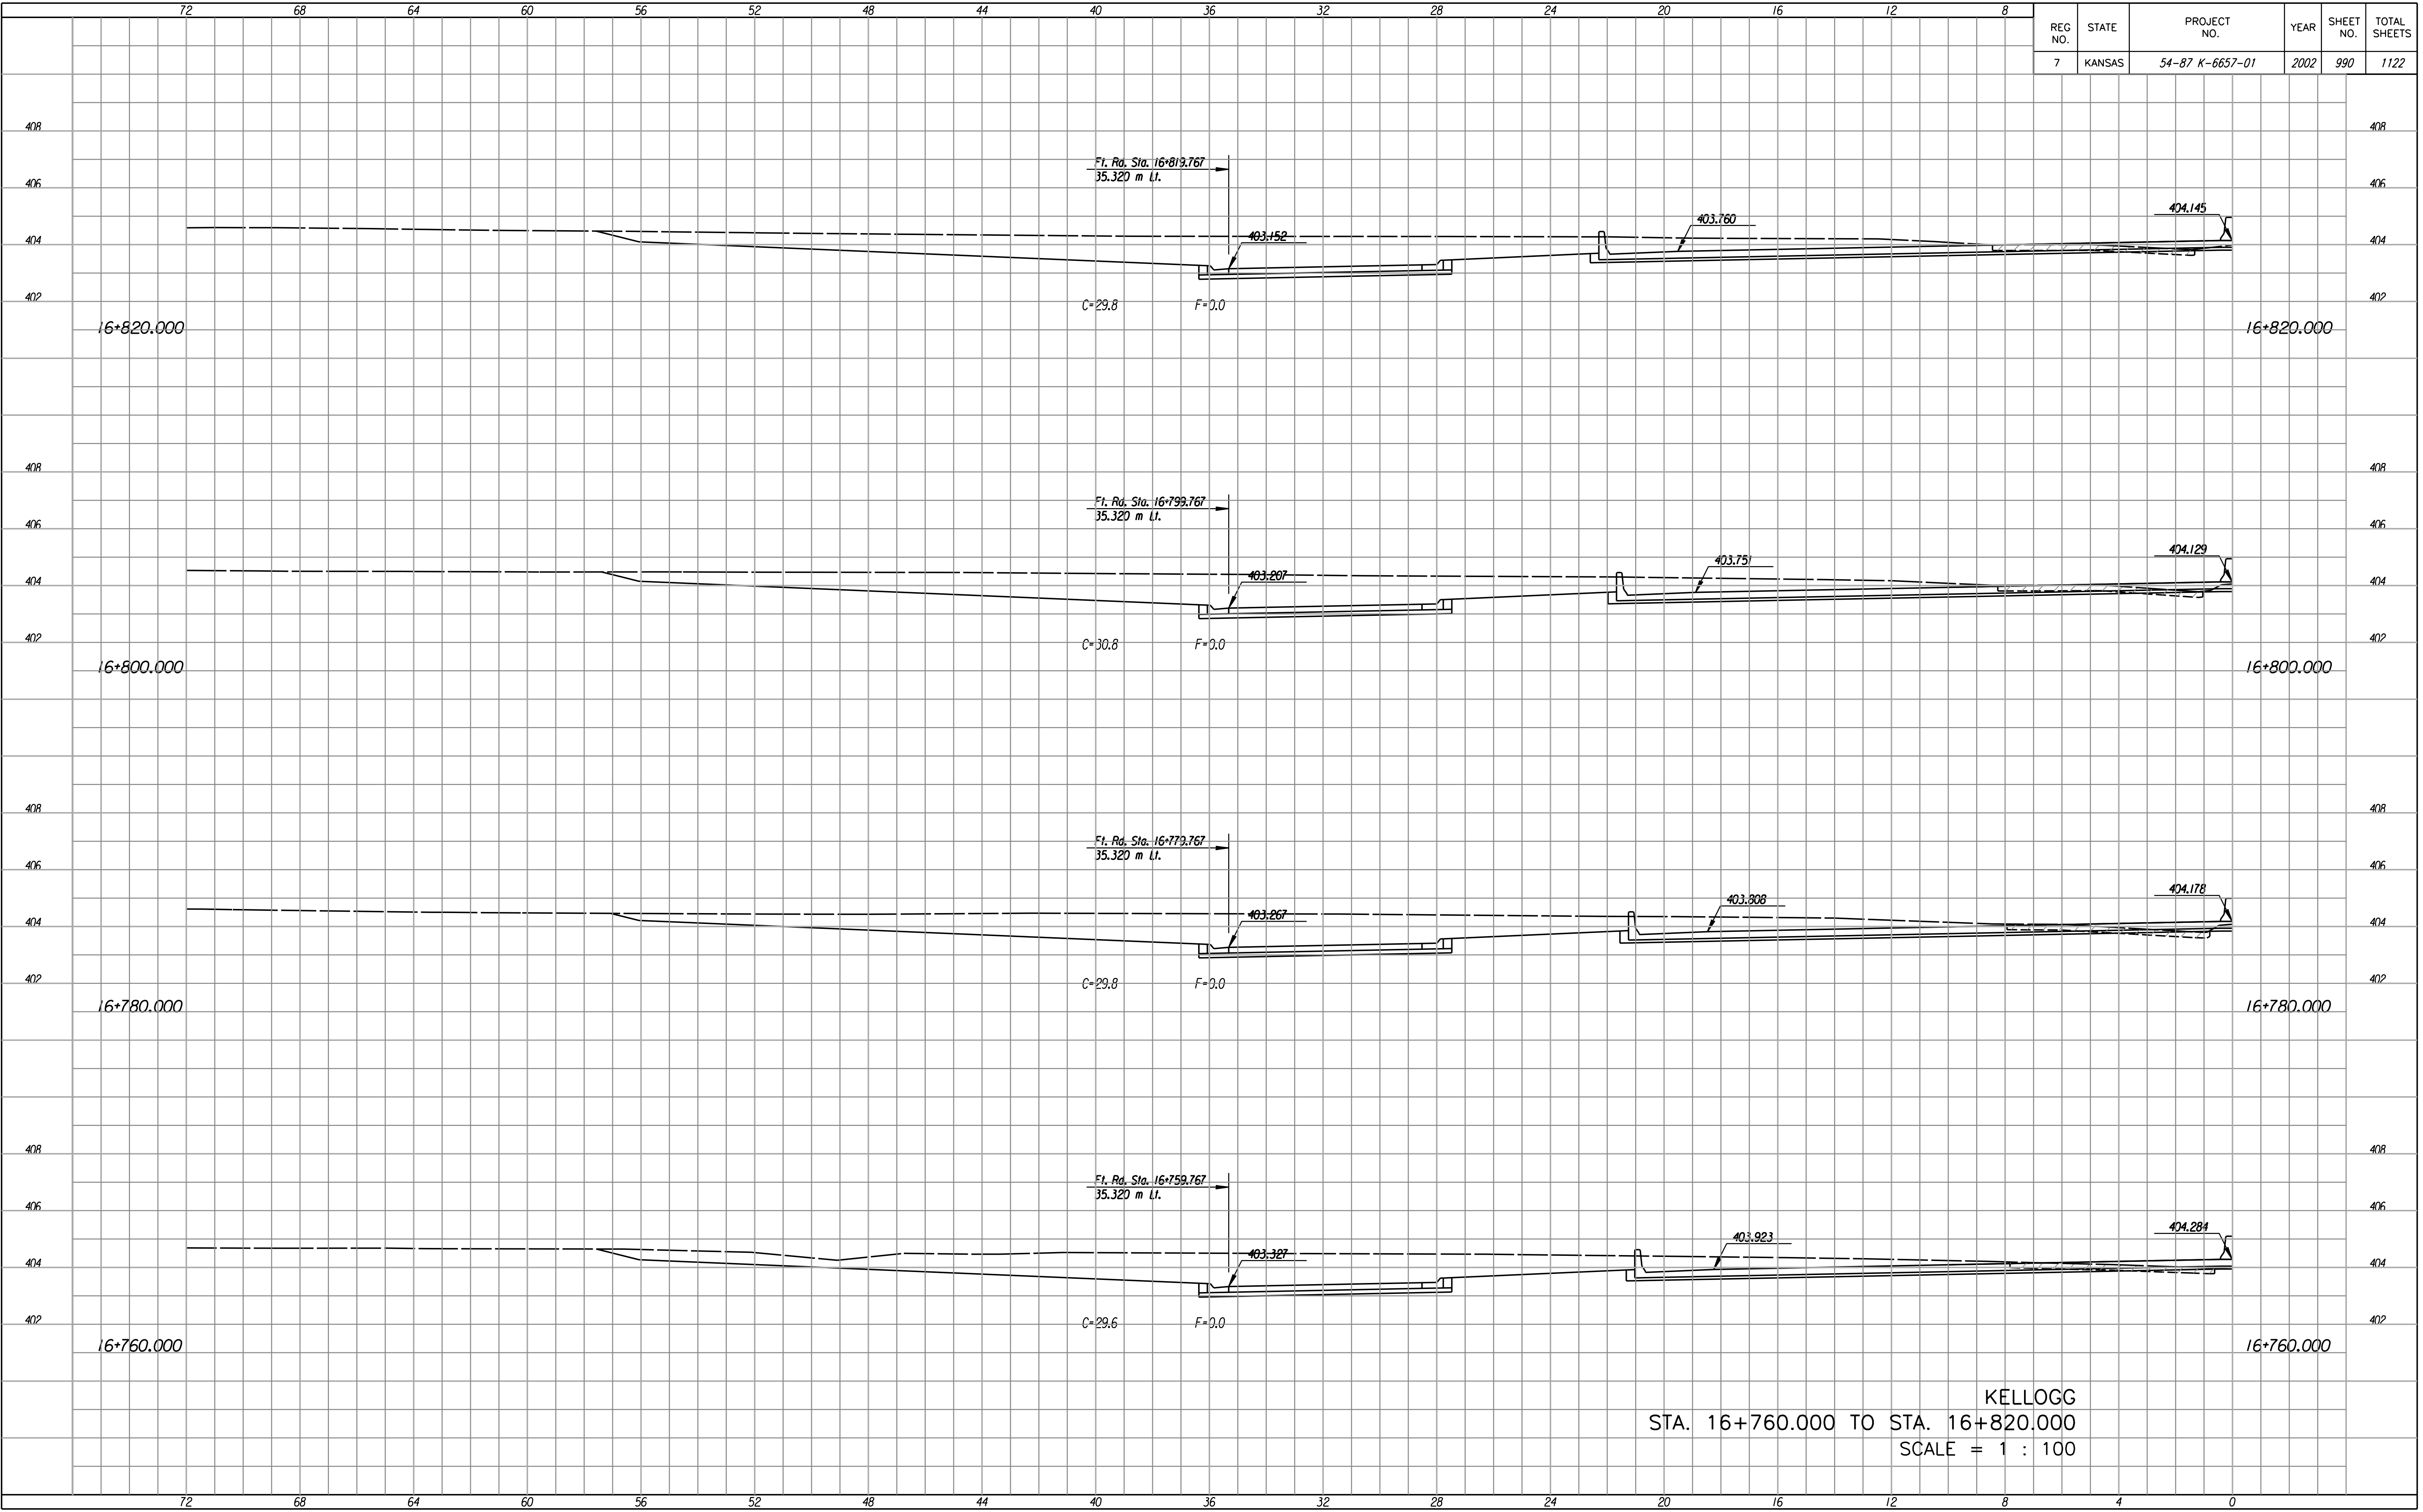

KELLOGG
 STA. 16+760.000 TO STA. 16+820.000
 SCALE = 1 : 100