


REG. NO.	STATE	PROJECT NO.	YEAR	SHEET NO.	TOTAL SHEETS
7	KANSAS	54-87 K-6657-01	2002	996	1122

FINAL SURVEY NO.	BY	DATE

Last Rev. : 10-12-07 By: gdr
 Scale : 100
 Design File : i:/1997/97162/As-Builts/dgn's/Vol 5/Sh 0956-Mainline-rs169801.dgn

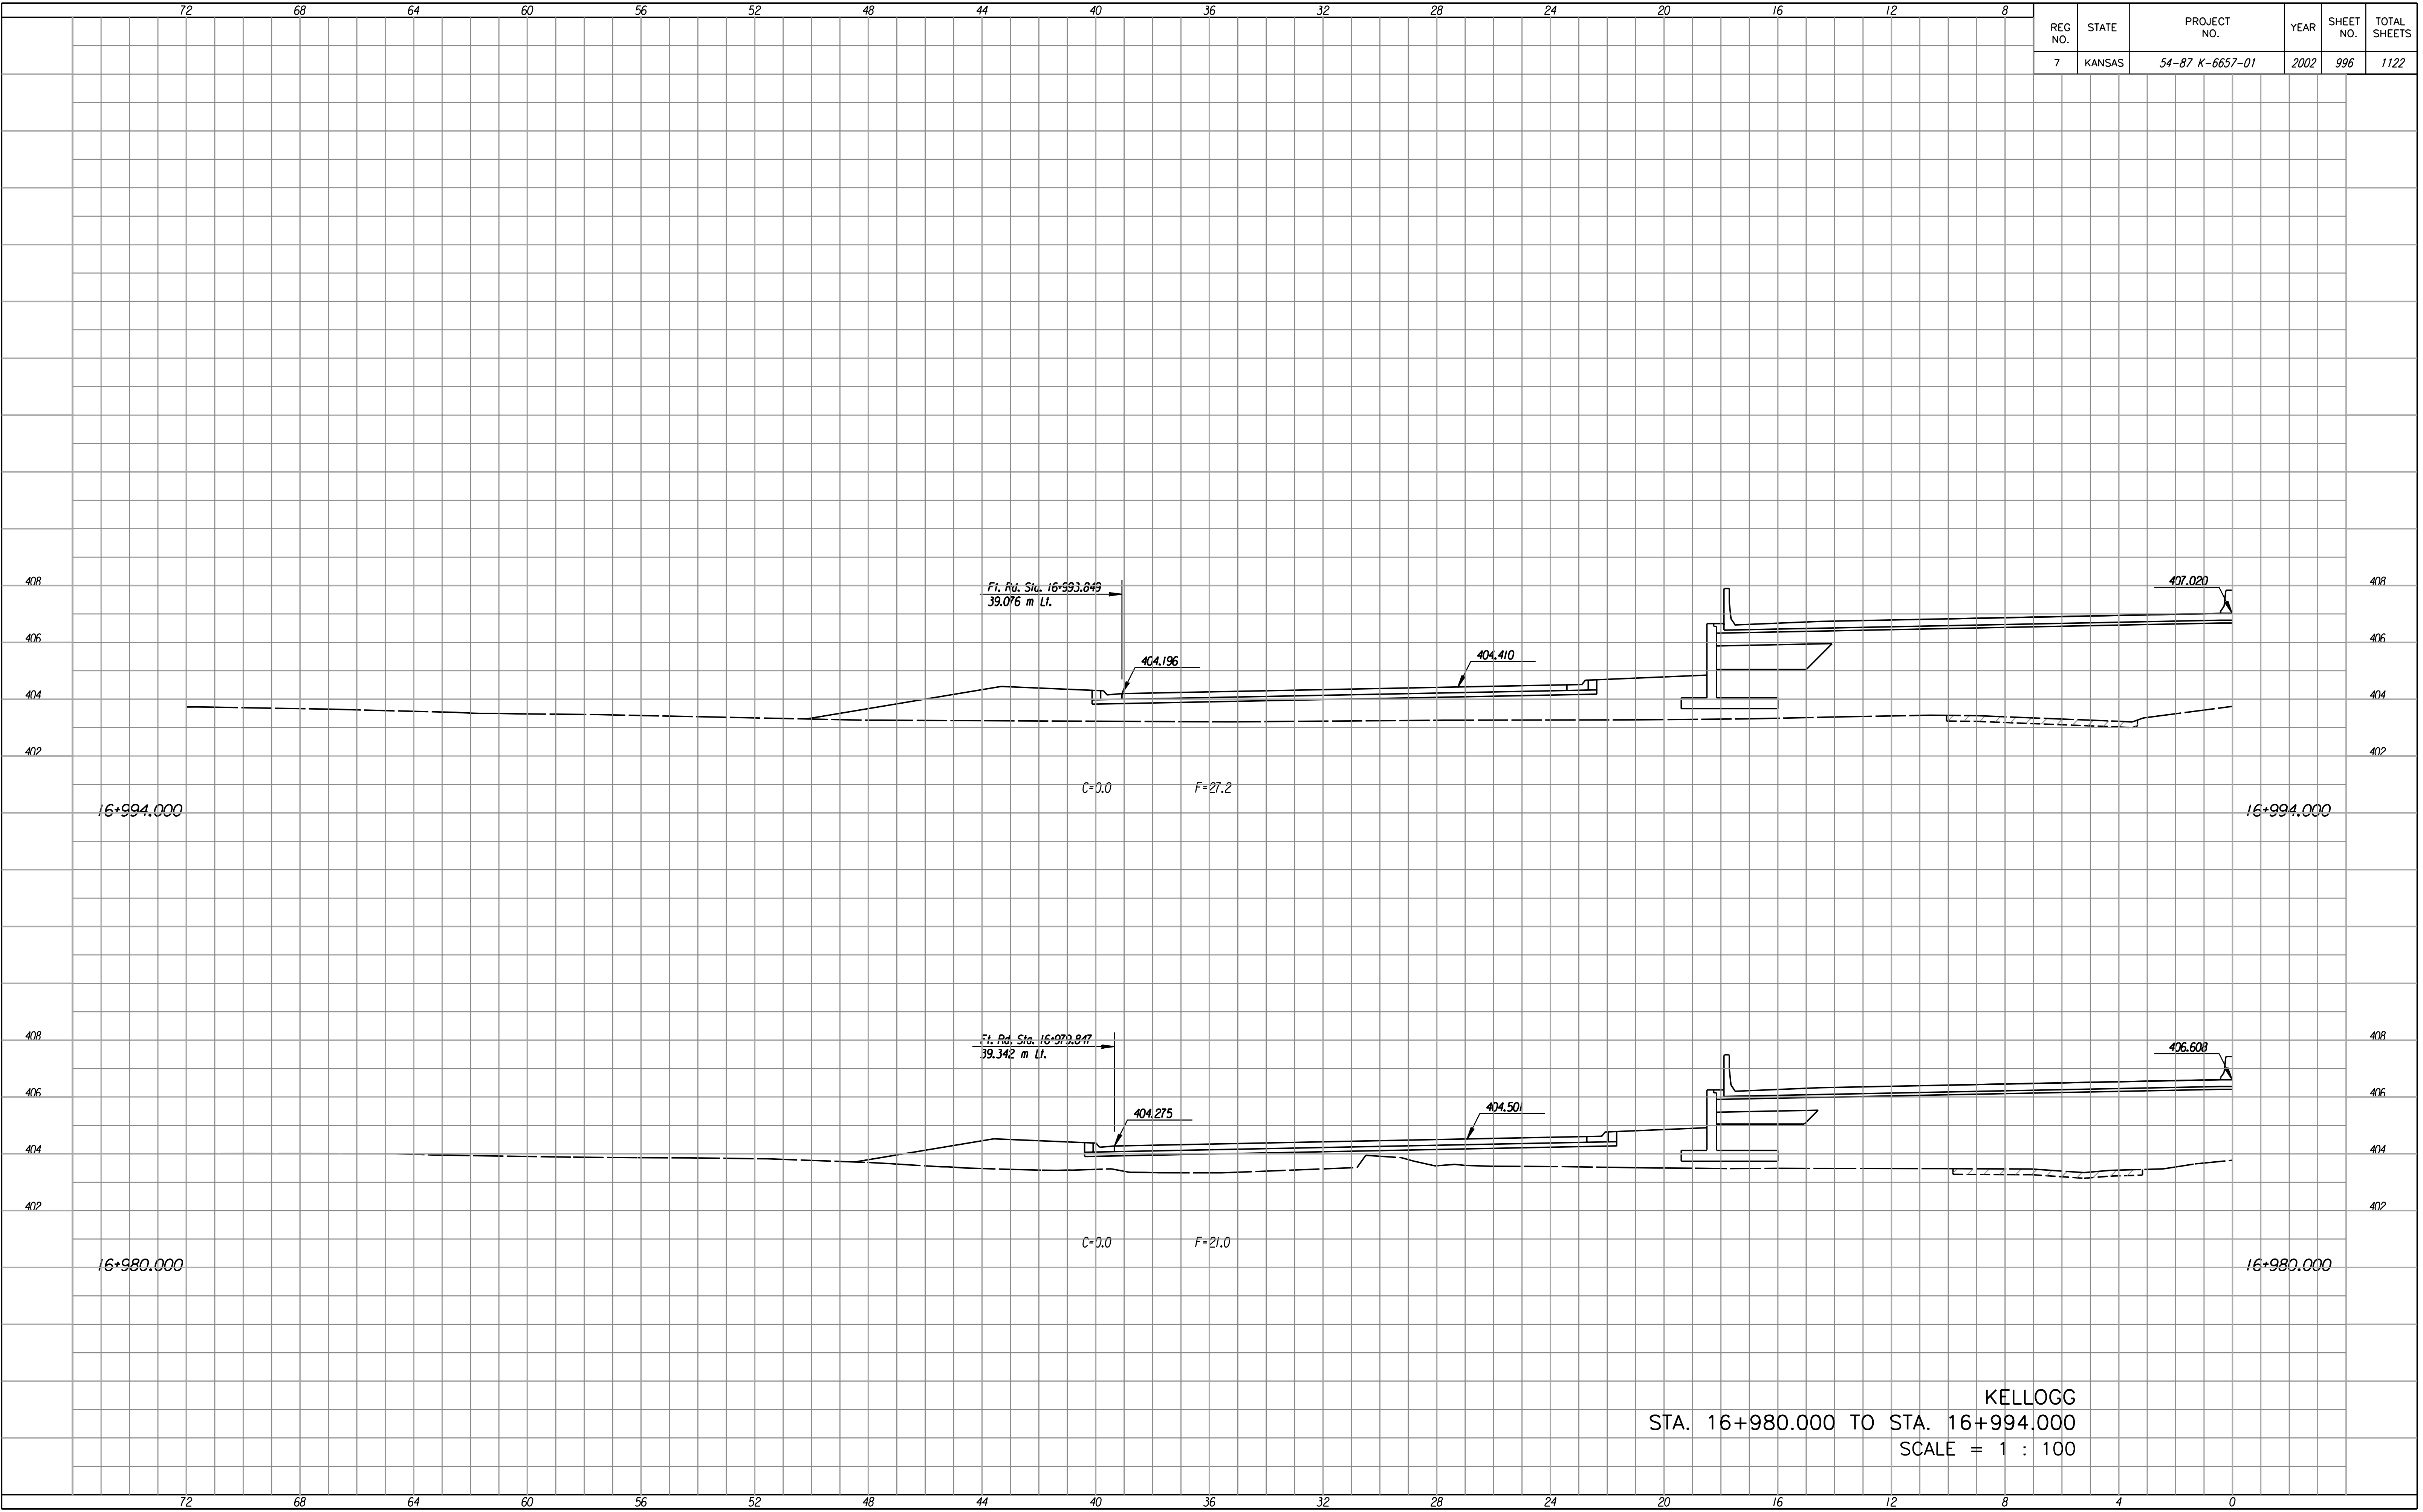

KELLOGG
 STA. 16+980.000 TO STA. 16+994.000
 SCALE = 1 : 100