


REG. NO.	STATE	PROJECT NO.	YEAR	SHEET NO.	TOTAL SHEETS
7	KANSAS	54-87 K-6657-01	2002	1002	1122

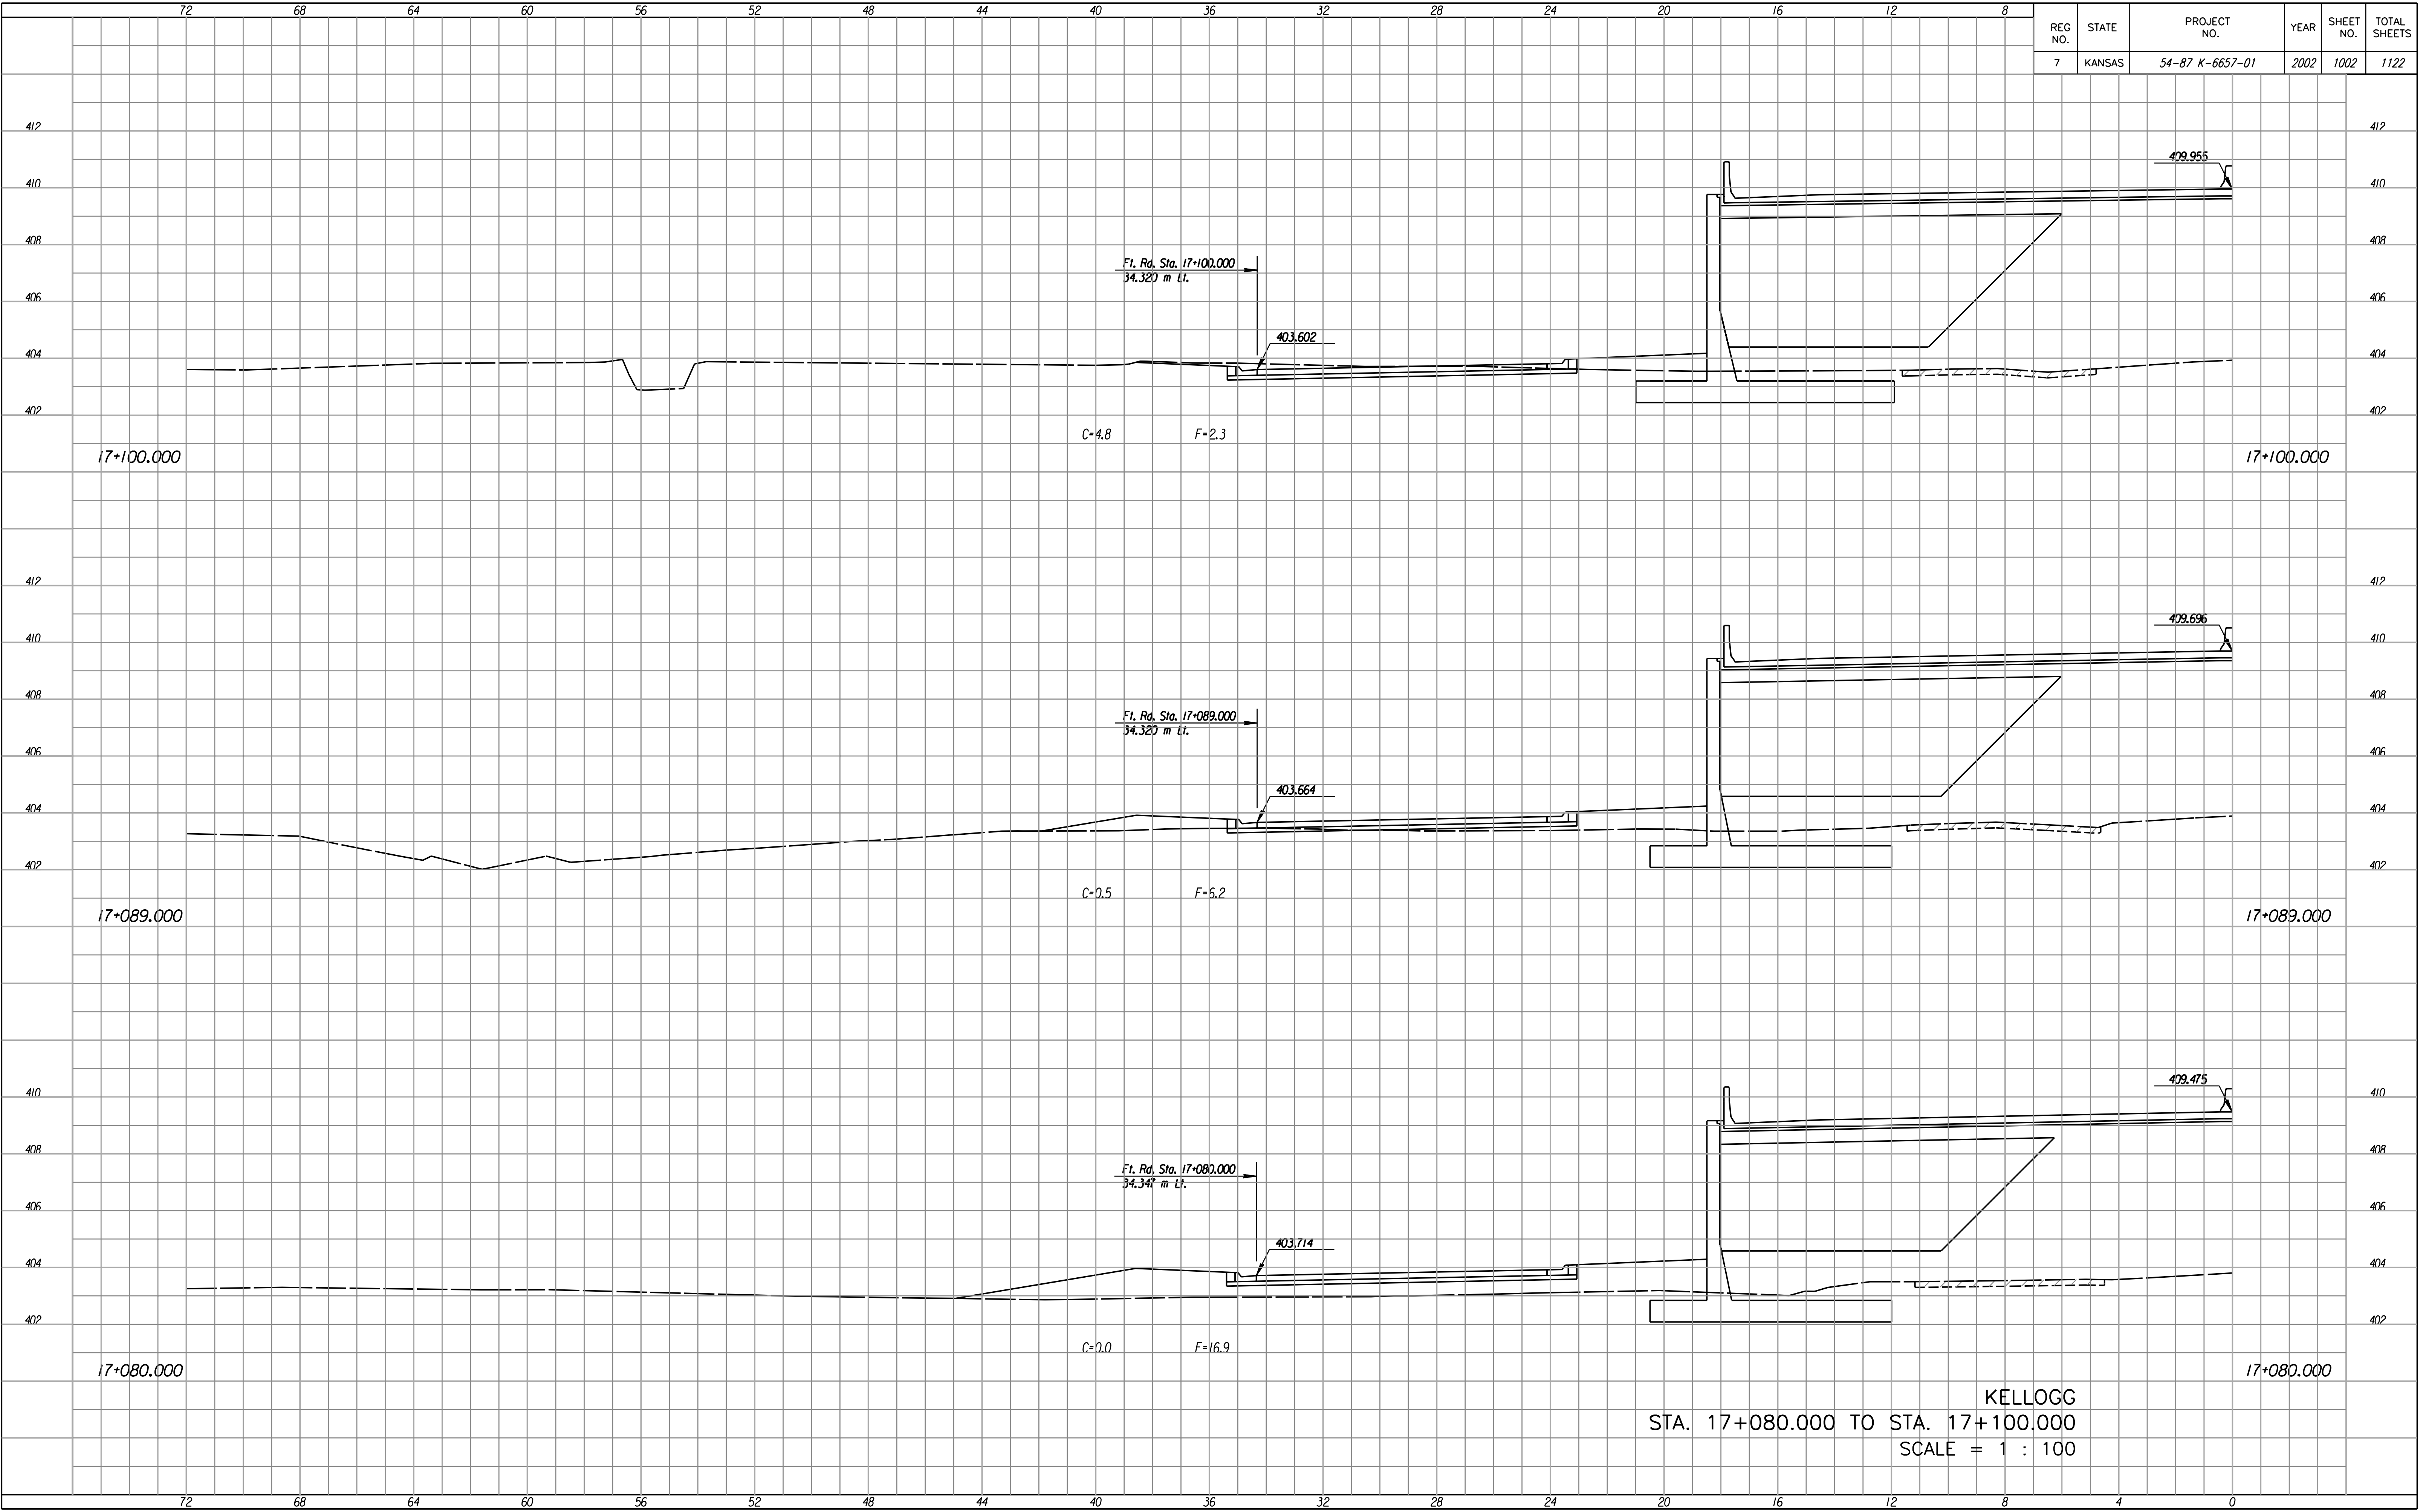

FINAL SURVEY NO.	SURVEYED BY	DATE
NOTE BOOK NO.	PLOTTED BY	DATE
AREAS CHECKED	TEMPLE	DATE

Last Rev. : 10-12-07 By: gdr
 Scale : 100
 Design File : i:\1997\97162\As-Builts\ dgn's\Vol 5\Sh 1002-Mainline-xst08001.dgn

STA. 17+080.000 TO STA. 17+100.000
 SCALE = 1 : 100
 KELLOGG