


REG. NO.	STATE	PROJECT NO.	YEAR	SHEET NO.	TOTAL SHEETS
7	KANSAS	54-87 K-6657-01	2002	1003	1122

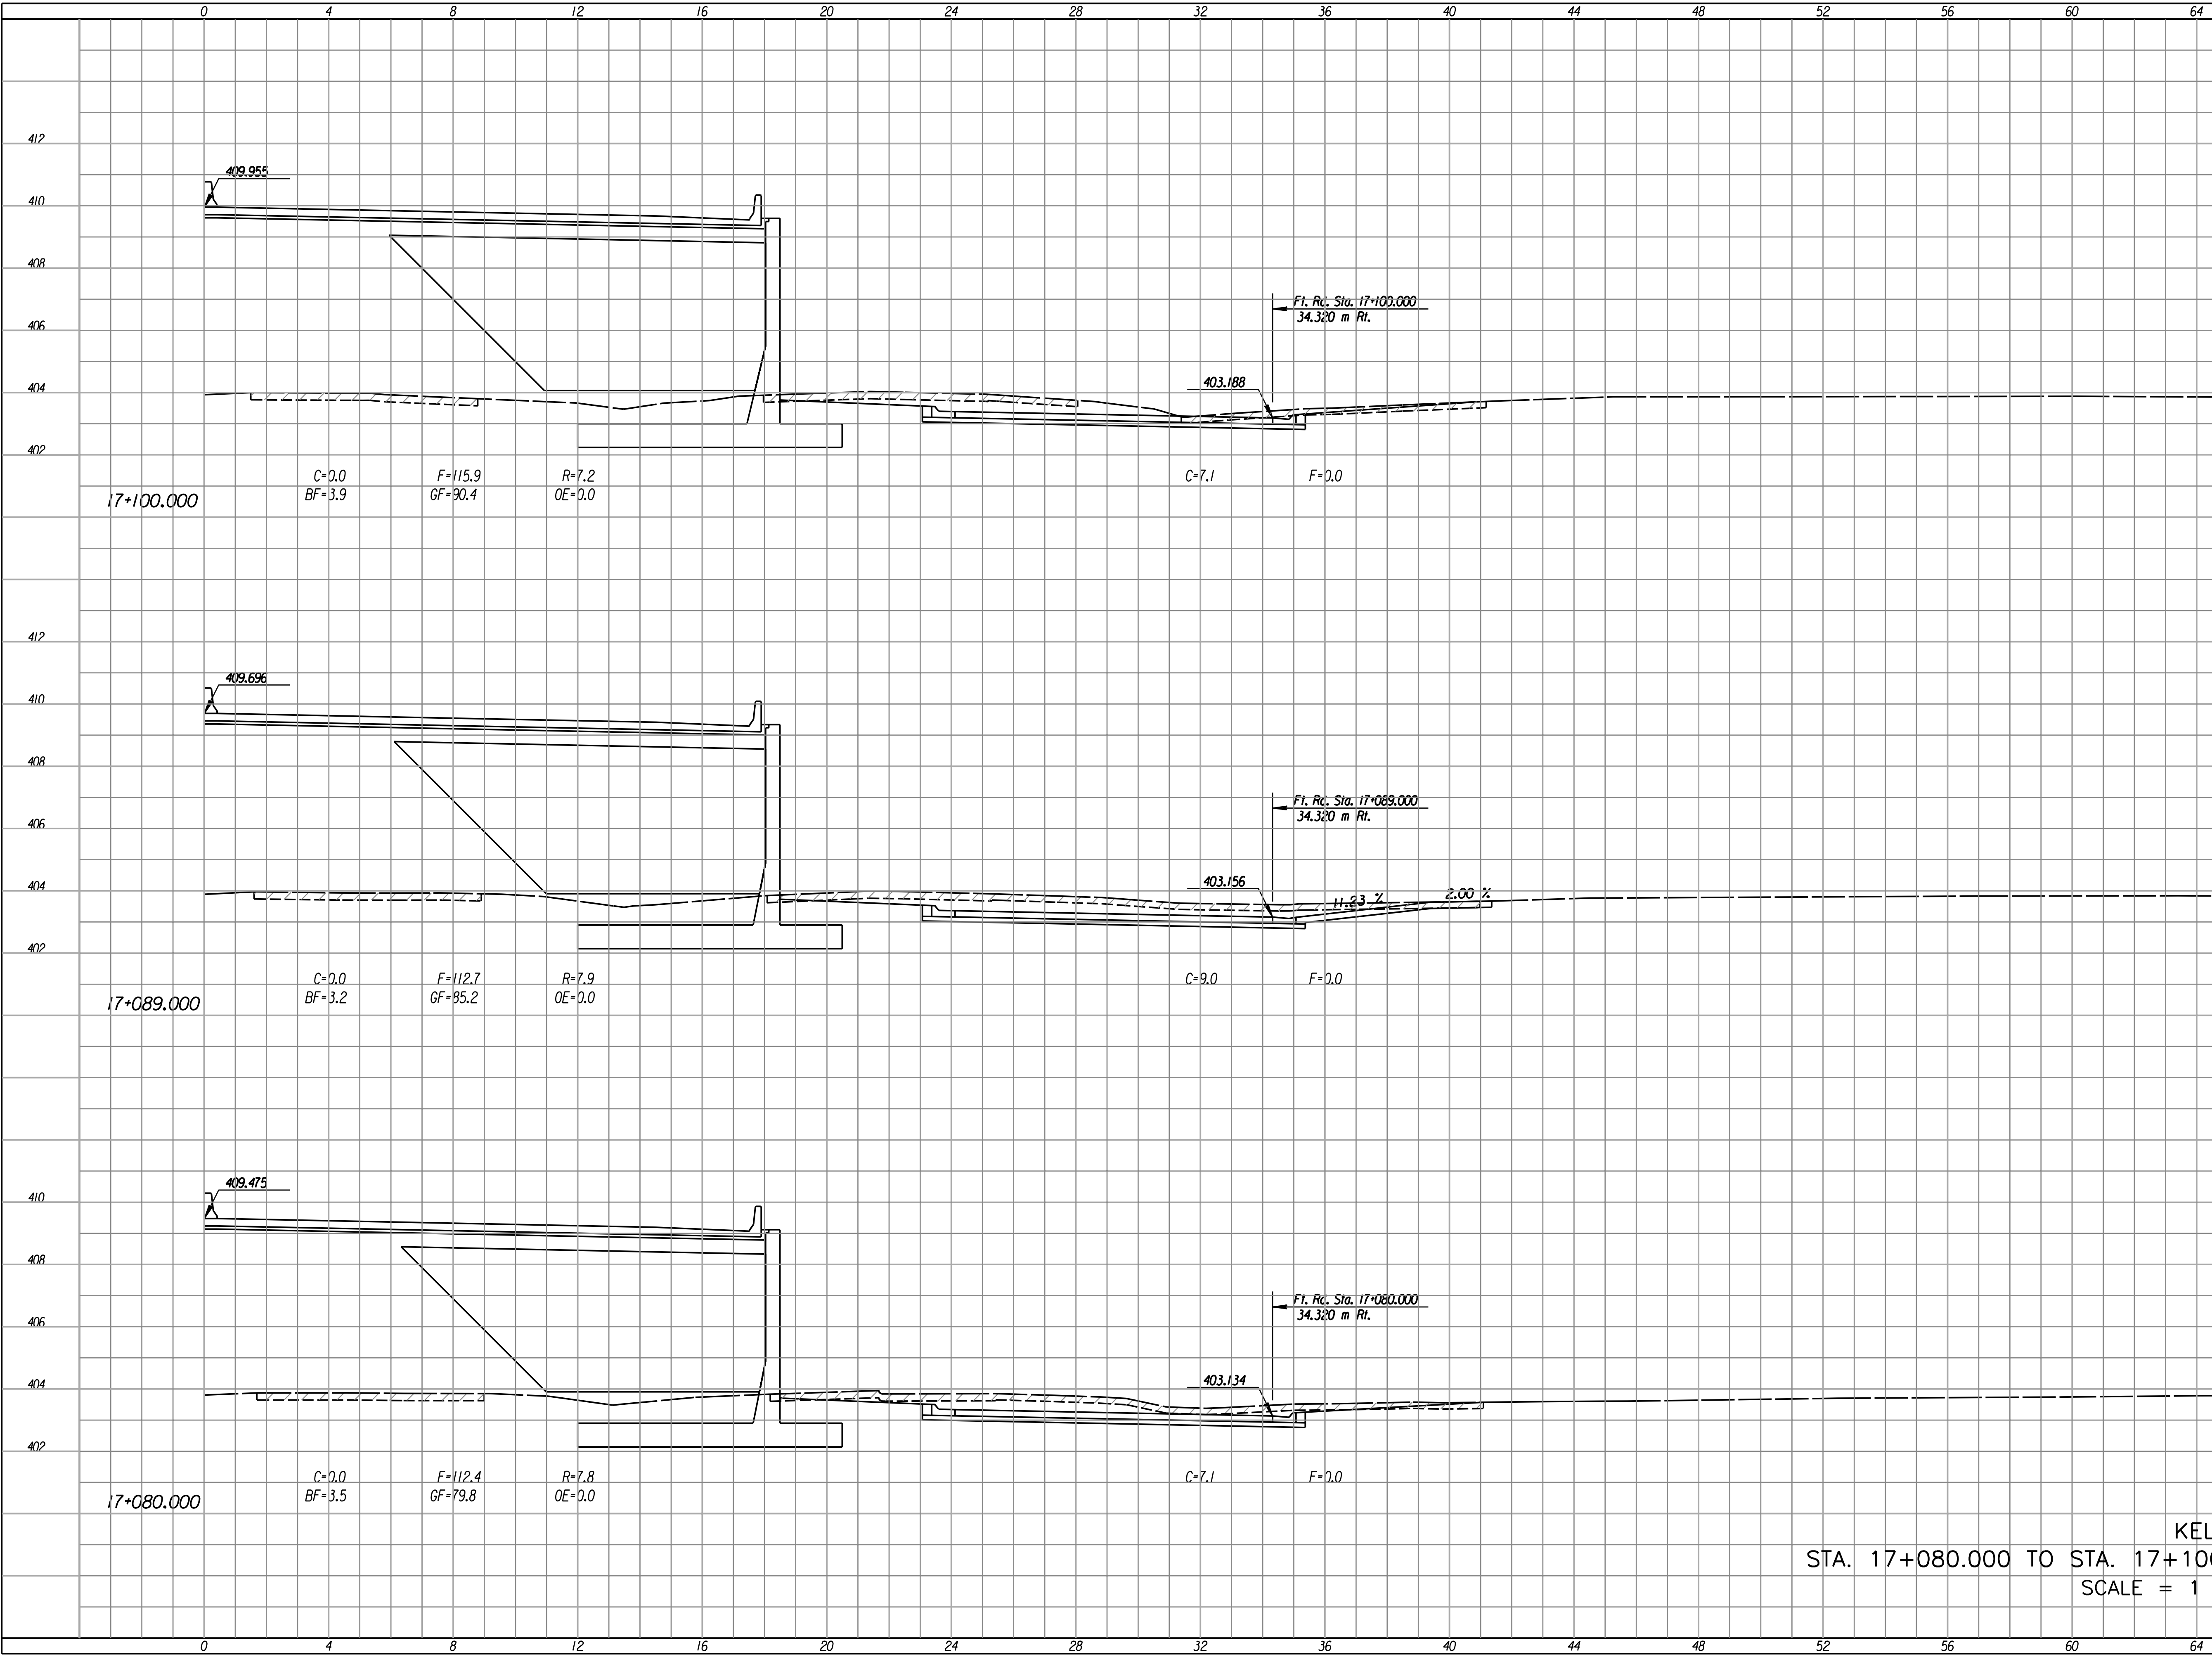

FINAL SURVEY NO.	SURVEYED BY	DATE
NO.	PLOTTED BY	DATE
NO.	TEMPLATE AREAS CHECKED	DATE

Last Rev. : 10-12-07 By: gdr  
Scale : 100  
Design File : i:\1997\97162\As-Builts\ dgn\5\Sh 1003-Mainline-xst0800rt.dgn

KELLOGG  
STA. 17+080.000 TO STA. 17+100.000  
SCALE = 1 : 100