


REG. NO.	STATE	PROJECT NO.	YEAR	SHEET NO.	TOTAL SHEETS
7	KANSAS	54-87 K-6657-01	2002	1004	1122

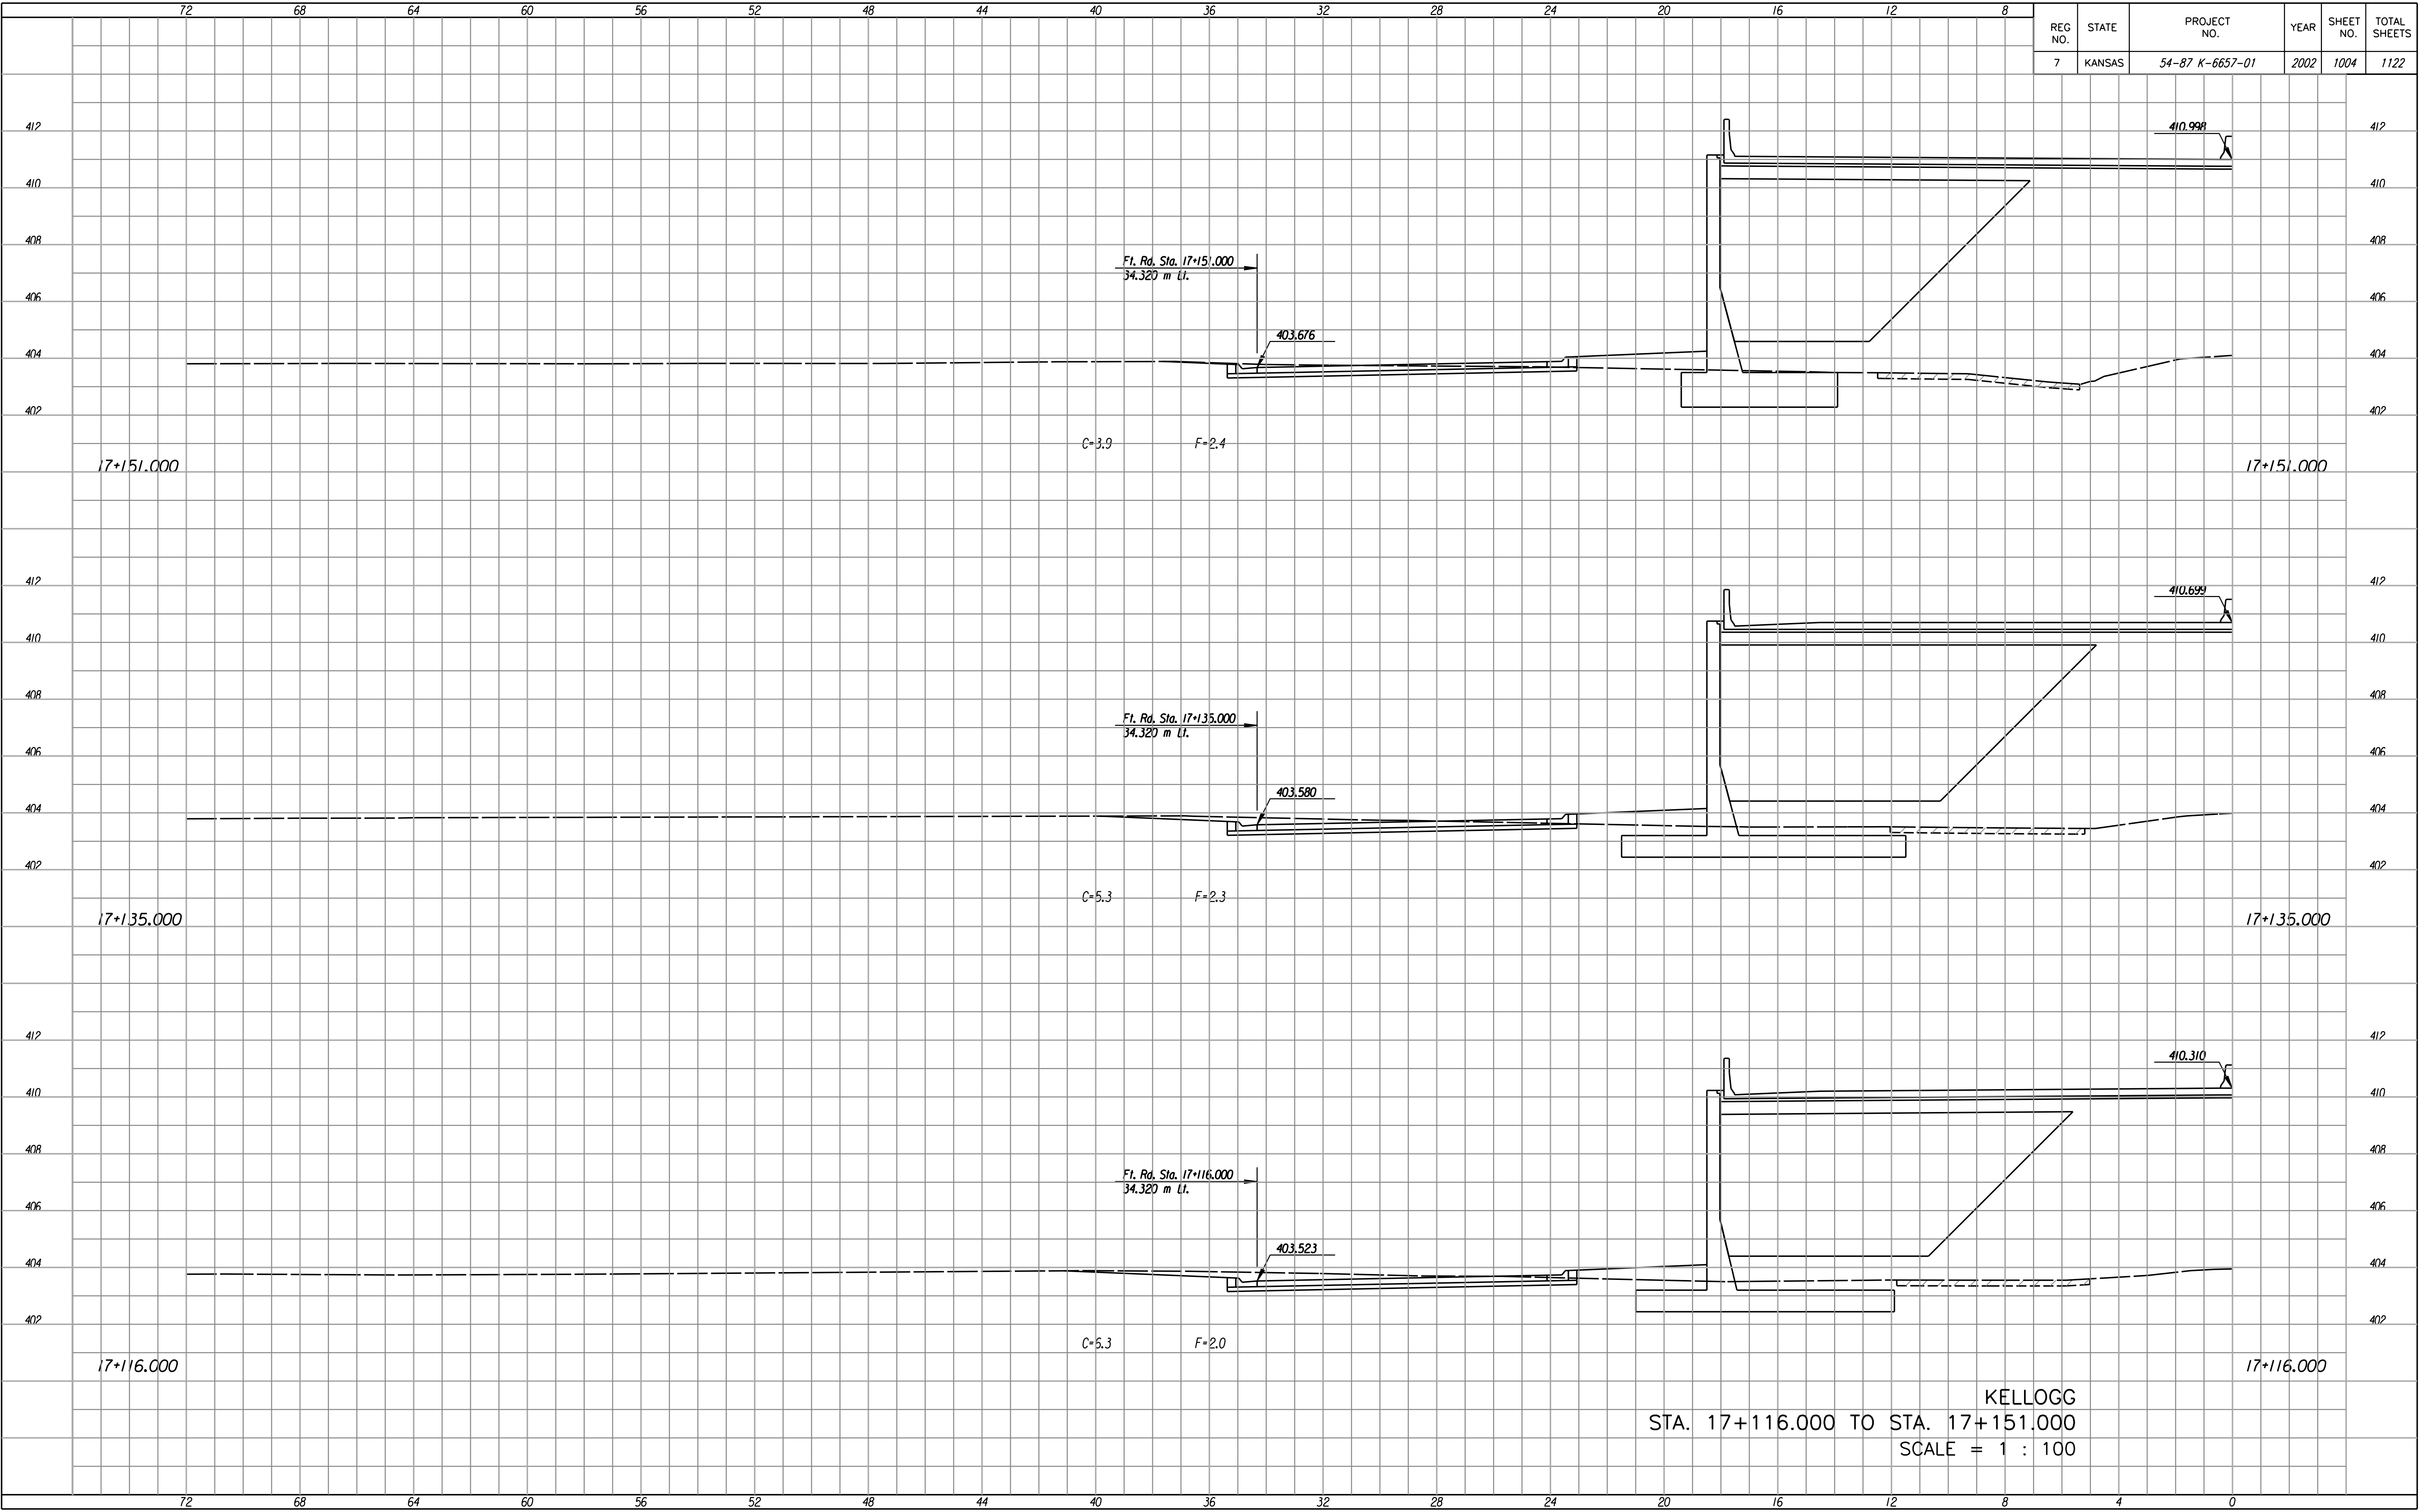

FINAL SURVEY NO.	BY	DATE
SURVEYED	PLOTTED	DATE
NOTE BOOK NO.	TEMPLATE AREAS CHECKED	AREAS CHECKED

Last Rev. : 10-12-07 By: gdr  
Scale : 100  
Design File : i:\1997\97162\As-Builts\ dgn\Vol 5\Sh 1004-Mainline-xst1161.dgn

KELLOGG  
STA. 17+116.000 TO STA. 17+151.000  
SCALE = 1 : 100