


REG. NO.	STATE	PROJECT NO.	YEAR	SHEET NO.	TOTAL SHEETS
7	KANSAS	54-87 K-6657-01	2002	1012	1122

FINAL SURVEY NO.	BY	DATE
SURVEYED	PLOTTED	DATE
NOTE BOOK	TEMPLATE	AREAS
NO.	CHECKED	AREAS

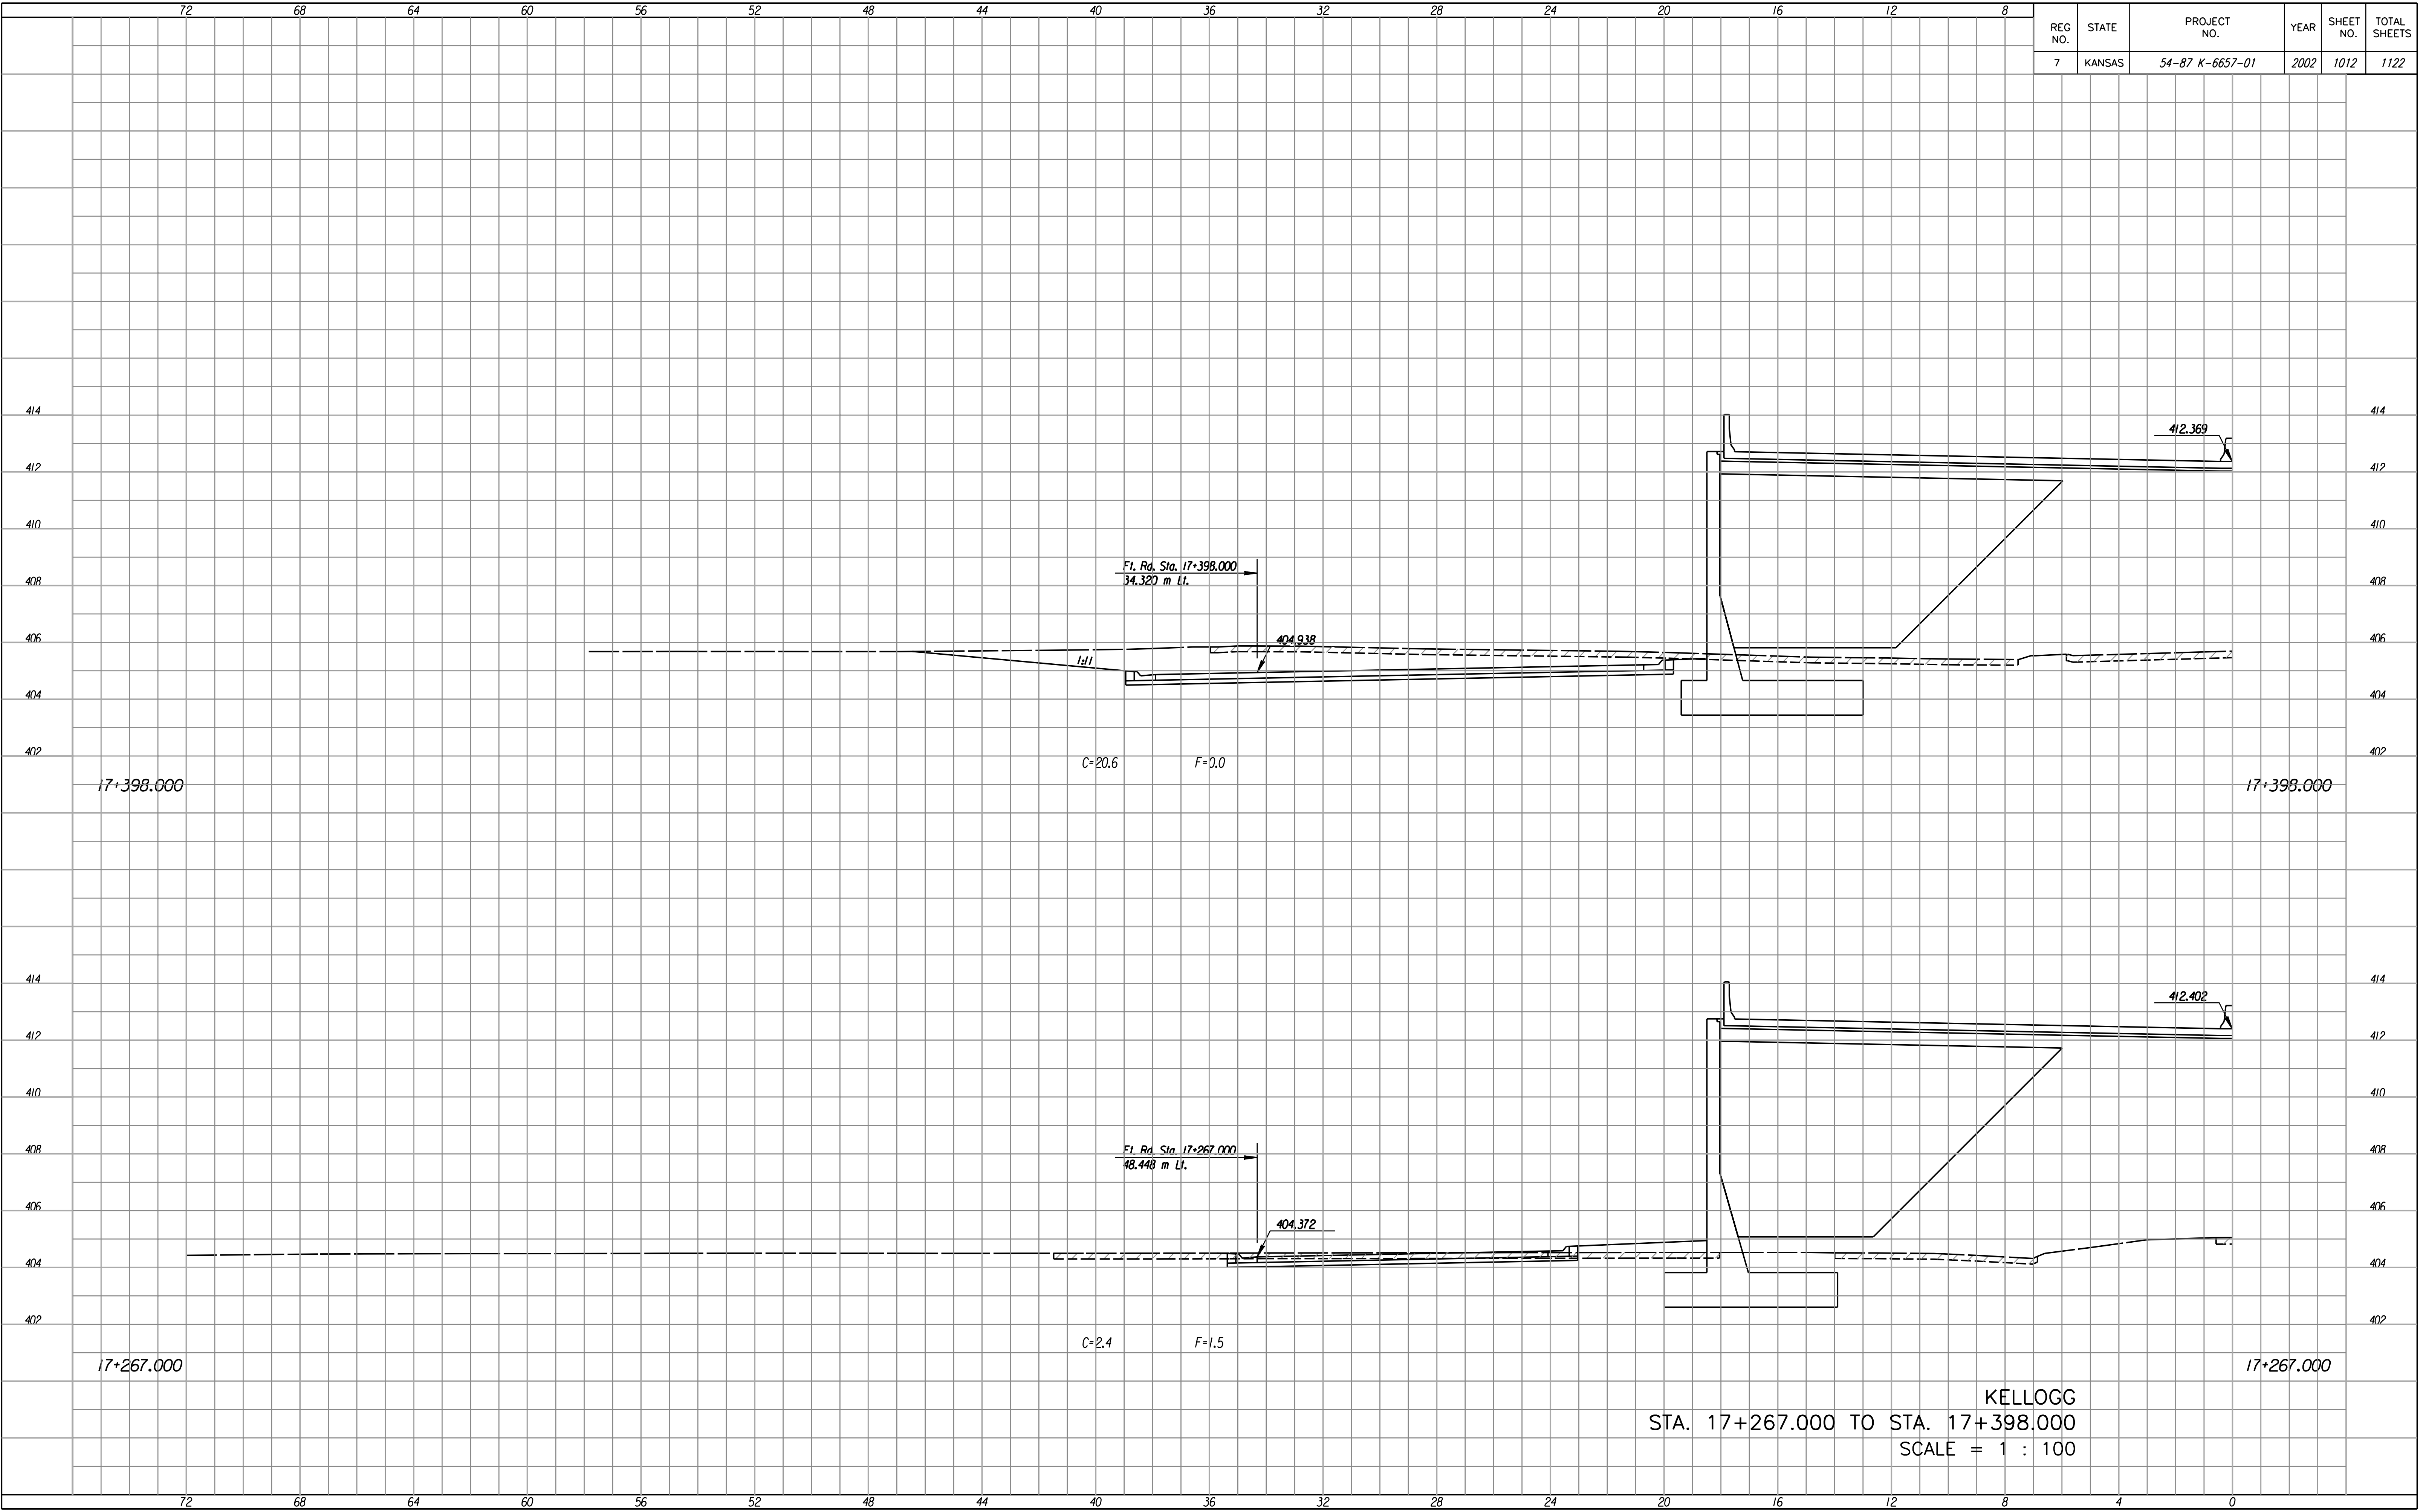

Last Rev. : 10-12-07 By: gdr
 Scale : 100
 Design File : i:/1997/97662/As-Builts/dgn/s/Vol 5/Sh 1012-Mainline-xst267L1.dgn

KELLOGG
 STA. 17+267.000 TO STA. 17+398.000
 SCALE = 1 : 100