


REG. NO.	STATE	PROJECT NO.	YEAR	SHEET NO.	TOTAL SHEETS
7	KANSAS	54-87 K-6657-01	2002	1013	1122

FINAL SURVEY NO.	BY	DATE

Last Rev. : 10-12-07 By: gdr
 Scale : 100
 Design File : i:\1997\97162\As-Builts\dgn\5/5h 1013-Mainline-xst267Rt.dgn

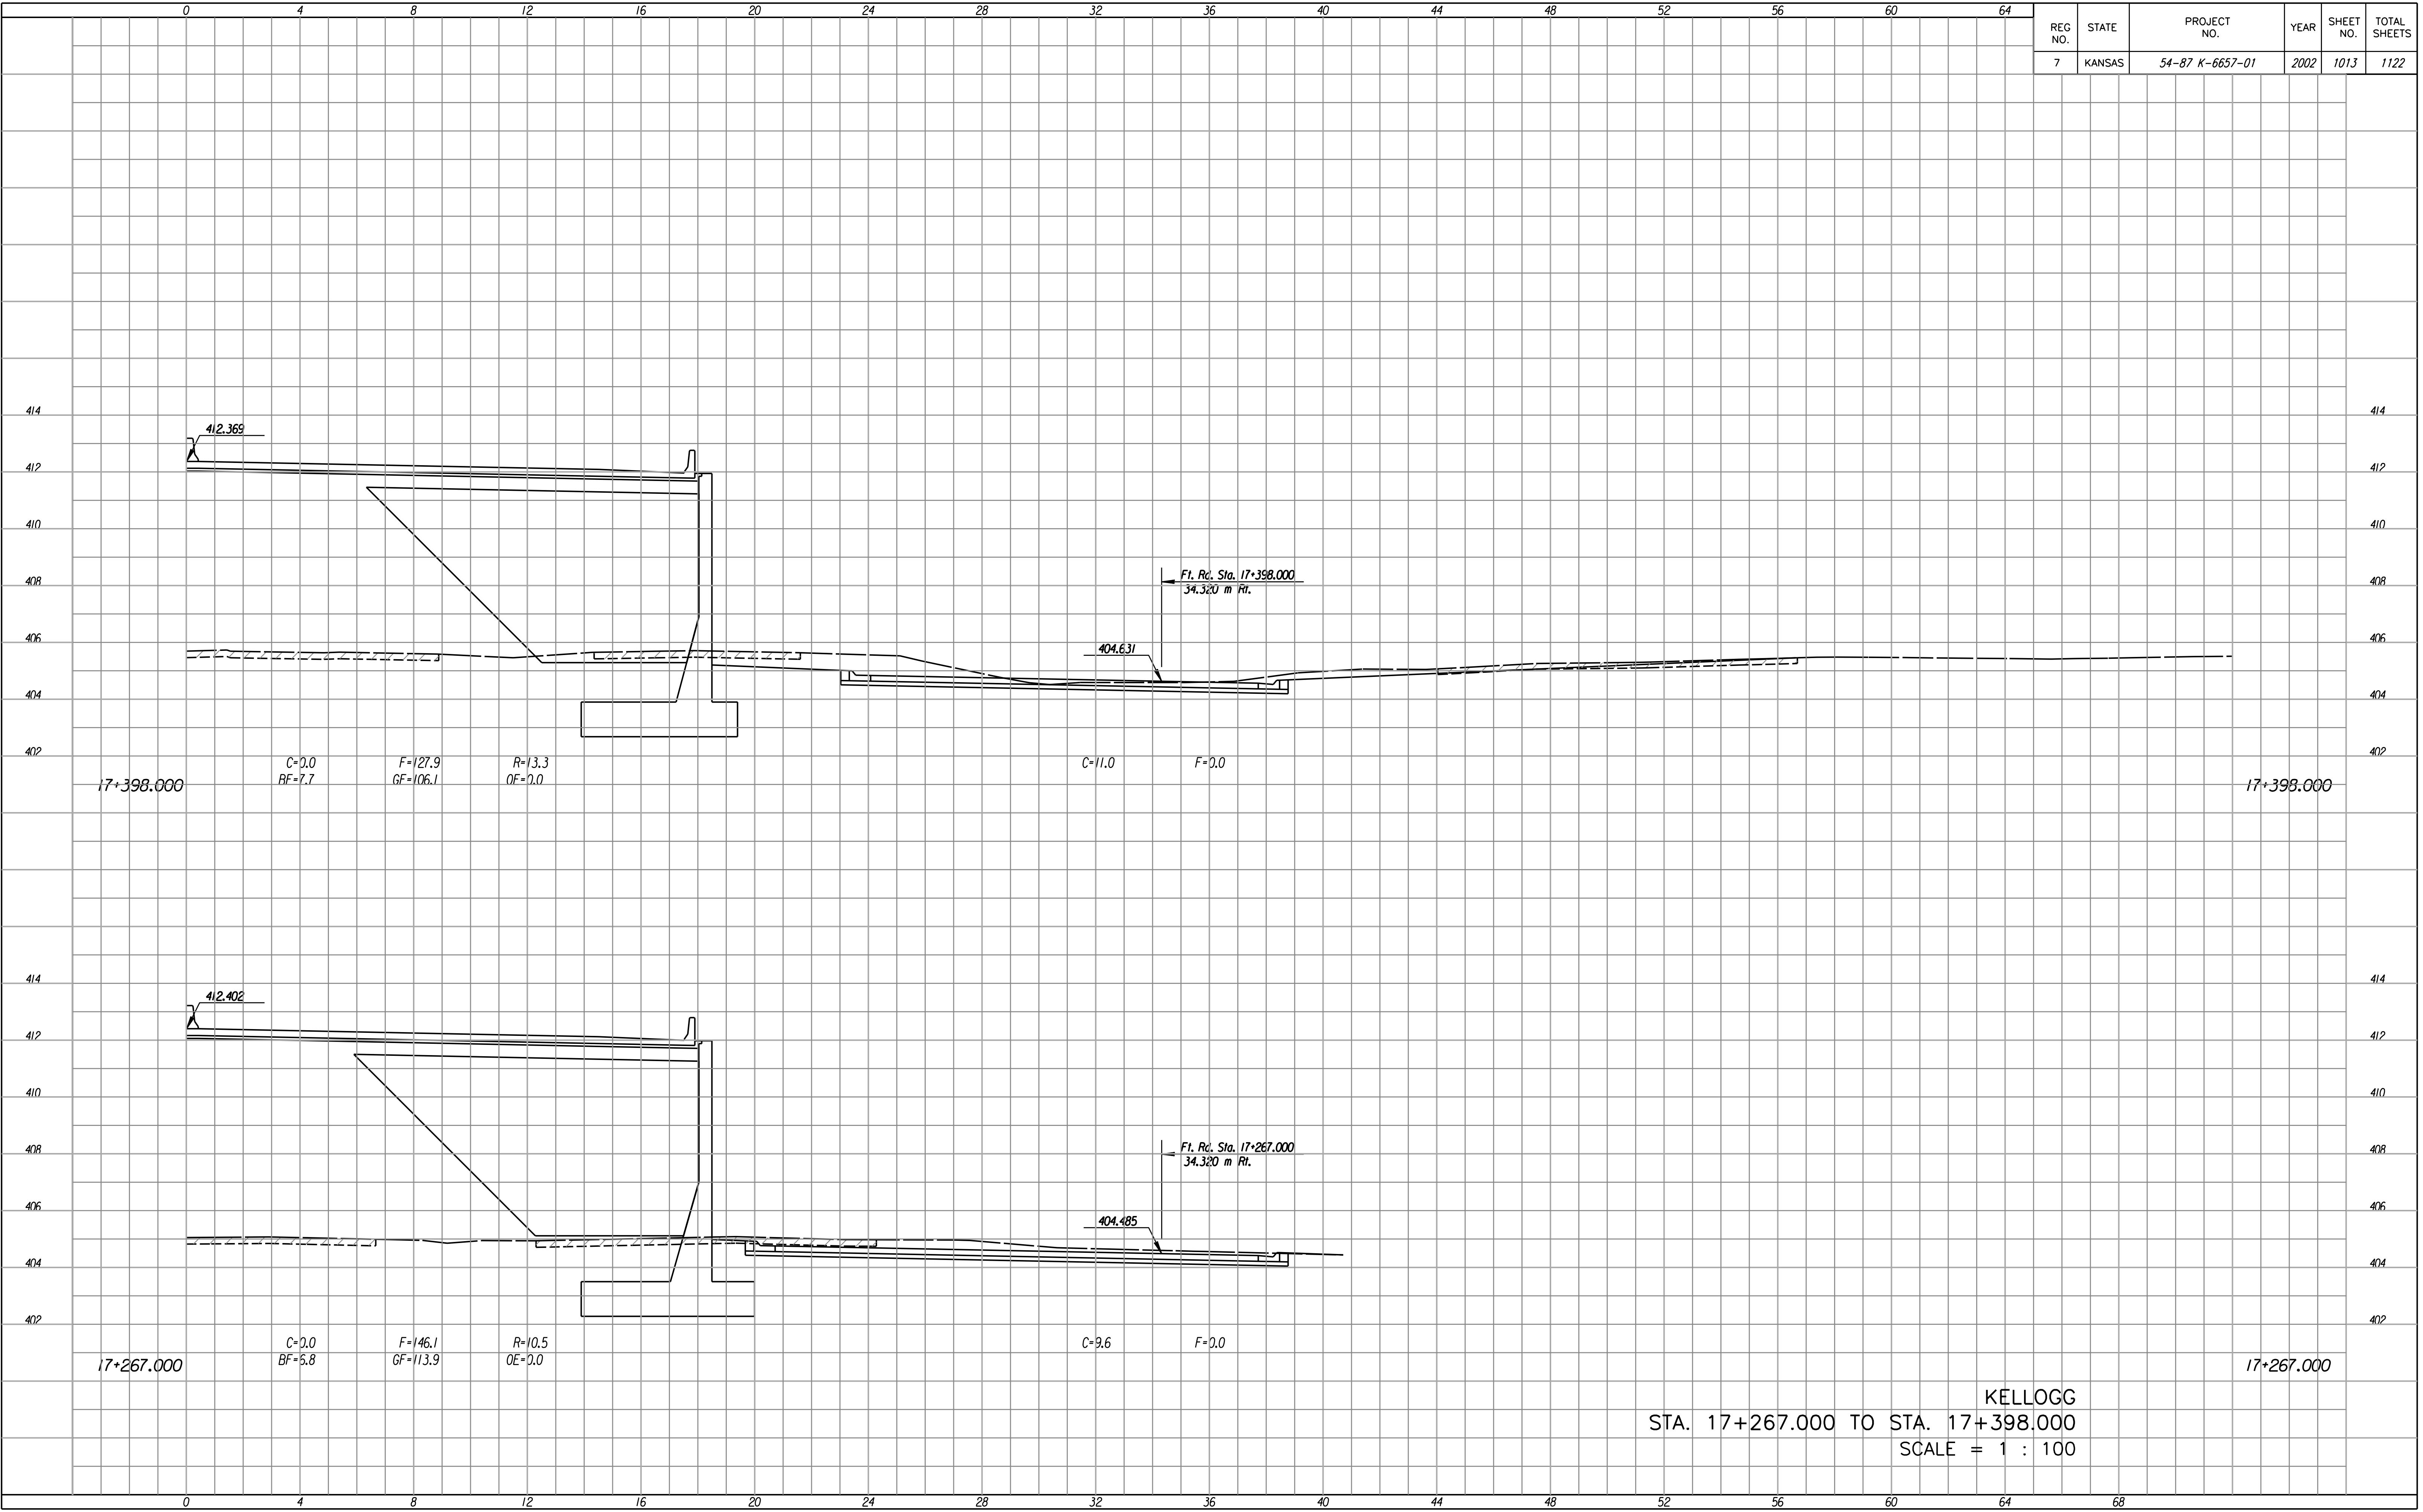

KELLOGG
 STA. 17+267.000 TO STA. 17+398.000
 SCALE = 1 : 100