


| REG. NO. | STATE  | PROJECT NO.     | YEAR | SHEET NO. | TOTAL SHEETS |
|----------|--------|-----------------|------|-----------|--------------|
| 7        | KANSAS | 54-87 K-6657-01 | 2002 | 1015      | 1122         |

| FINAL SURVEY NO. | BY | DATE |
|------------------|----|------|
|                  |    |      |

Last Rev. : 10-12-07 By: gdr  
 Scale : 100  
 Design File : i:\1997\97562\As-Builts\ dgn\Vol 5\Sh 1015-Mainline-rs17420Rt.dgn

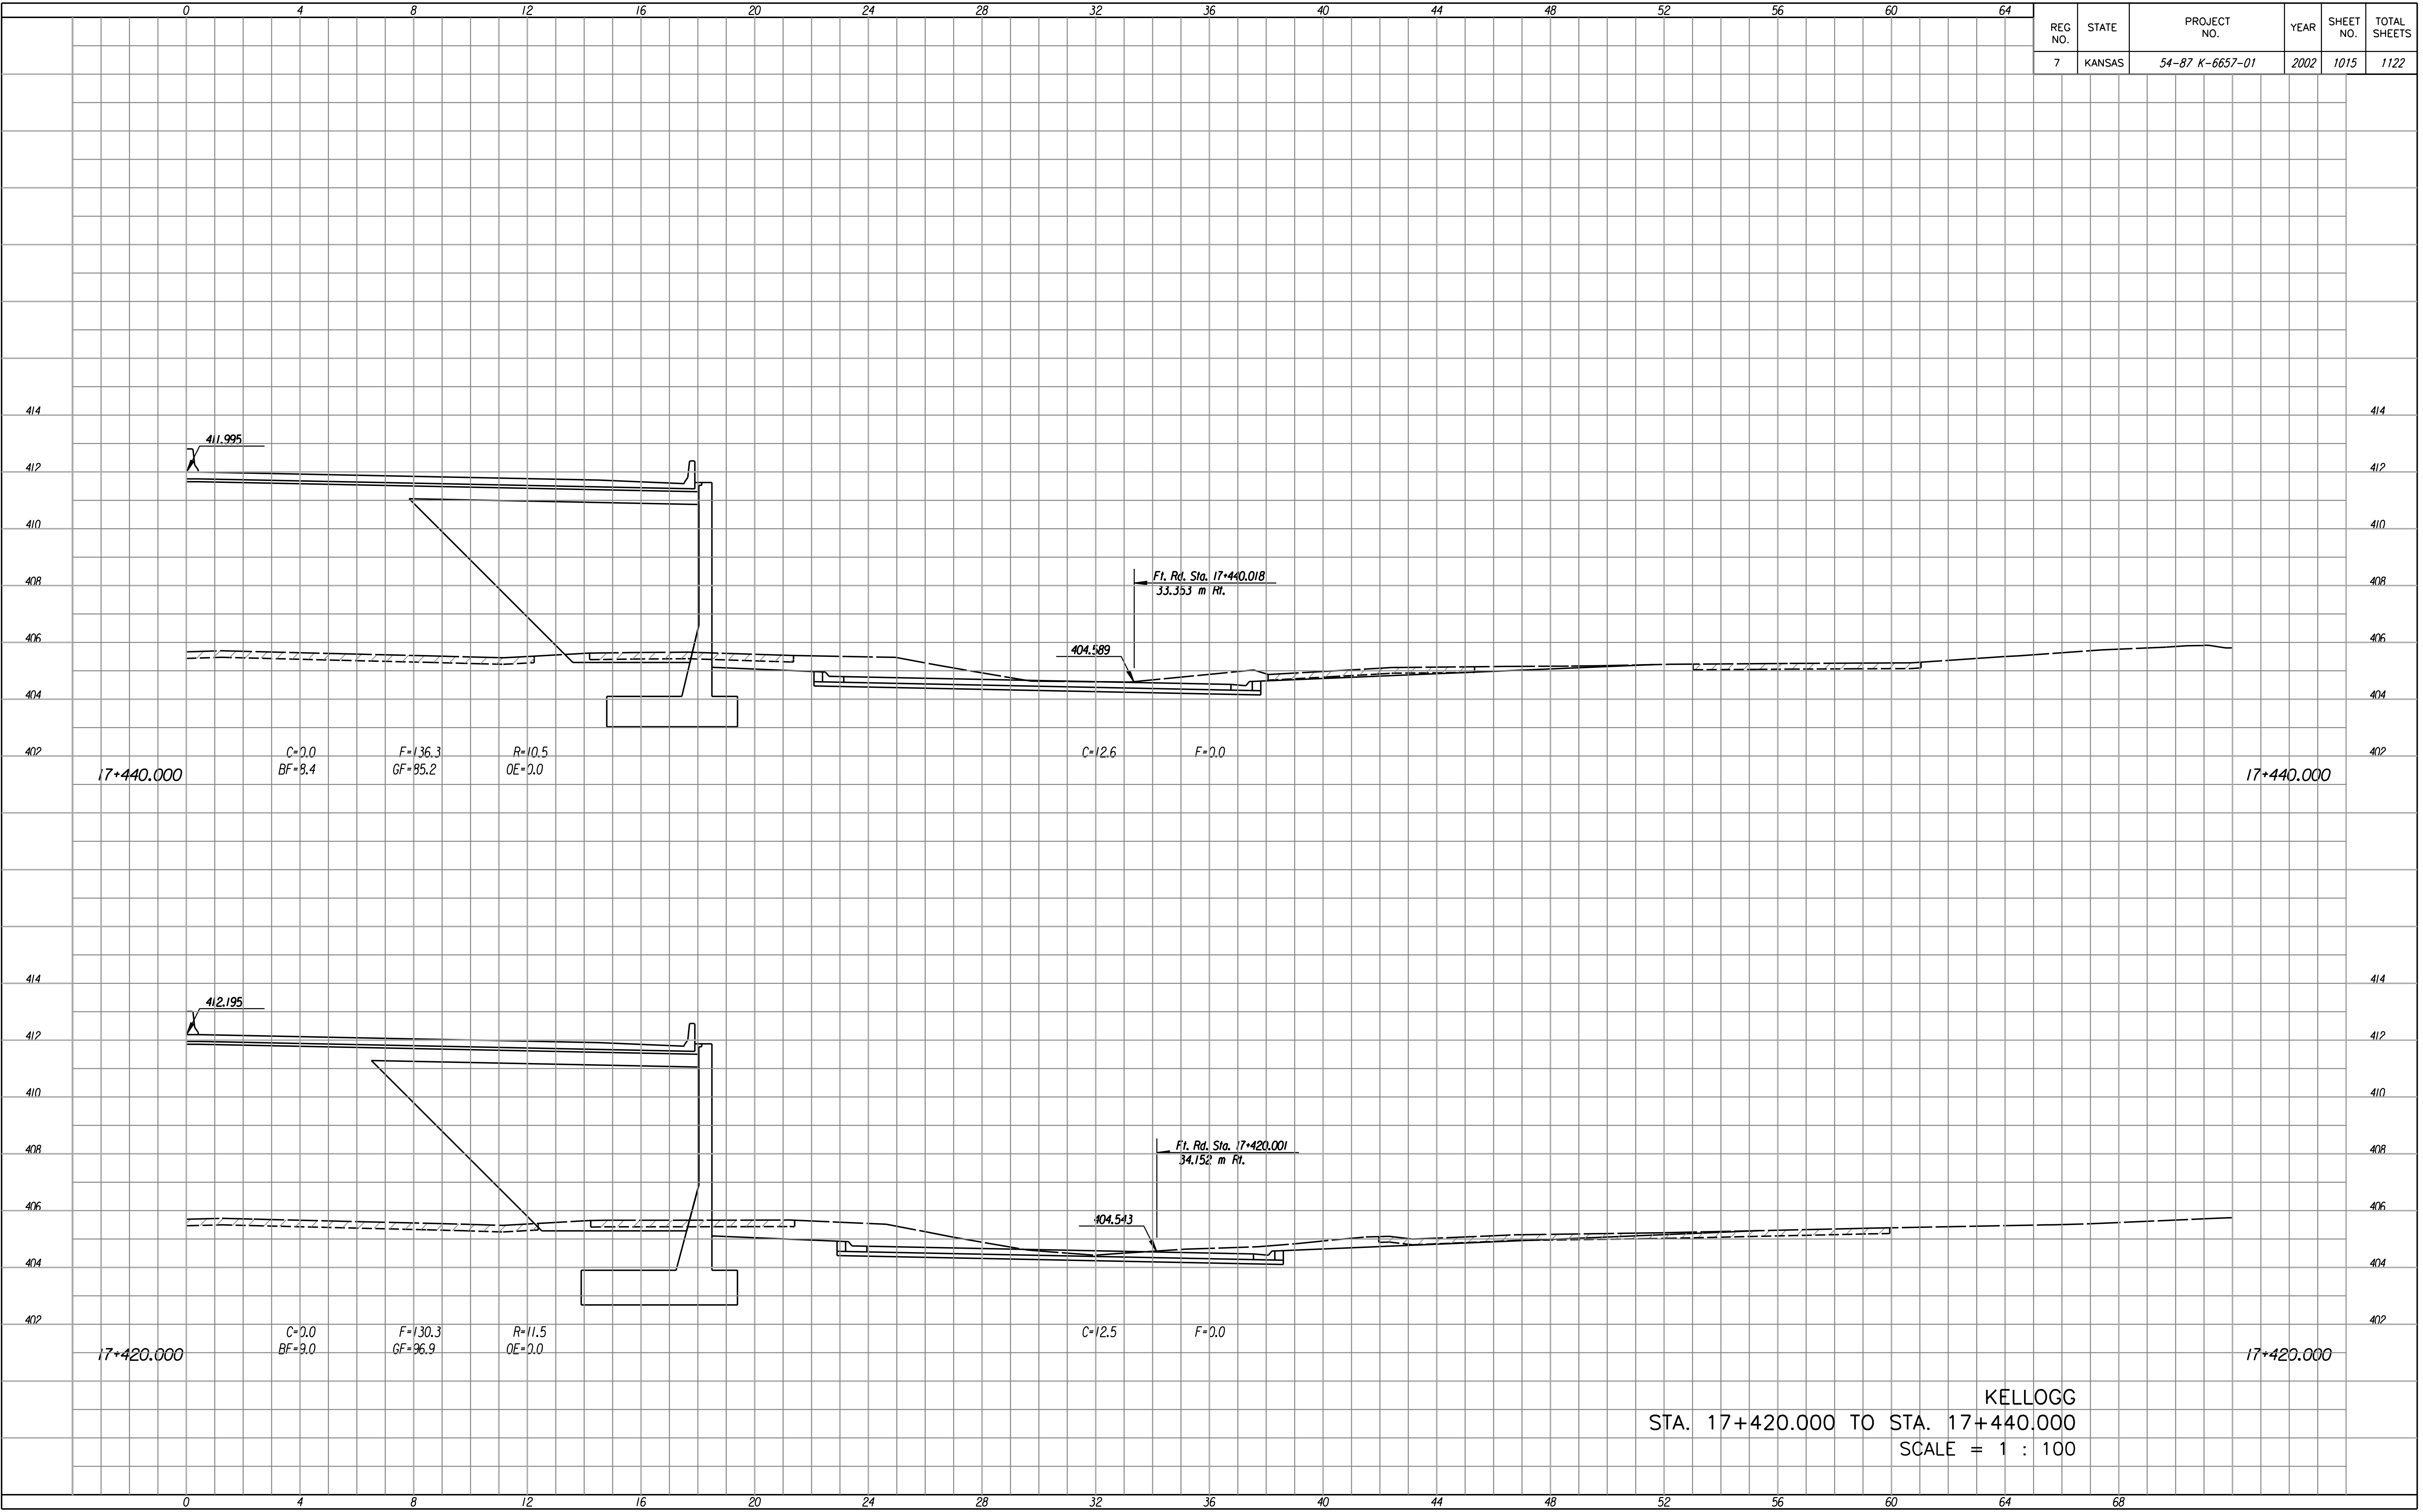

KELLOGG  
 STA. 17+420.000 TO STA. 17+440.000  
 SCALE = 1 : 100