


REG. NO.	STATE	PROJECT NO.	YEAR	SHEET NO.	TOTAL SHEETS
7	KANSAS	54-87 K-6657-01	2002	1016	1122

FINAL SURVEY NO.	BY	DATE
SURVEYED	PLOTTED	DATE
NOTE BOOK	TEMPLATE	AREAS CHECKED
NO.		

Last Rev. : 10-12-07 By: gdr
 Scale : 100
 Design File : i:\1997\97162\As-Builts\ dgn\5\Sh 1016-Mainline-rs17447L.dgn

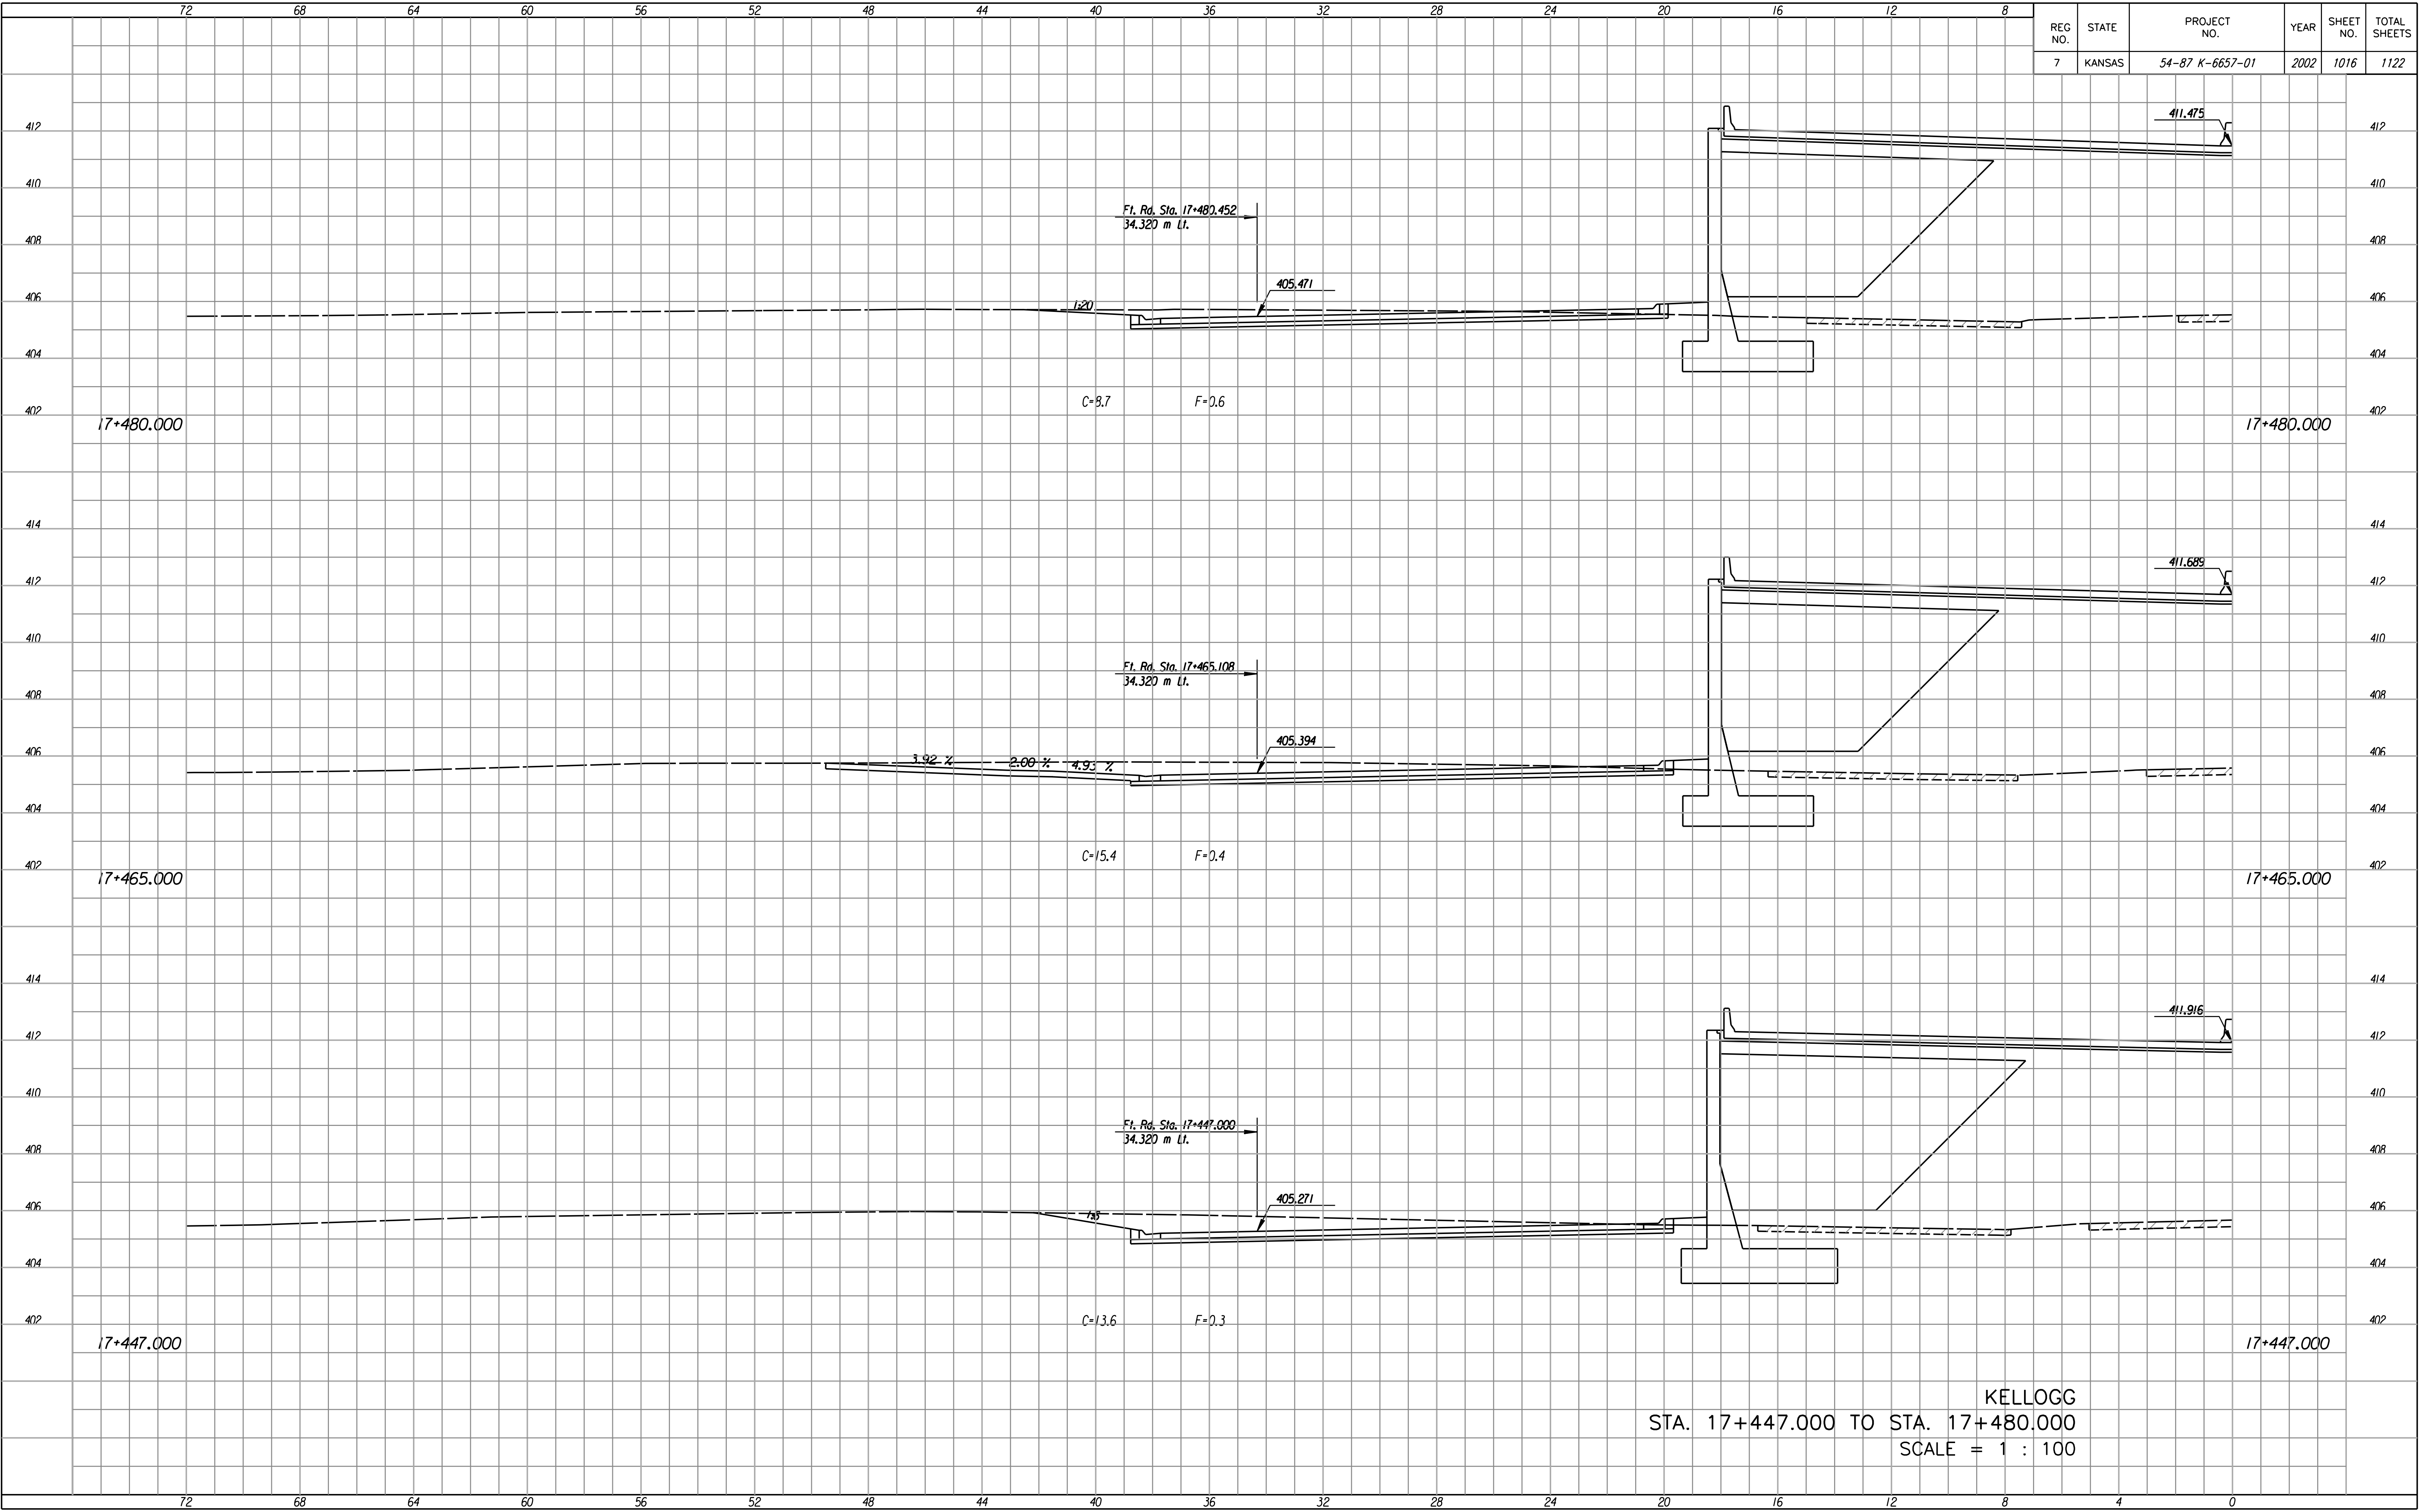

KELLOGG
 STA. 17+447.000 TO STA. 17+480.000
 SCALE = 1 : 100