


REG. NO.	STATE	PROJECT NO.	YEAR	SHEET NO.	TOTAL SHEETS
7	KANSAS	54-87 K-6657-01	2002	1020	1122

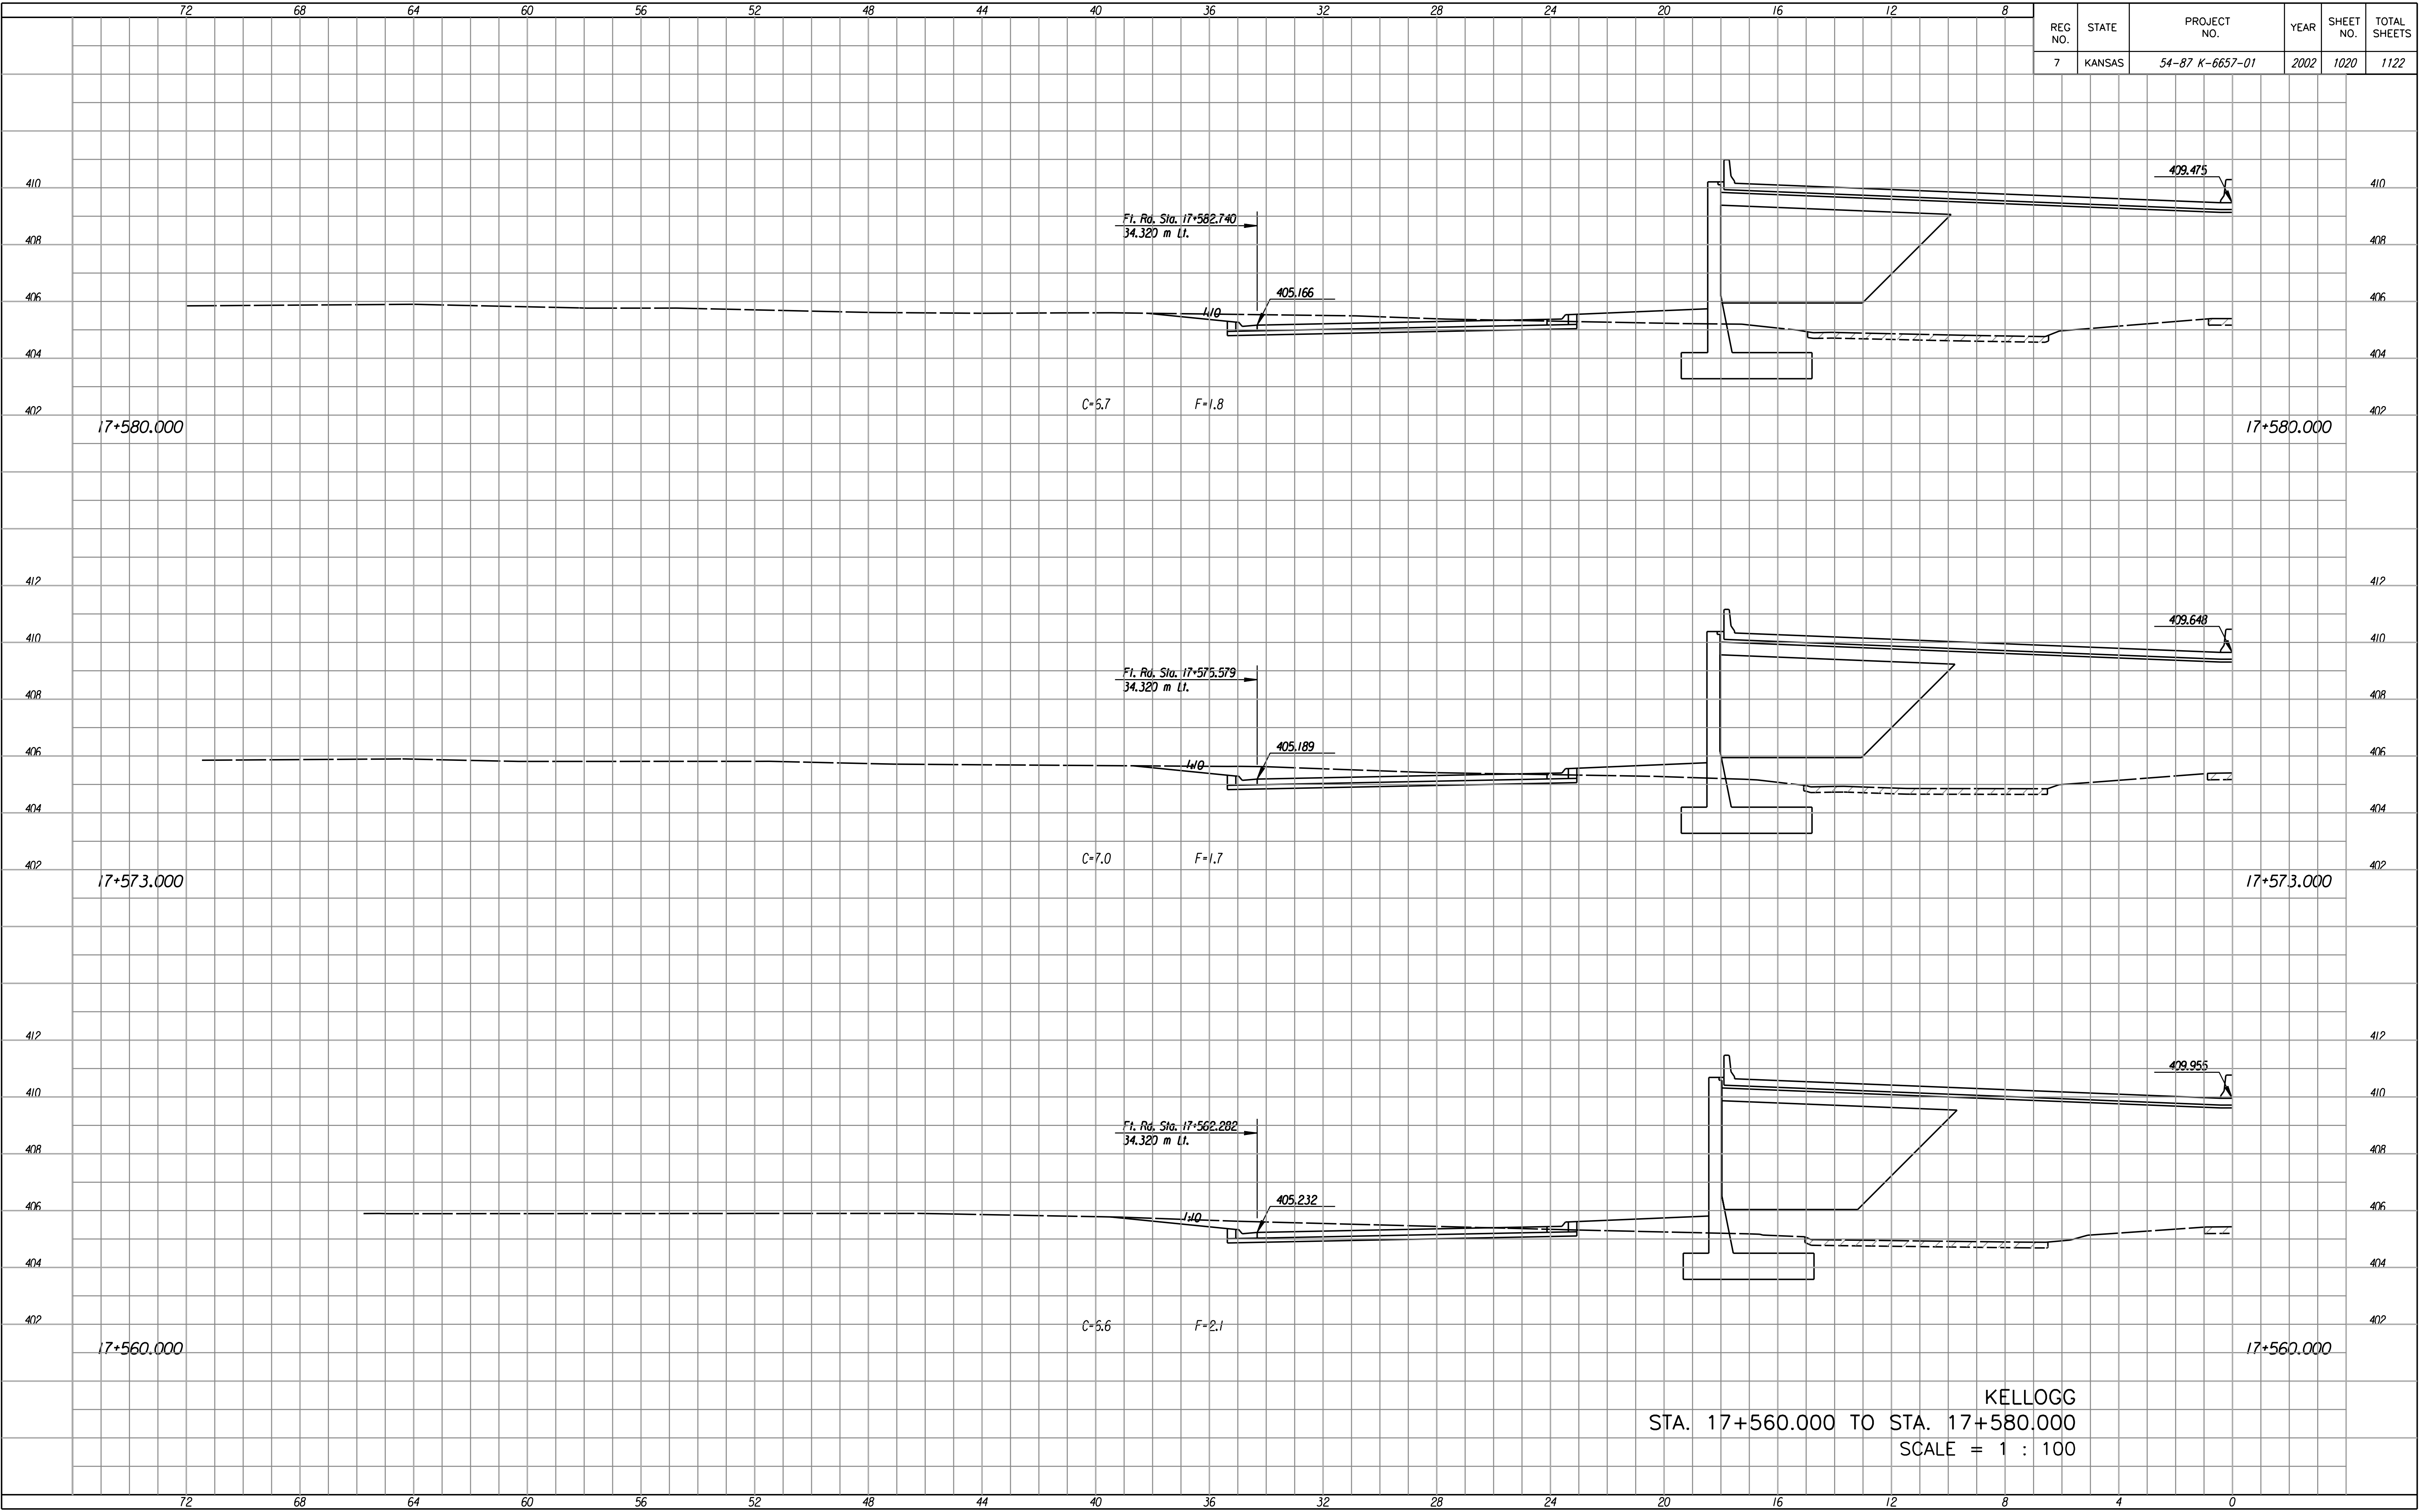

FINAL SURVEY NO.	BY	DATE
SURVEYED	PLOTTED	DATE
NOTE BOOK	TEMPLATE	AREAS CHECKED

Last Rev. : 10-12-07 By: gdr
Scale : 100
Design File : i:/1997/97662/As-Builts/dgn/s/Vol 5/Sh 1020-Mainline-xst7560L.dgn

KELLOGG
STA. 17+560.000 TO STA. 17+580.000
SCALE = 1 : 100