


REG. NO.	STATE	PROJECT NO.	YEAR	SHEET NO.	TOTAL SHEETS
7	KANSAS	54-87 K-6657-01	2002	1021	1122

FINAL SURVEY NO.	BY	DATE
SURVEYED	PLOTTED	DATE
NOTE BOOK	TEMPLATE	AREAS CHECKED
NO.		

Last Rev. : 10-12-07 By: gdr  
Scale : 100  
Design File : i:\1997\97162\As-Builts\ dgn\Vol 5\Sh 1021-Mainline-xst560Rt.dgn

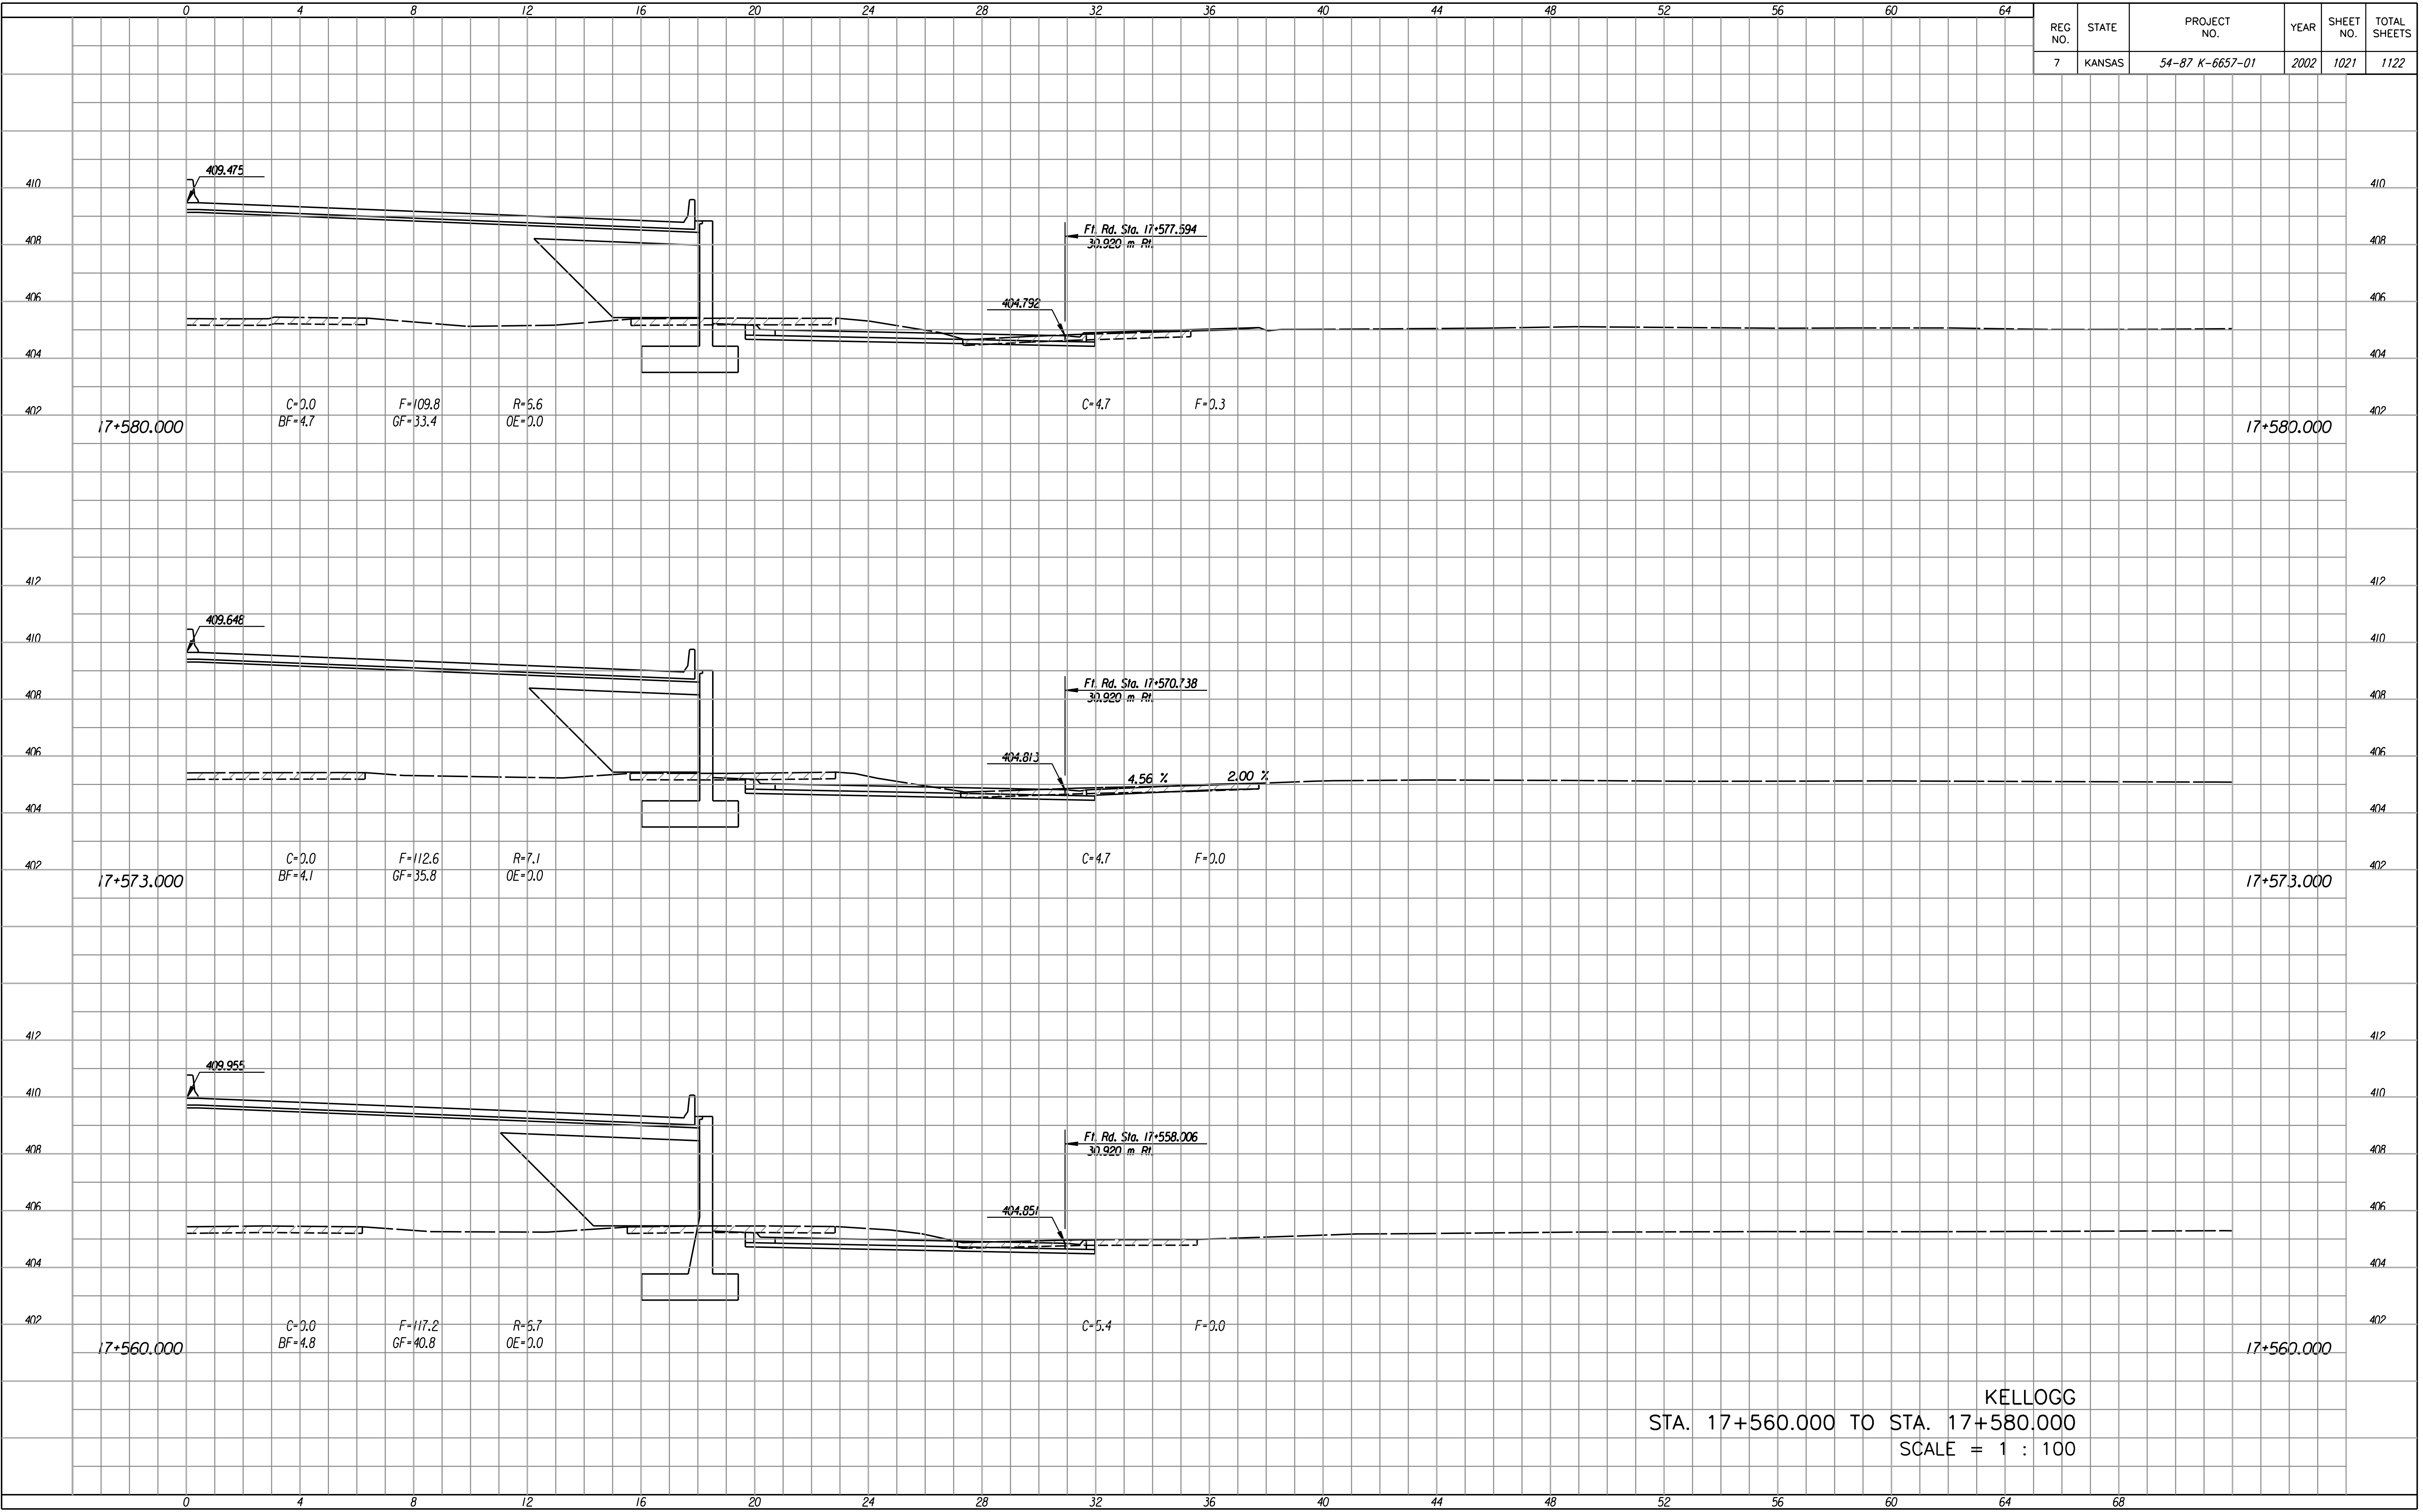

KELLOGG  
STA. 17+560.000 TO STA. 17+580.000  
SCALE = 1 : 100