


REG. NO.	STATE	PROJECT NO.	YEAR	SHEET NO.	TOTAL SHEETS
7	KANSAS	54-87 K-6657-01	2002	1025	1122

FINAL SURVEY NO.	BY	DATE
NO. OF AREAS CHECKED	PLOTTED	DATE
NO. OF AREAS CHECKED	TEMPLATE	DATE
NO. OF AREAS CHECKED	AREAS CHECKED	DATE

Last Rev. : 10-12-07 By: gdr
 Scale : 100
 Design File : i:/1997/97162/As-Builts/dgn/s/1025-Mainline-xst7634Rt.dgn

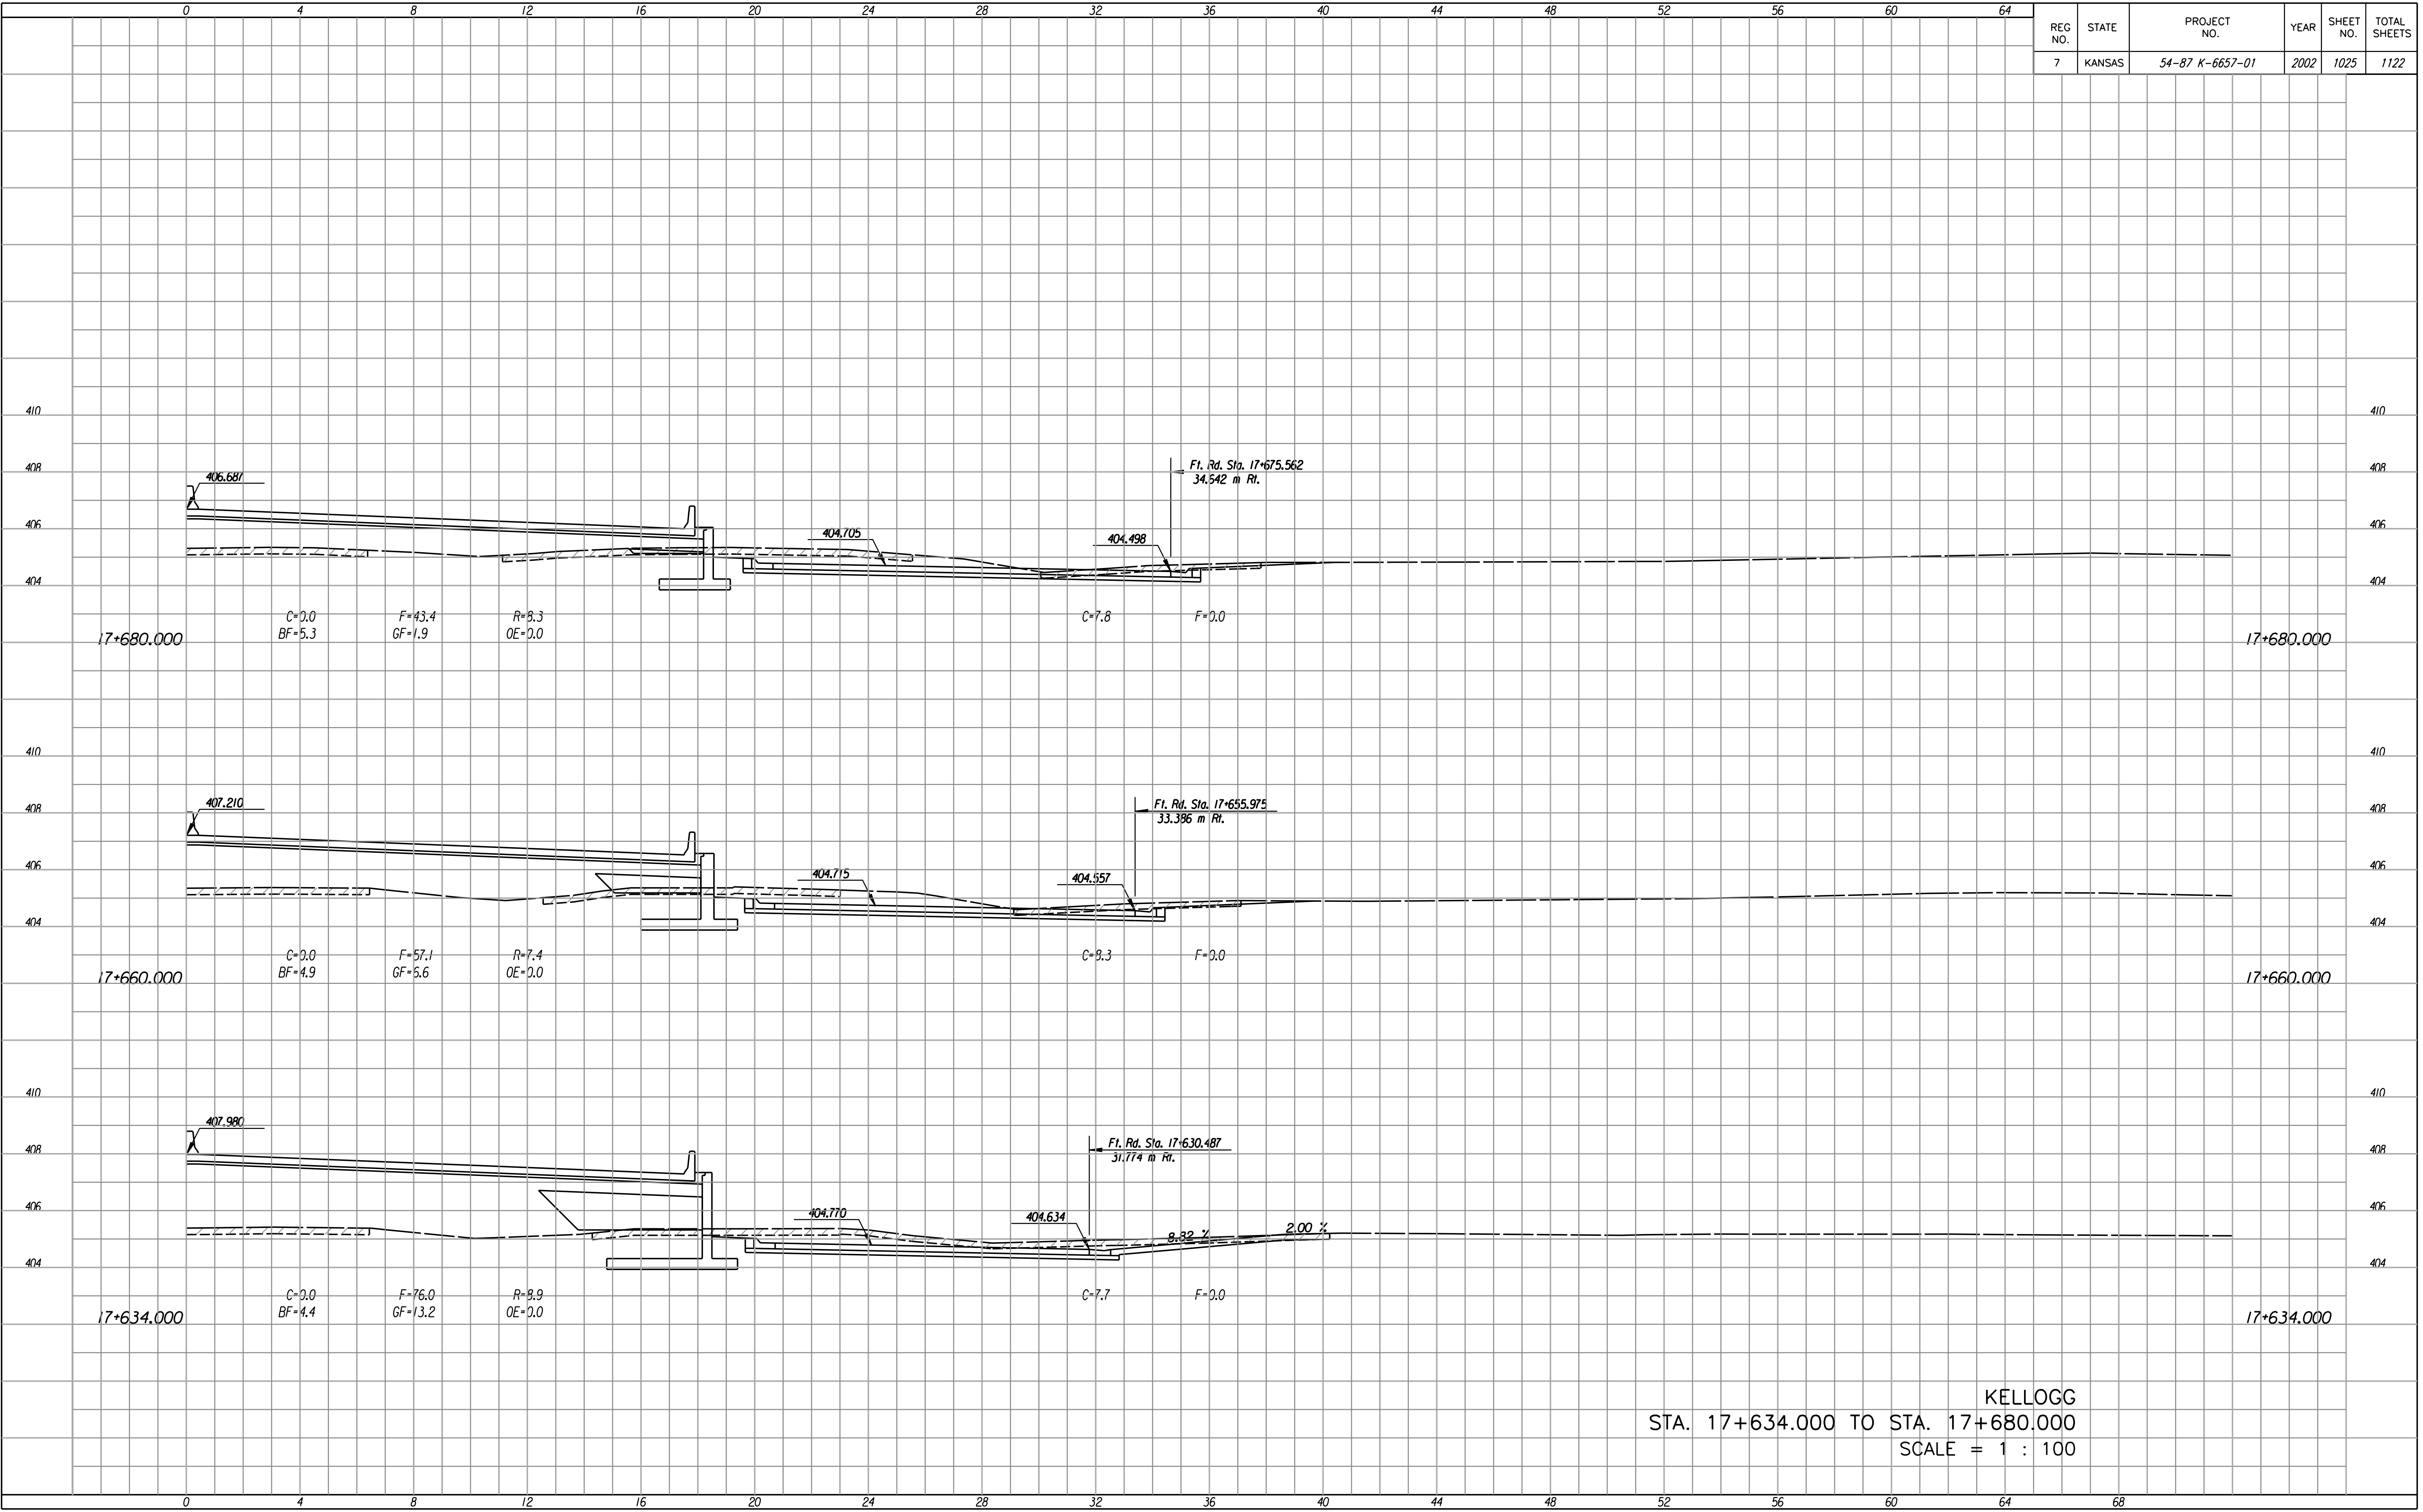

KELLOGG
 STA. 17+634.000 TO STA. 17+680.000
 SCALE = 1 : 100