


REG. NO.	STATE	PROJECT NO.	YEAR	SHEET NO.	TOTAL SHEETS
7	KANSAS	54-87 K-6657-01	2002	1031	1122

FINAL SURVEY NO.	DATE
SURVEYED BY	
PLOTTED BY	
TEMPLATE AREAS CHECKED	
NO.	

Last Rev. : 10-12-07 By: gdr
 Scale : 100
 Design File : i:\1997\97662\As-Builts\ dgn\Vol 5\Sh 1031-Mainline-rs17803Rt.dgn

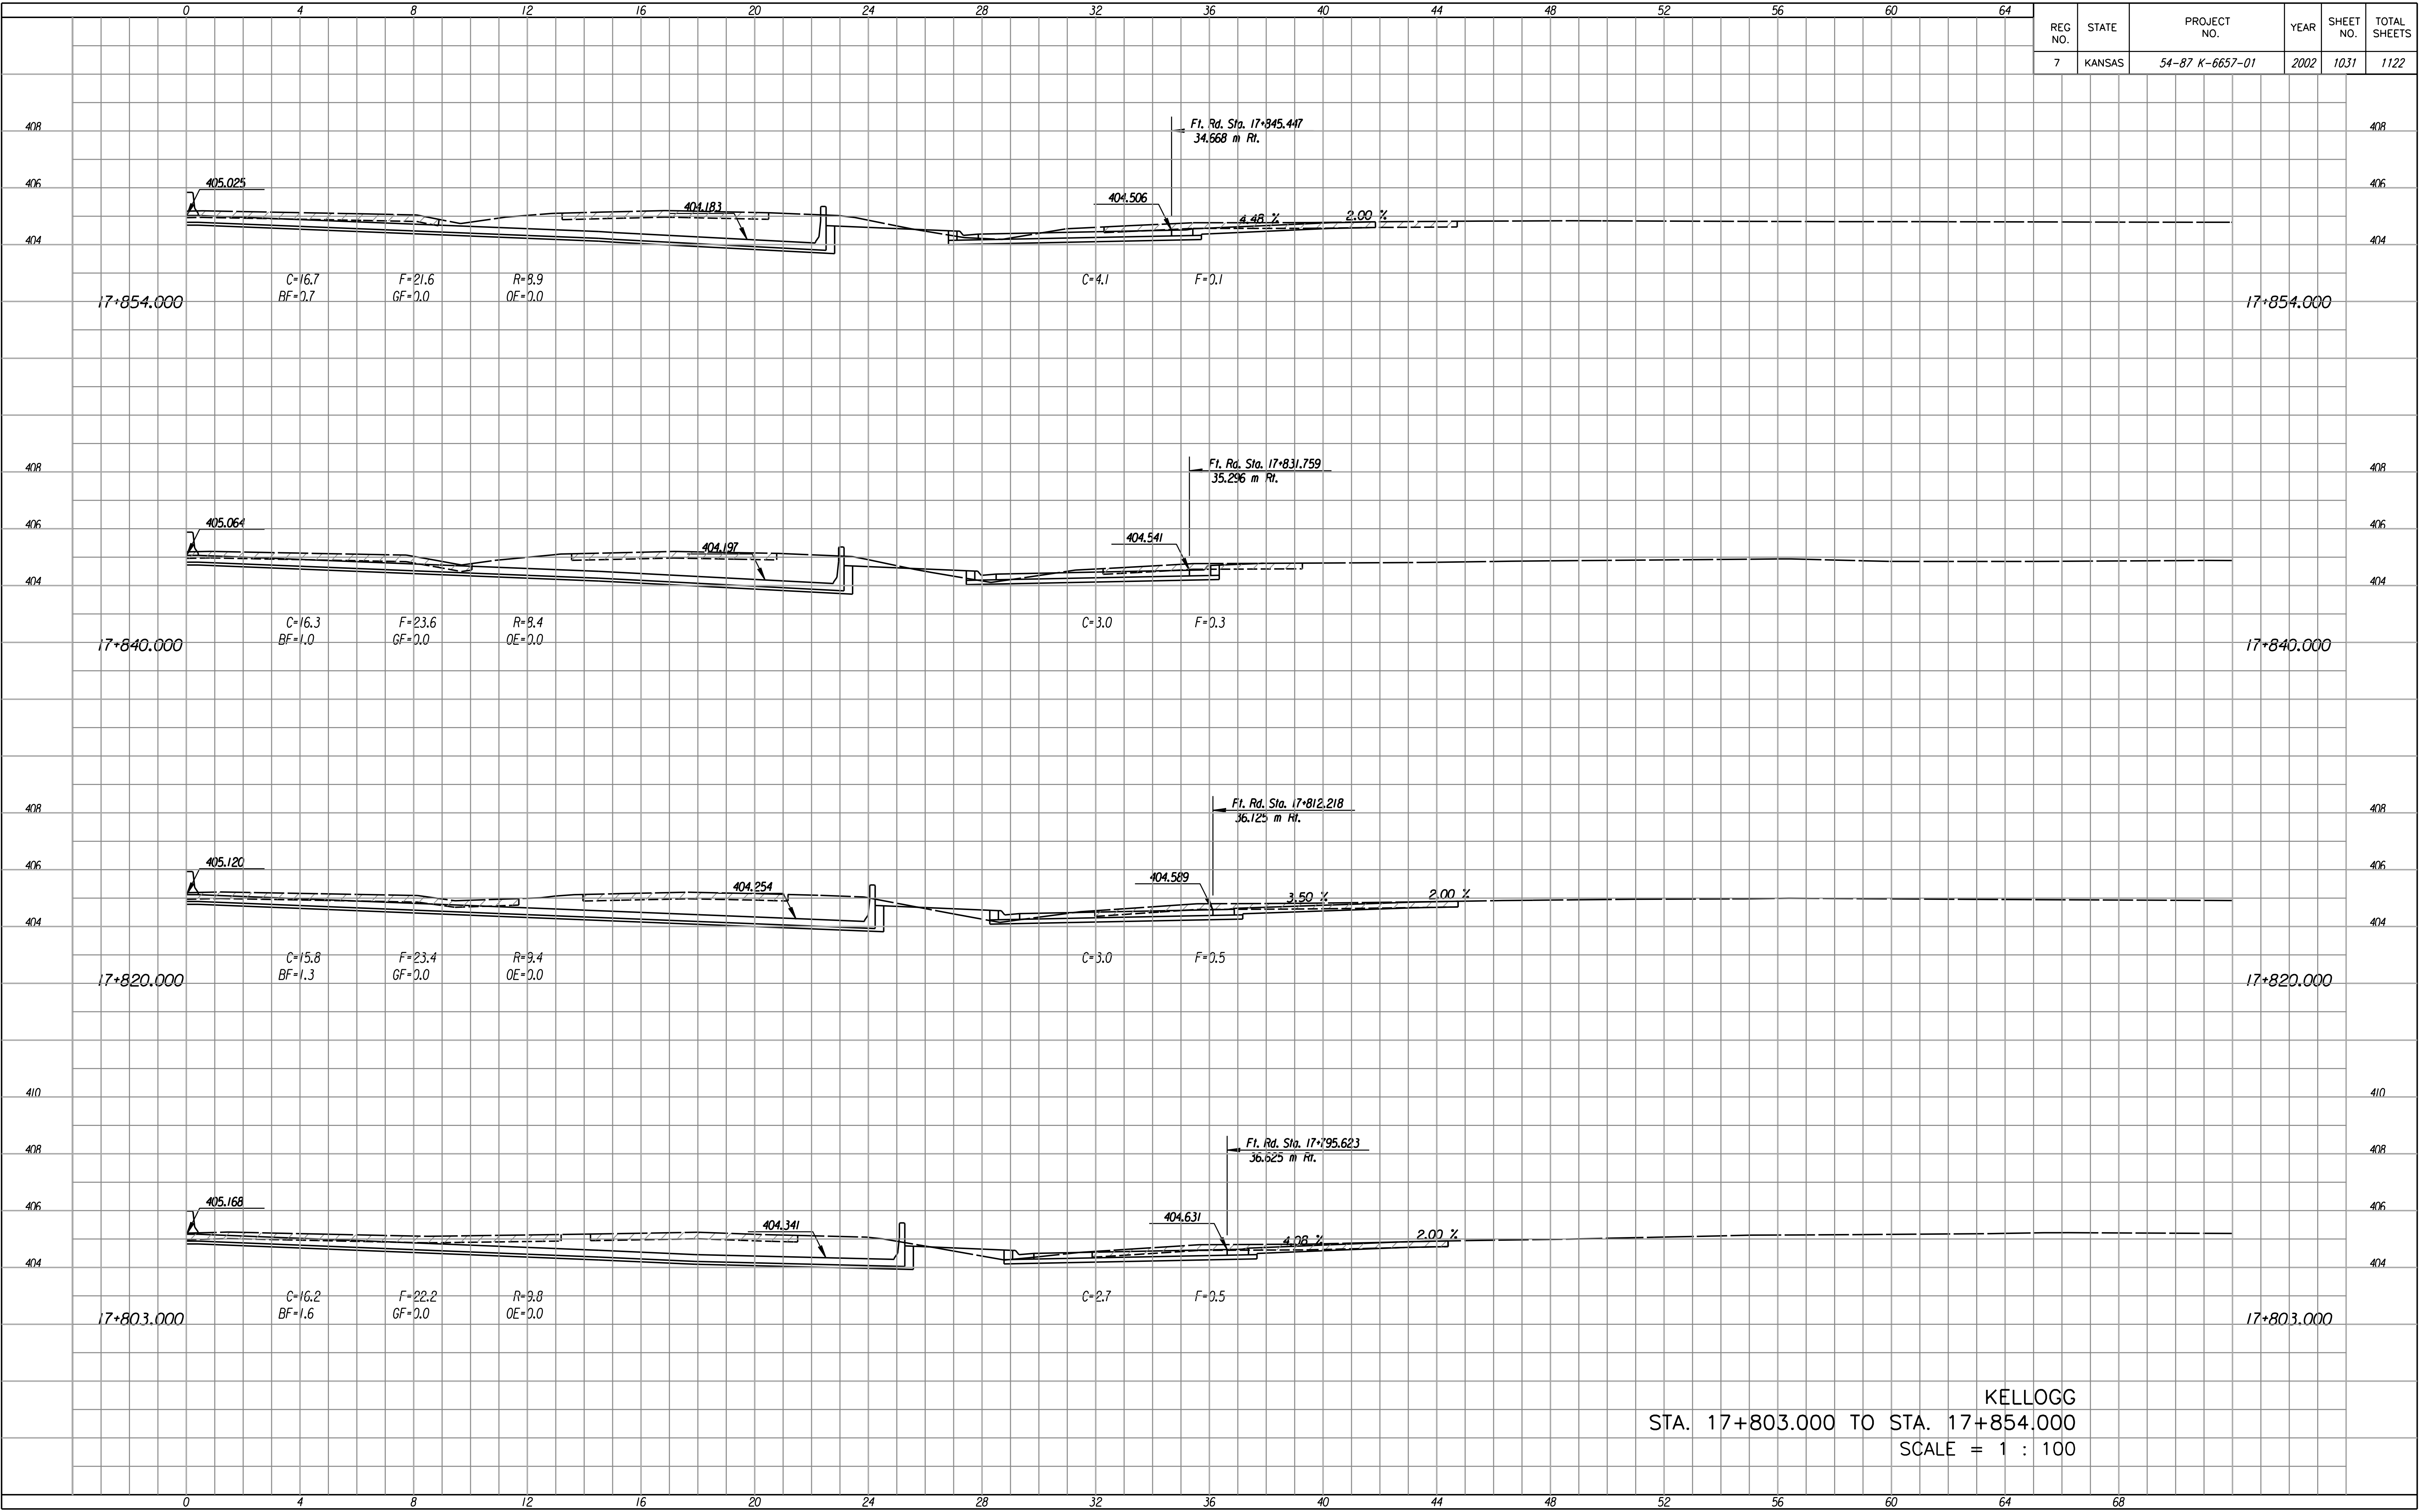

KELLOGG
 STA. 17+803.000 TO STA. 17+854.000
 SCALE = 1 : 100