


REG. NO.	STATE	PROJECT NO.	YEAR	SHEET NO.	TOTAL SHEETS
7	KANSAS	54-87 K-6657-01	2002	1034	1122

FINAL SURVEY NO.	DATE
SURVEYED BY	
PLOTTED BY	
TEMPLATE AREAS CHECKED	
NO.	

Last Rev. : 10-12-07 By: gdr
 Scale : 100
 Design File : i:\1997\97562\As-Builts\dgn\vol 5\sh 1034-Mainline-xst9201.dgn

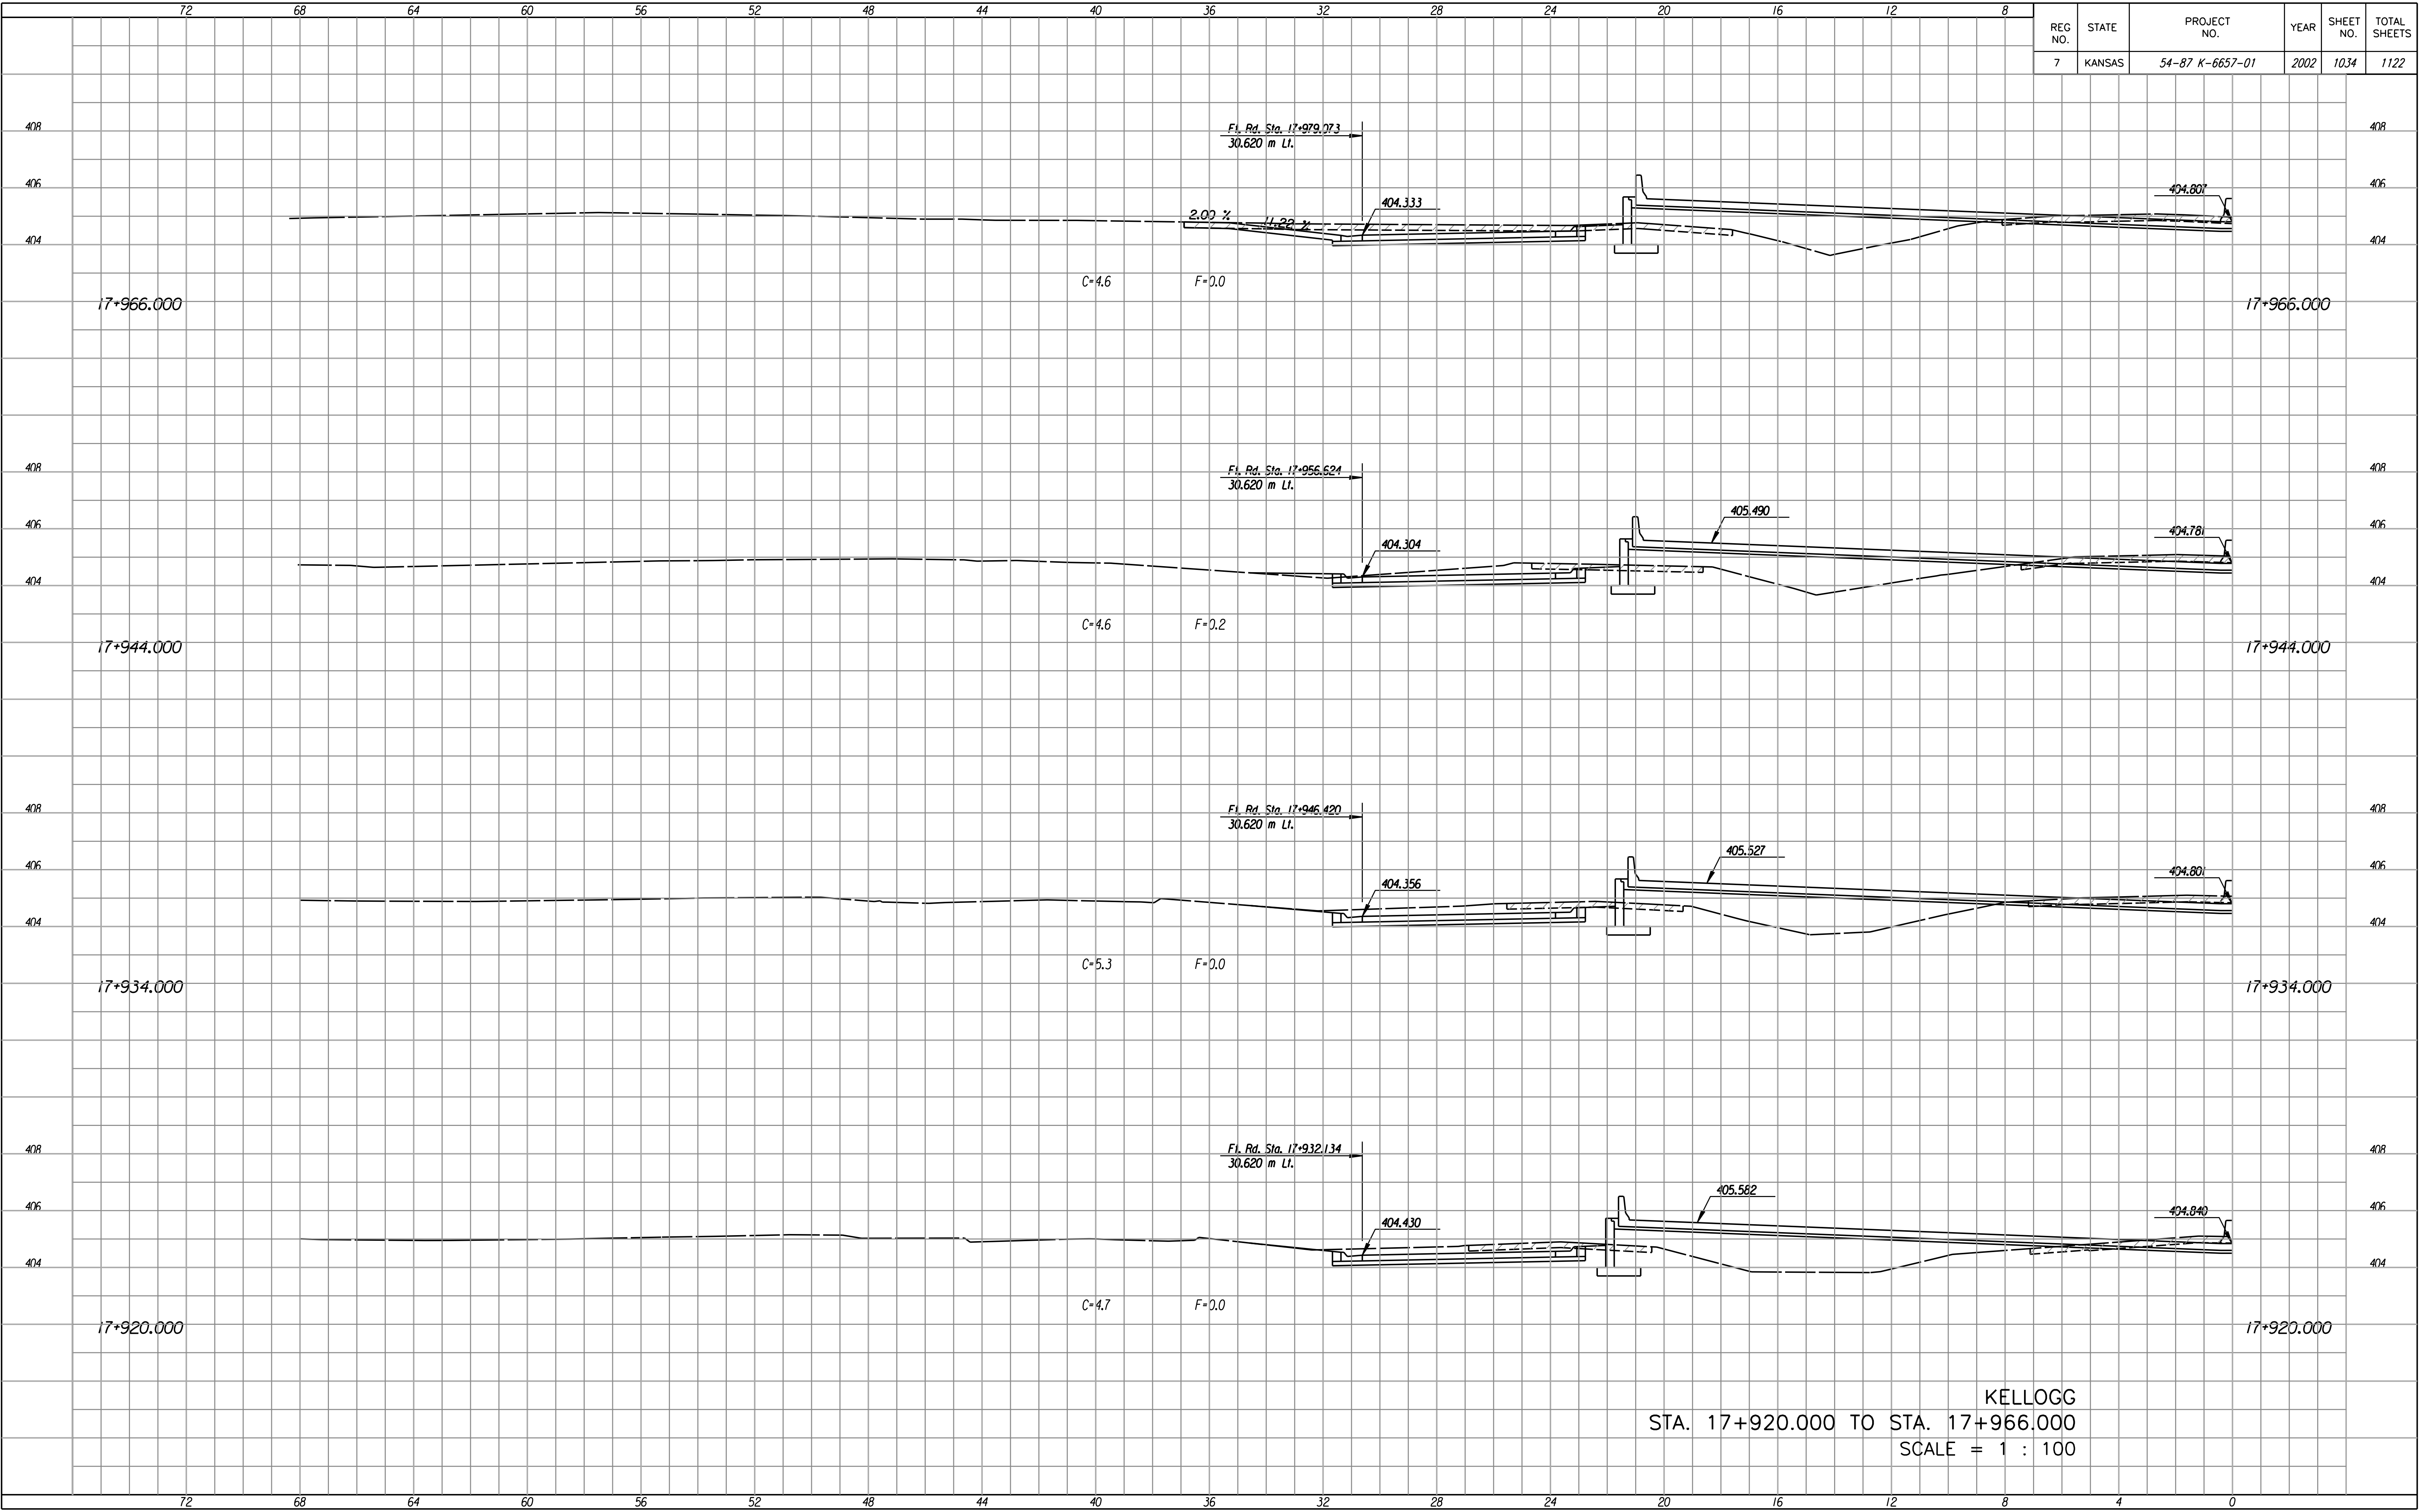

KELLOGG
 STA. 17+920.000 TO STA. 17+966.000
 SCALE = 1 : 100