


REG. NO.	STATE	PROJECT NO.	YEAR	SHEET NO.	TOTAL SHEETS
7	KANSAS	54-87 K-6657-01	2002	1036	1122

FINAL SURVEY NO.	BY	DATE
SURVEYED AREAS	PLOTTED AREAS	TEMPLE AREAS
NO.	CHECKED	

Last Rev. : 10-12-07 By: gdr
 Scale : 100
 Design File : i:\1997\97562\As-Builts\ dgn\5/5h 1036-Mainline-rs179801.dgn

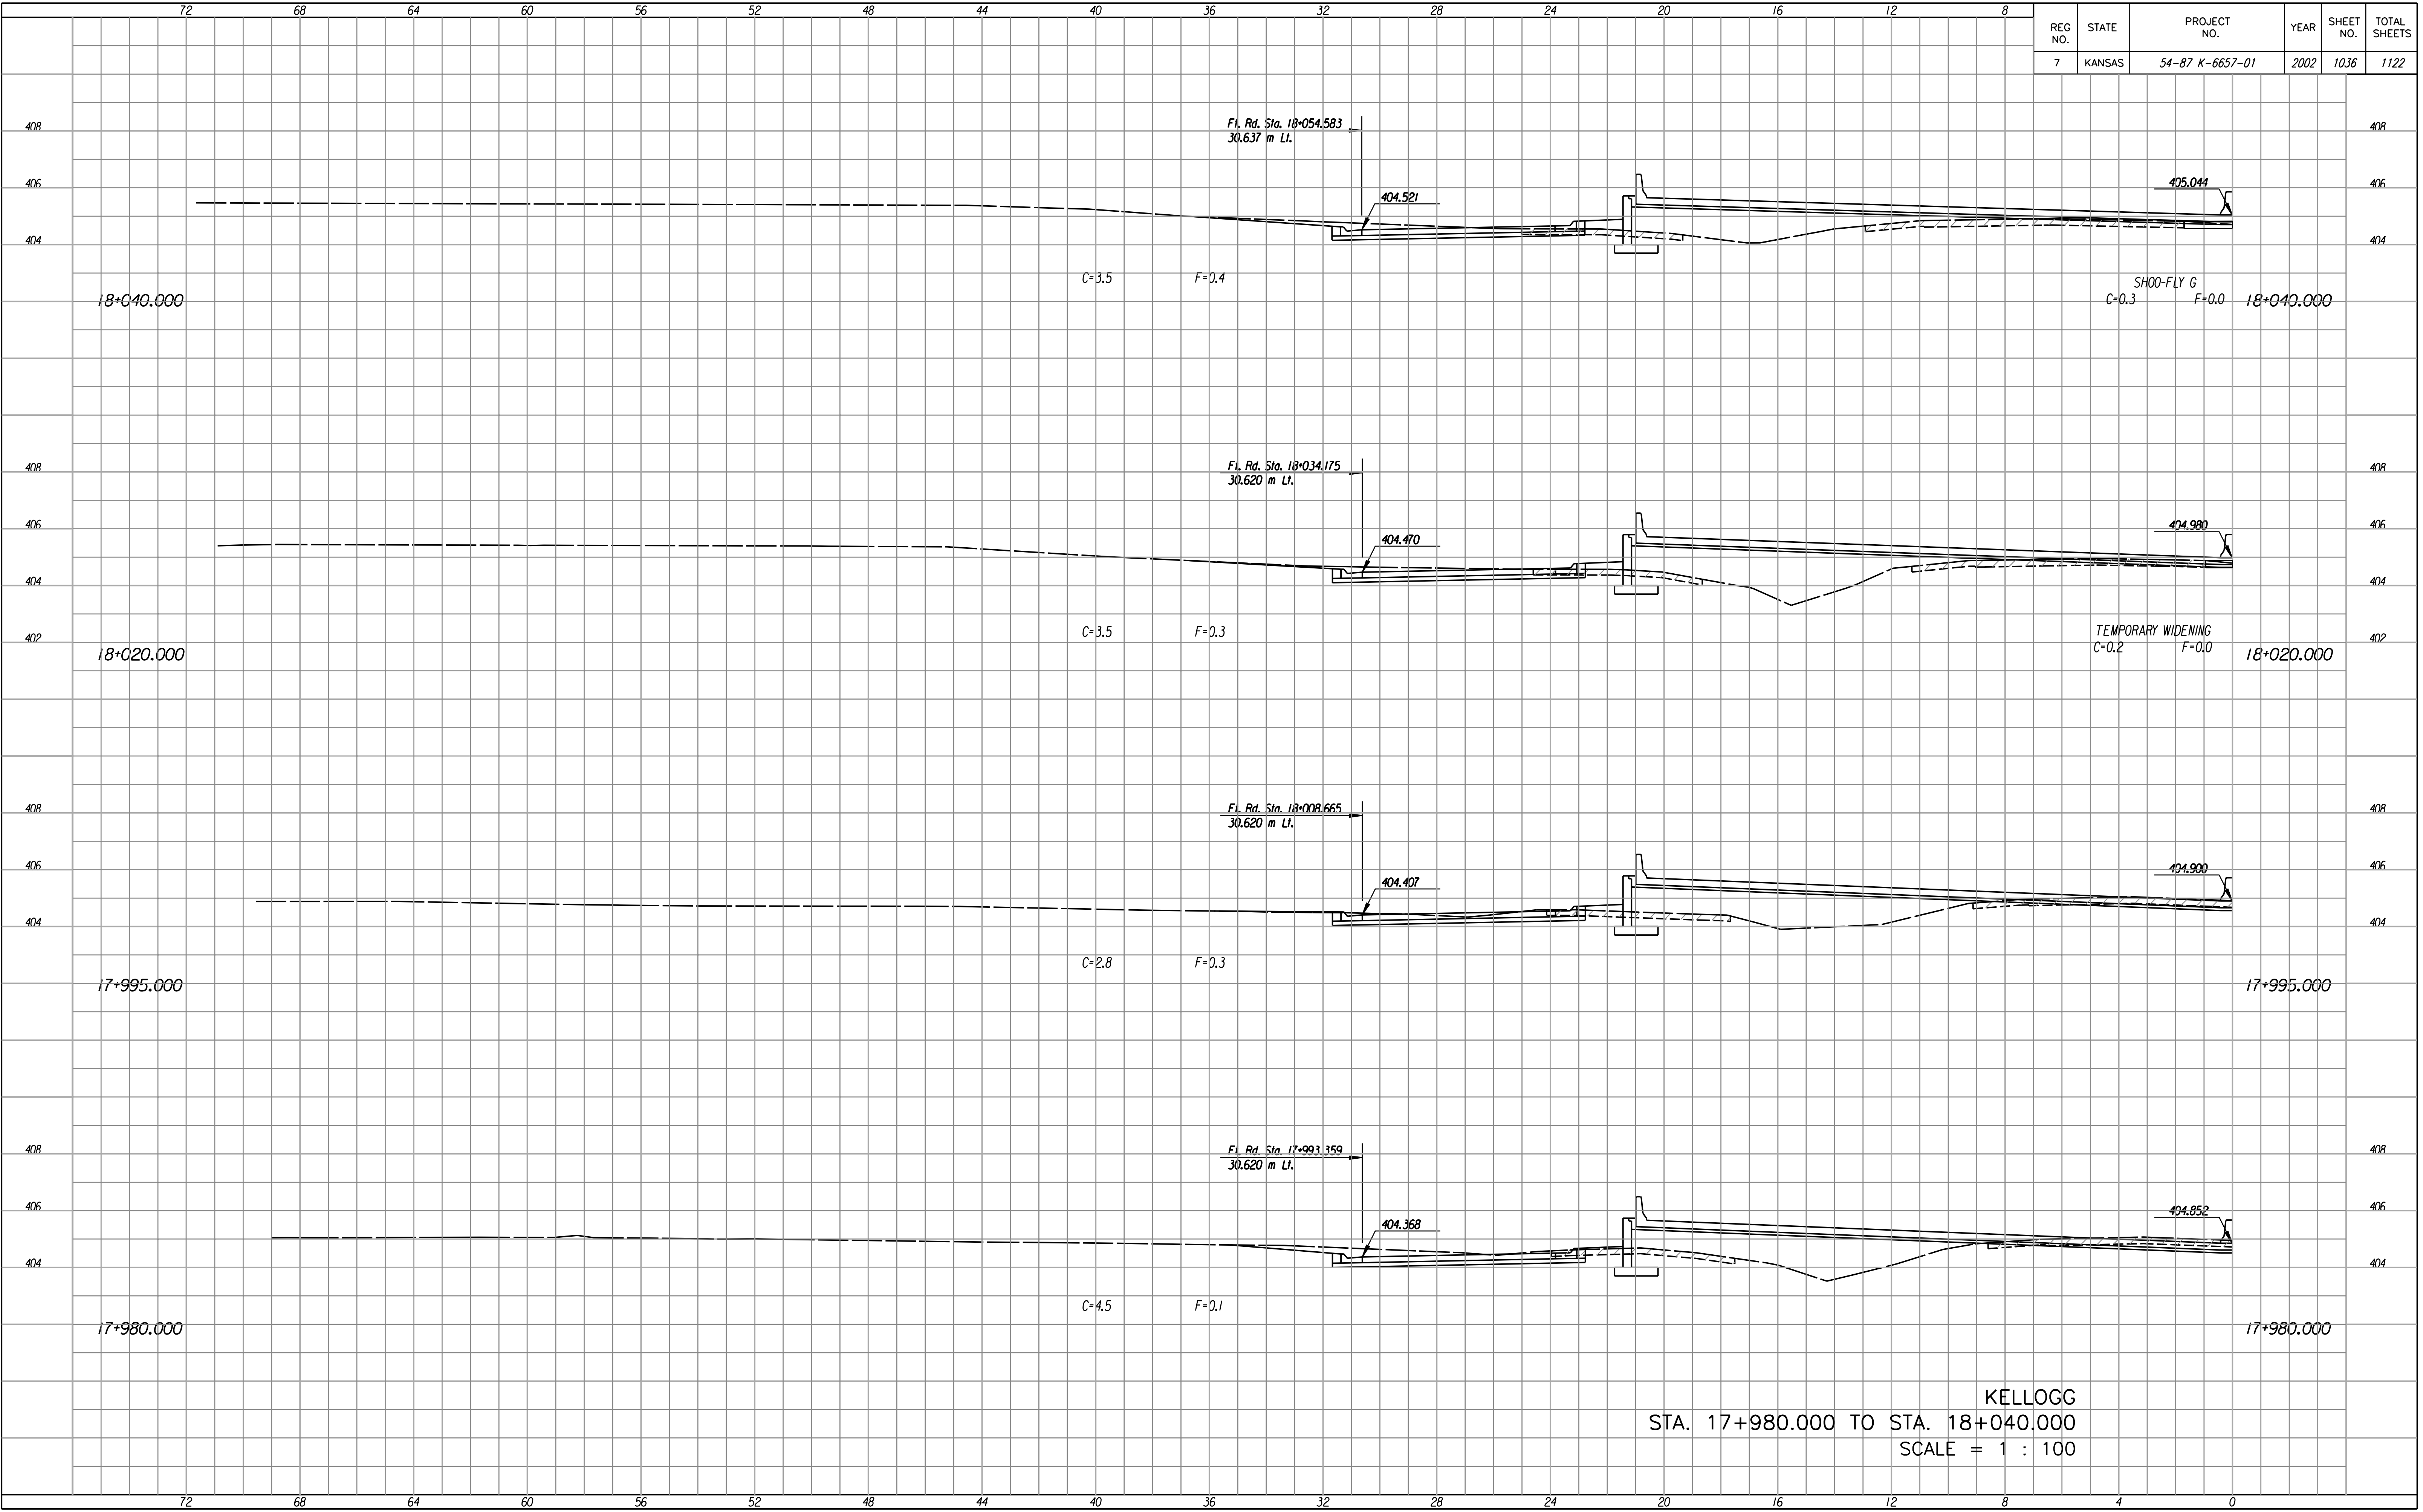

KELLOGG
 STA. 17+980.000 TO STA. 18+040.000
 SCALE = 1 : 100