


REG. NO.	STATE	PROJECT NO.	YEAR	SHEET NO.	TOTAL SHEETS
7	KANSAS	54-87 K-6657-01	2002	1039	1122

FINAL SURVEY NO.	DATE
SURVEYED BY	
PLOTTED BY	
TEMPLATE AREAS CHECKED	
NO. AREAS CHECKED	

Last Rev. : 10-12-07 By: gdr  
 Scale : 100  
 Design File : i:\1997\97162\As-Builts\ dgn\Vol 5\Sh 1039 - Mainline - xs 1039001.dgn

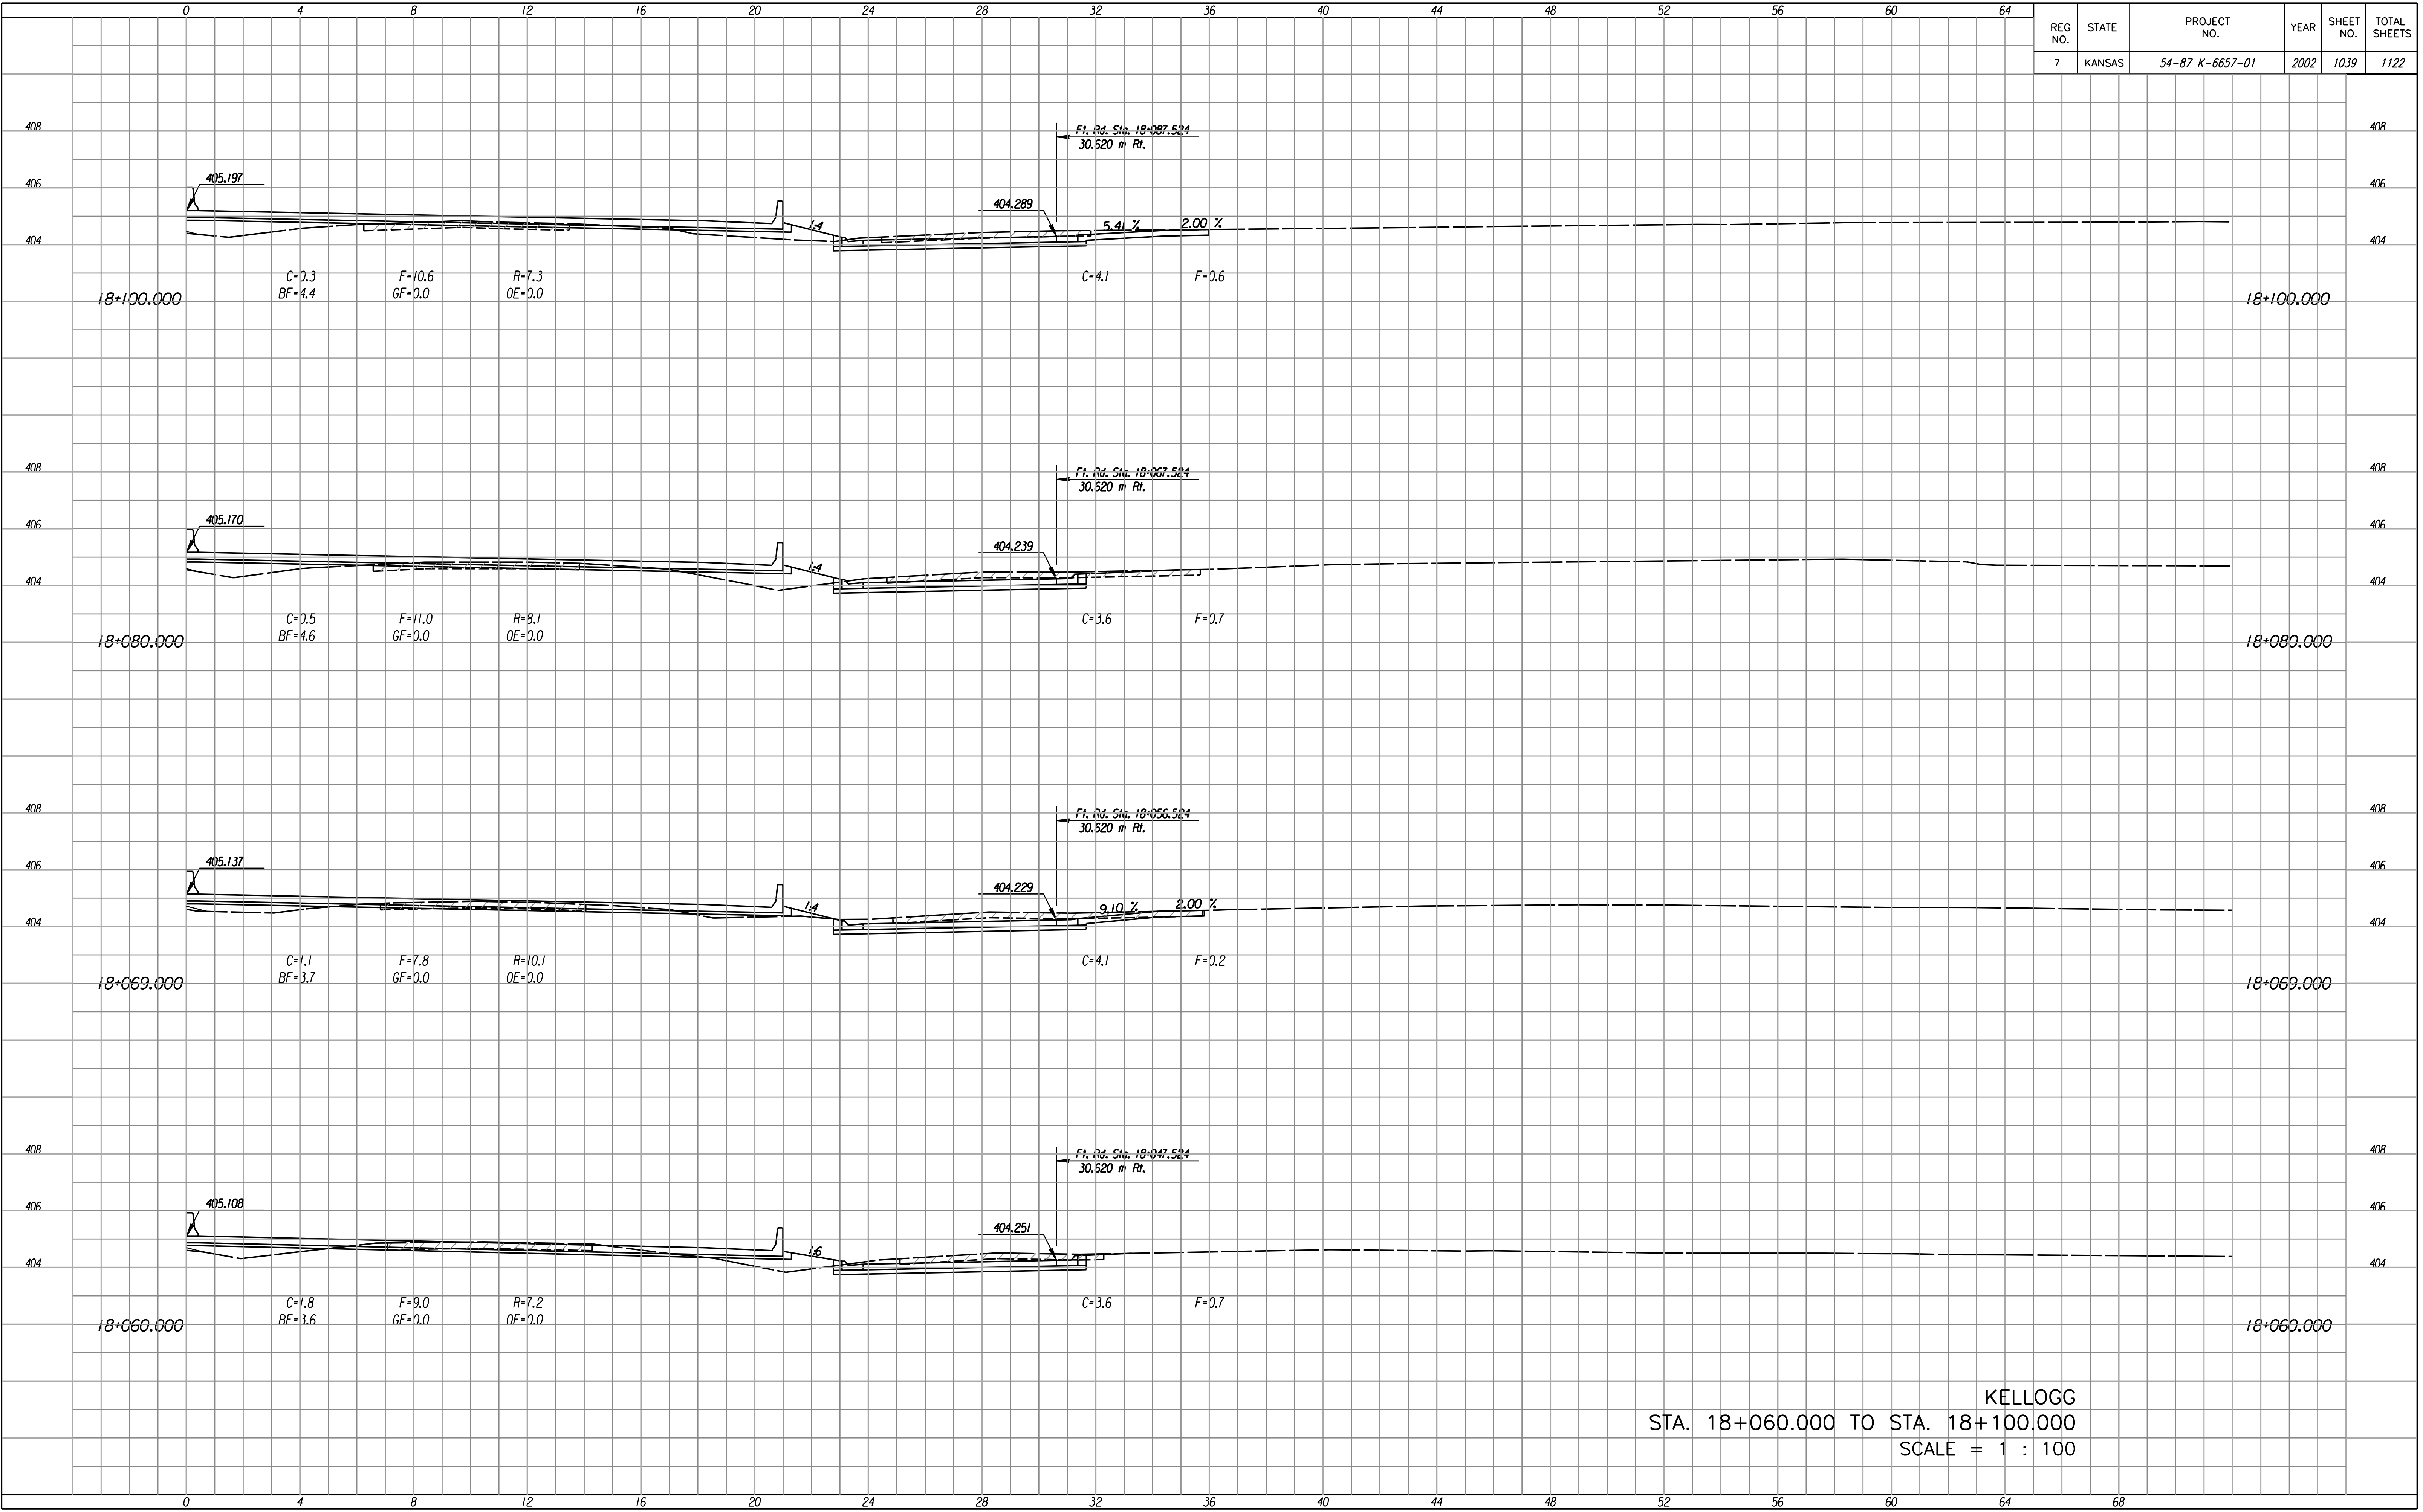

KELLOGG  
 STA. 18+060.000 TO STA. 18+100.000  
 SCALE = 1 : 100