


REG. NO.	STATE	PROJECT NO.	YEAR	SHEET NO.	TOTAL SHEETS
7	KANSAS	54-87 K-6657-01	2002	1043	1122

FINAL SURVEY NO.	DATE
SURVEYED BY	DATE
PLOTTED BY	DATE
TEMPLATE AREAS CHECKED	DATE

Last Rev. : 10-12-07 By: gdr
 Scale : 100
 Design File : i:\1997\97662\As-Builts\ dgn\5/5h 1043-Mainline-xy182000r1.dgn

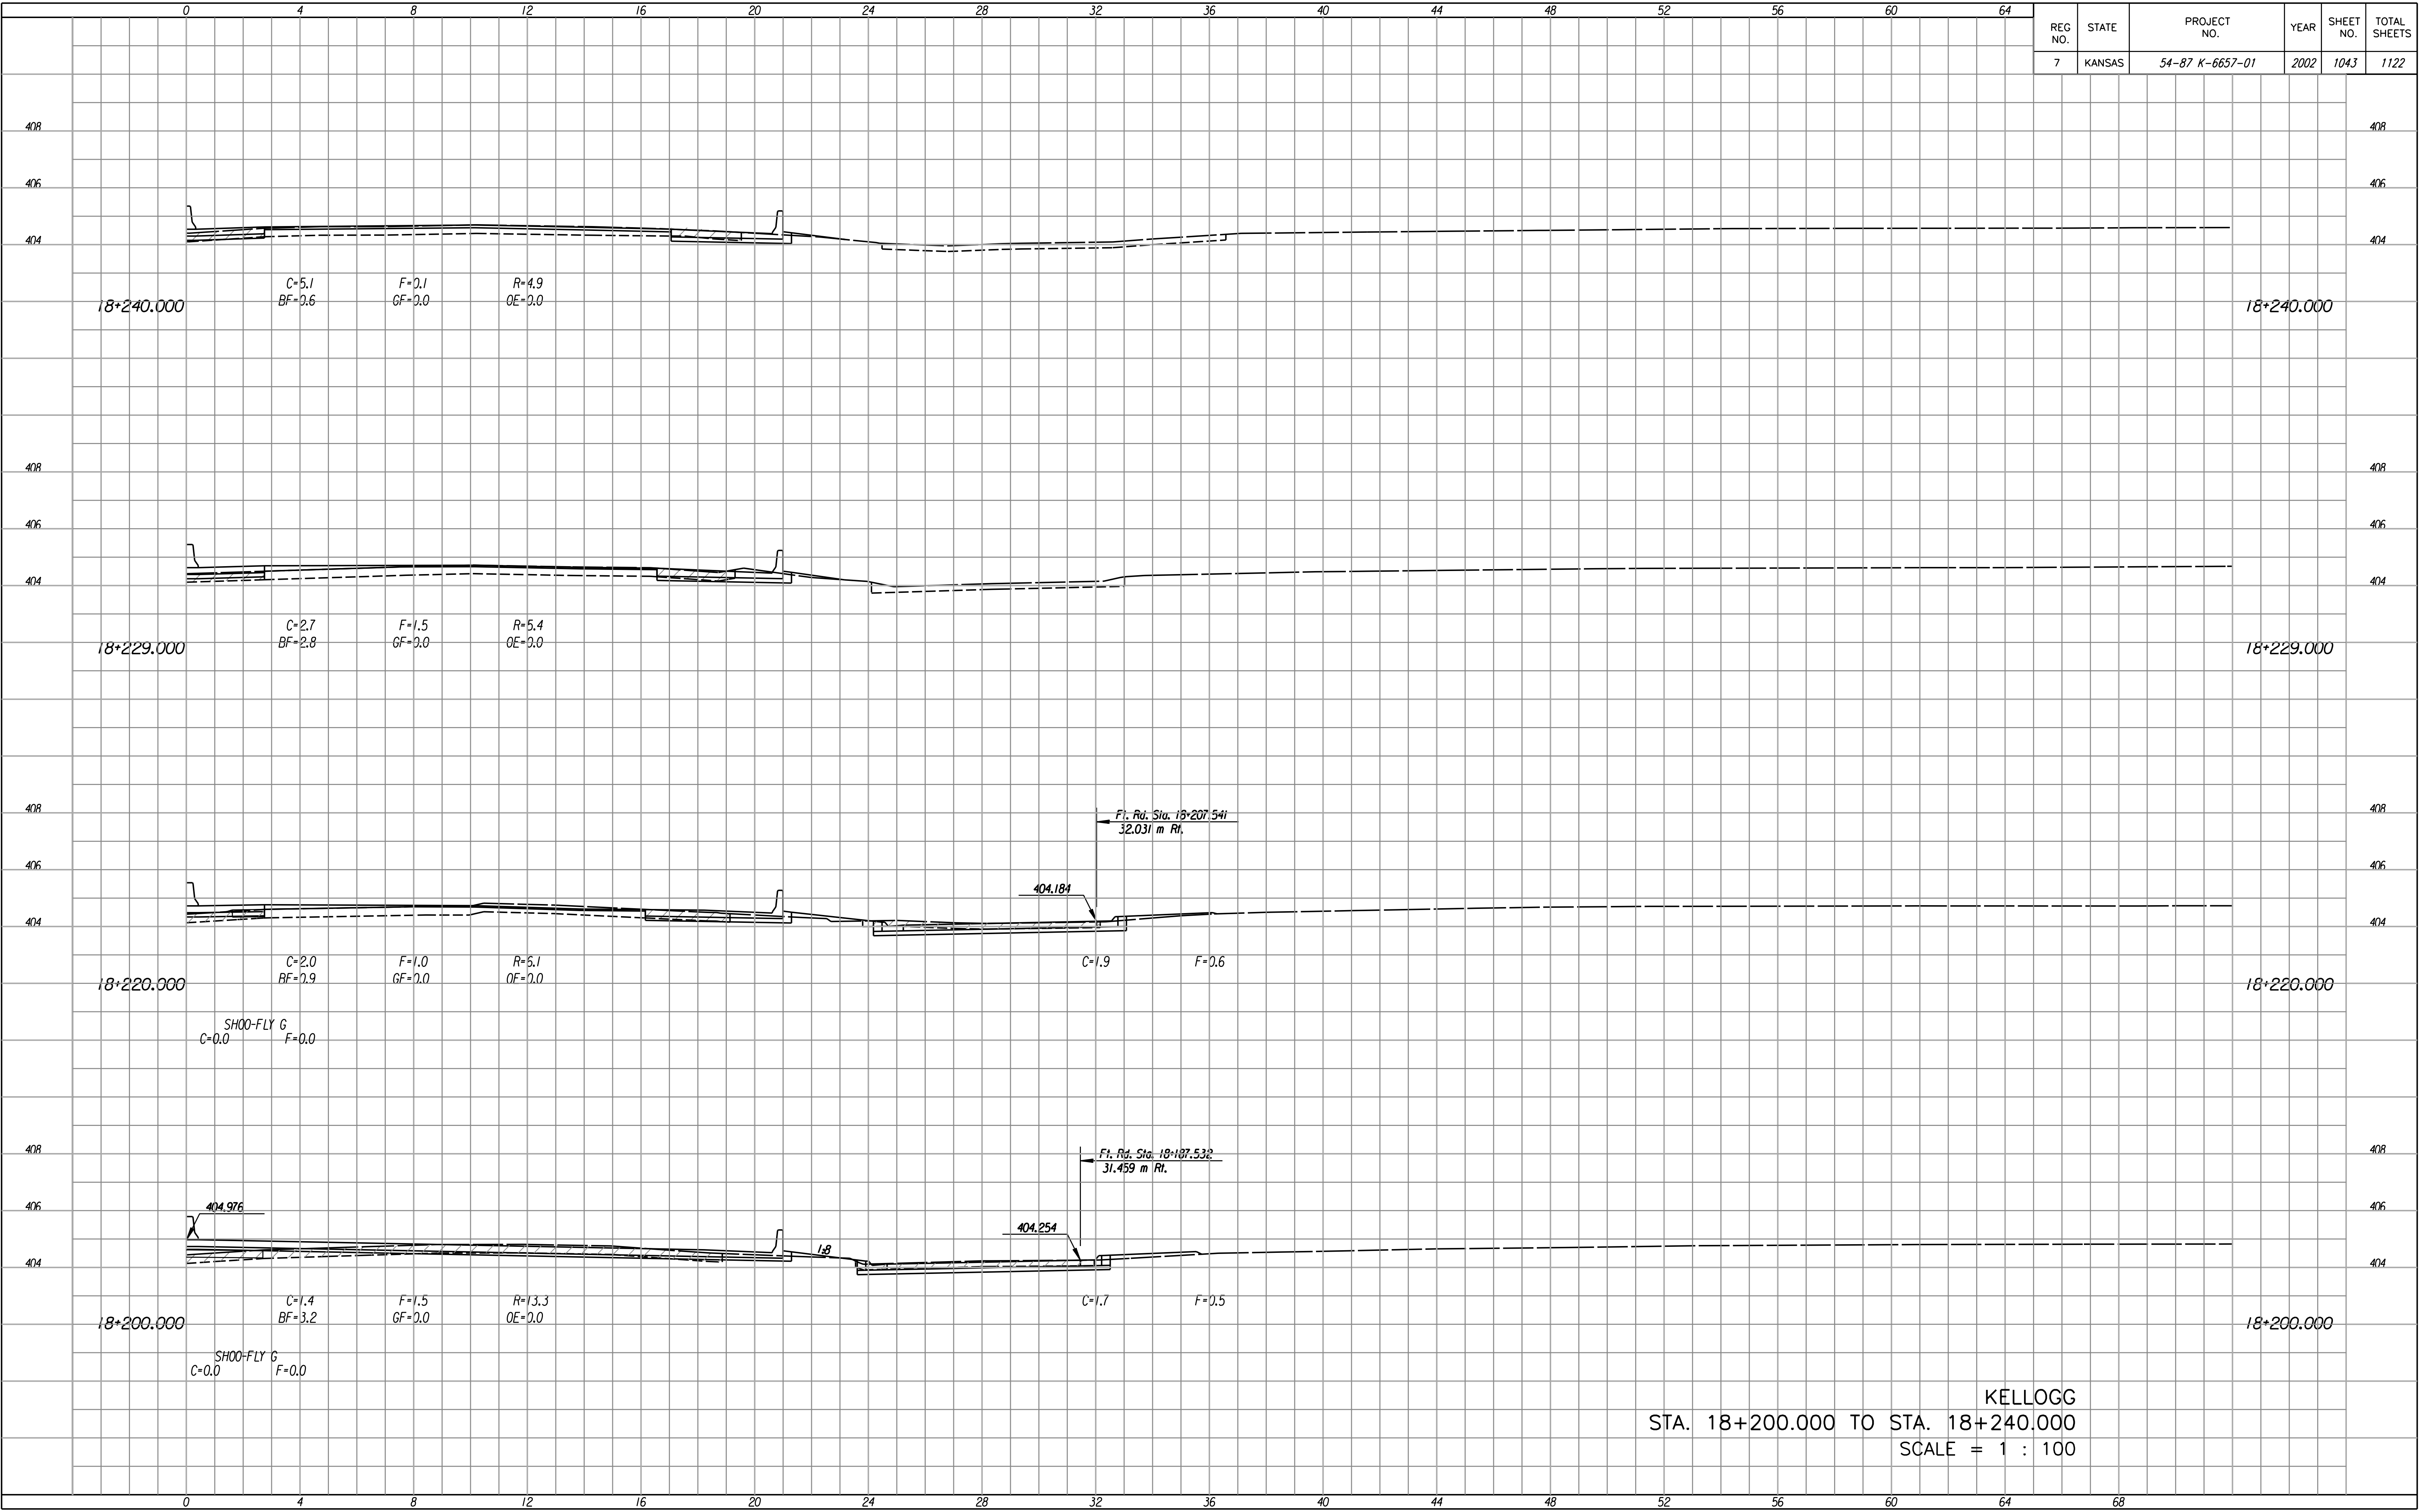

KELLOGG
 STA. 18+200.000 TO STA. 18+240.000
 SCALE = 1 : 100