


REG NO.	STATE	PROJECT NO.	YEAR	SHEET NO.	TOTAL SHEETS
7	KANSAS	54-87 K-6657-01	2002	1045	1122

FINAL SURVEY NO.	DATE
SURVEYED BY	DATE
PLOTTED BY	DATE
TEMPLATE AREAS CHECKED	DATE
NO. OF AREAS CHECKED	DATE

Last Rev. : 10-12-07 By: gdr  
 Scale : 100  
 Design File : i:/1997/97662/As-Built/dgn/s/Vol 5/Sh 1045-Mainline-x82600r1.dgn

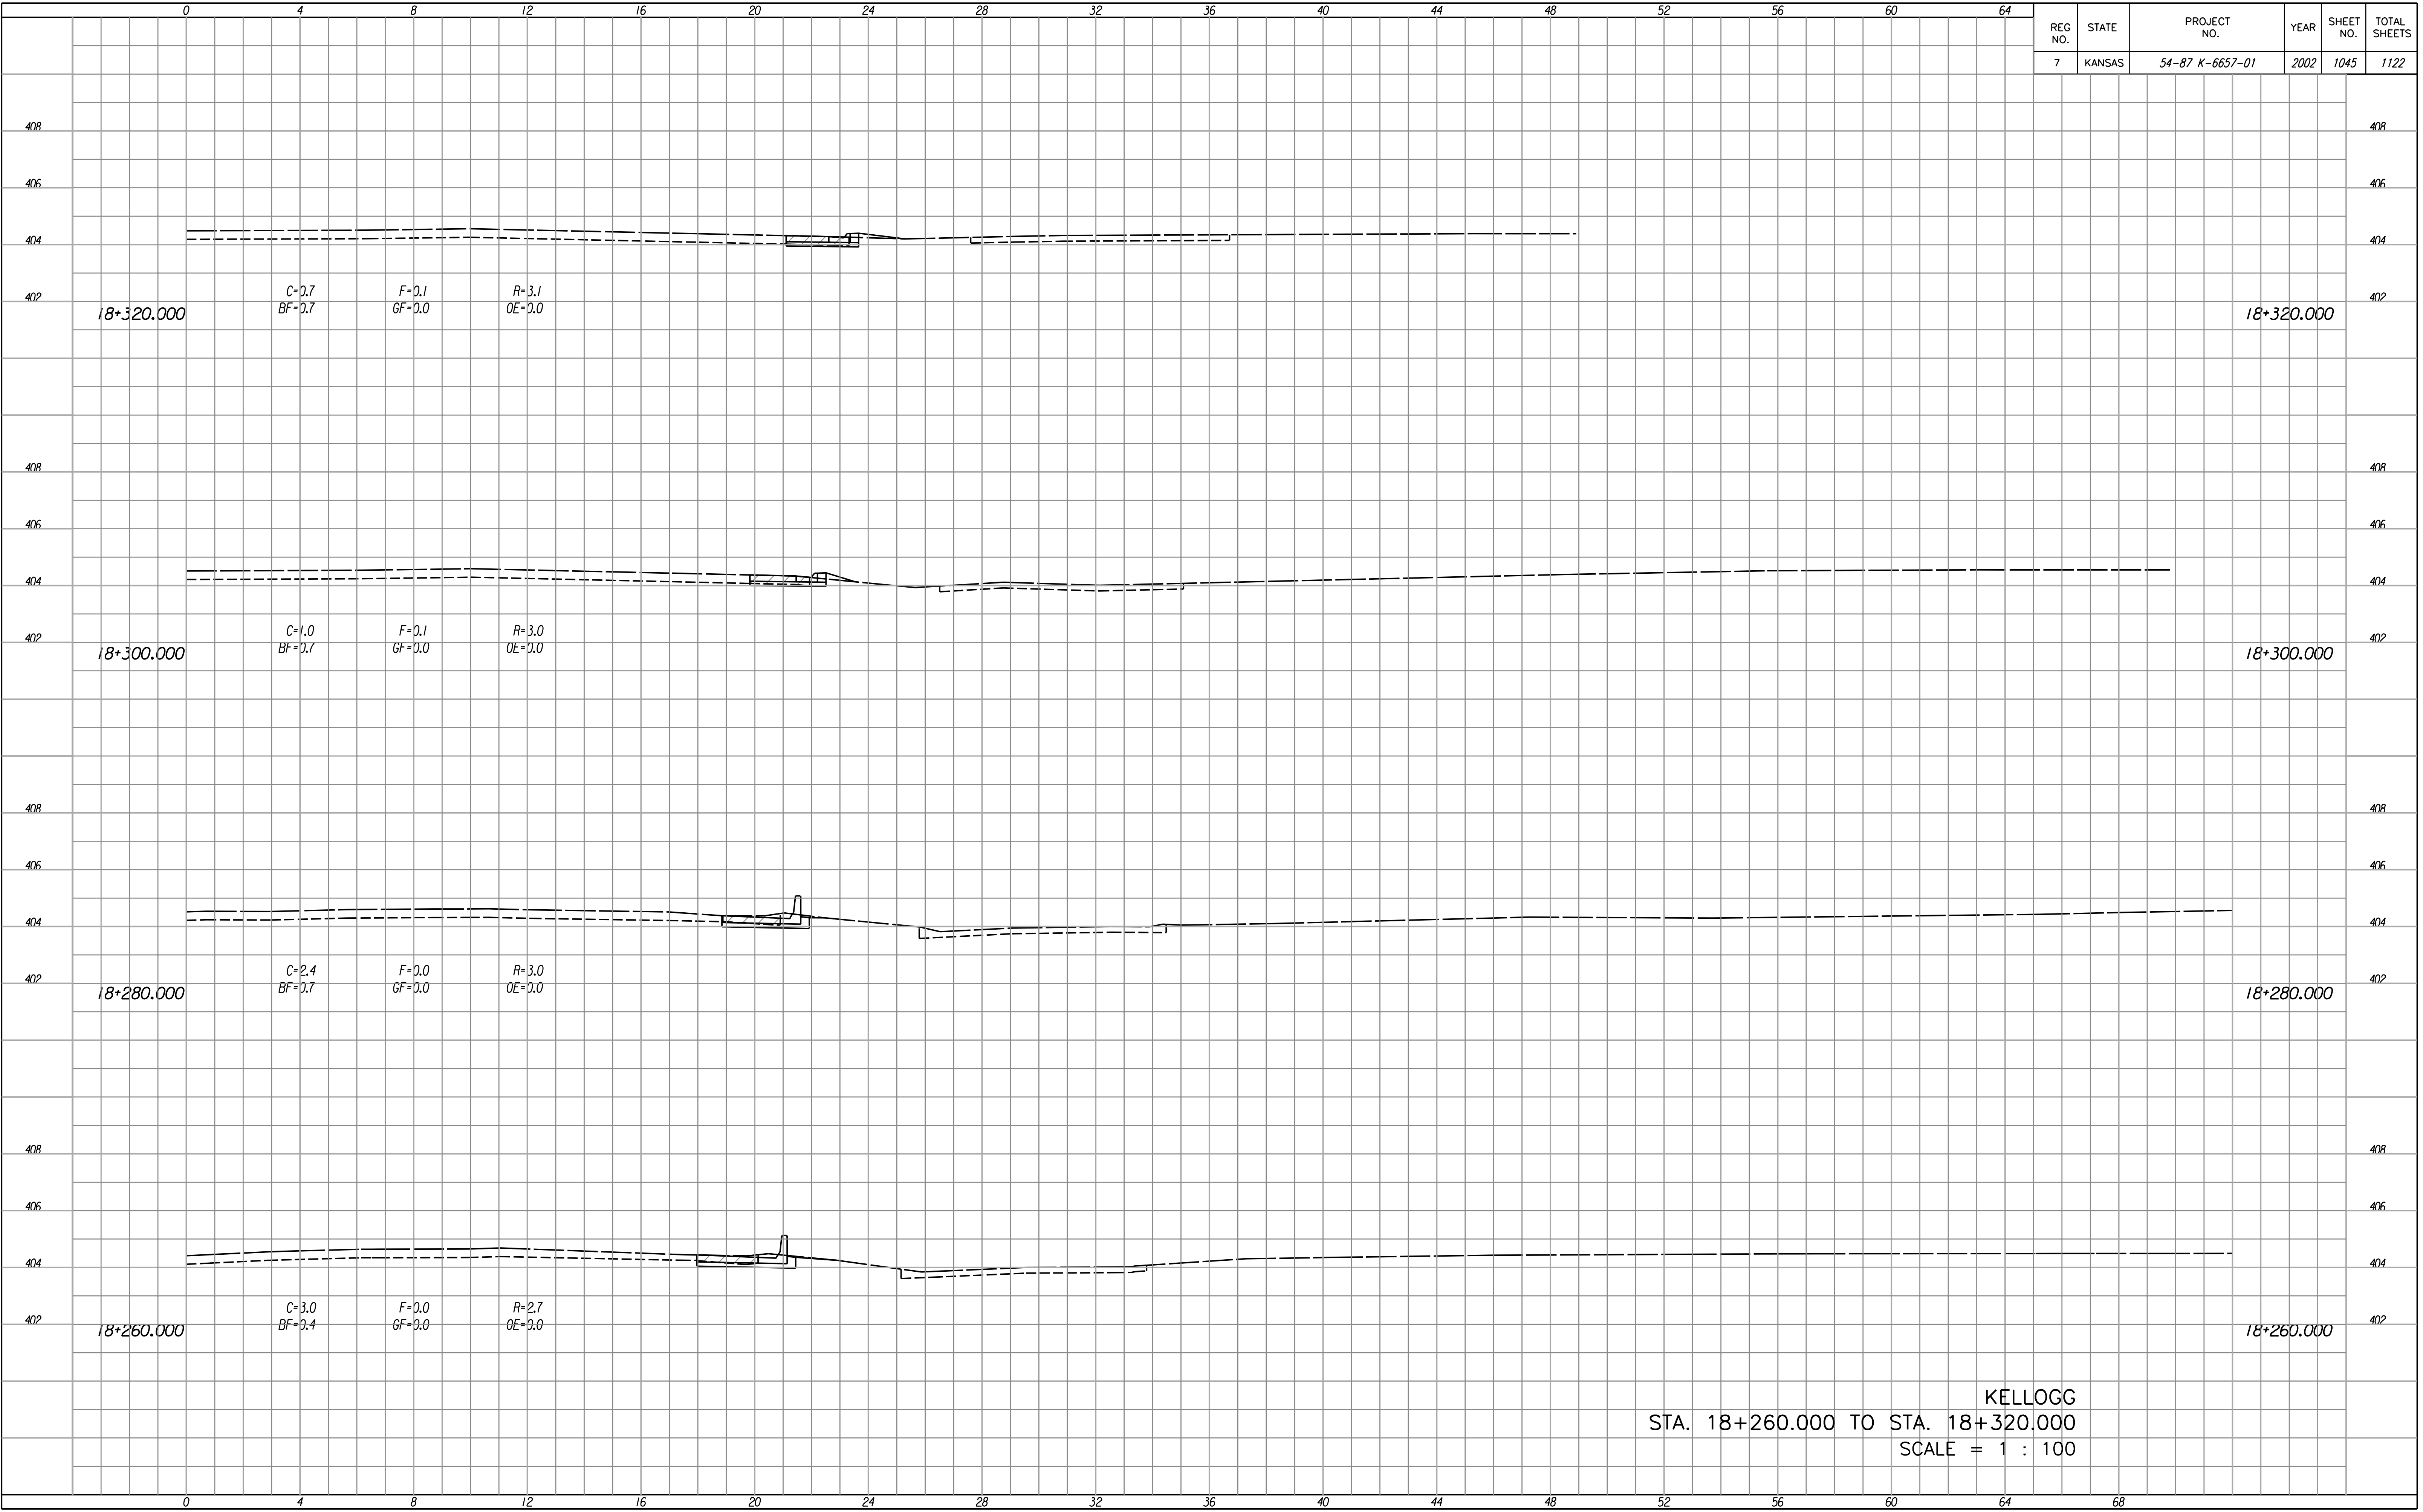

KELLOGG  
 STA. 18+260.000 TO STA. 18+320.000  
 SCALE = 1 : 100