


REG. NO.	STATE	PROJECT NO.	YEAR	SHEET NO.	TOTAL SHEETS
7	KANSAS	54-87 K-6657-01	2002	1048	1122

FINAL SURVEY NO.	BY	DATE

Last Rev. : 10-12-07 By: gdr  
 Scale : 100  
 Design File : i:/1997/97662/As-Builts/dgn/s/Vol 5/Sh 1048-Mainline-rs04201.dgn

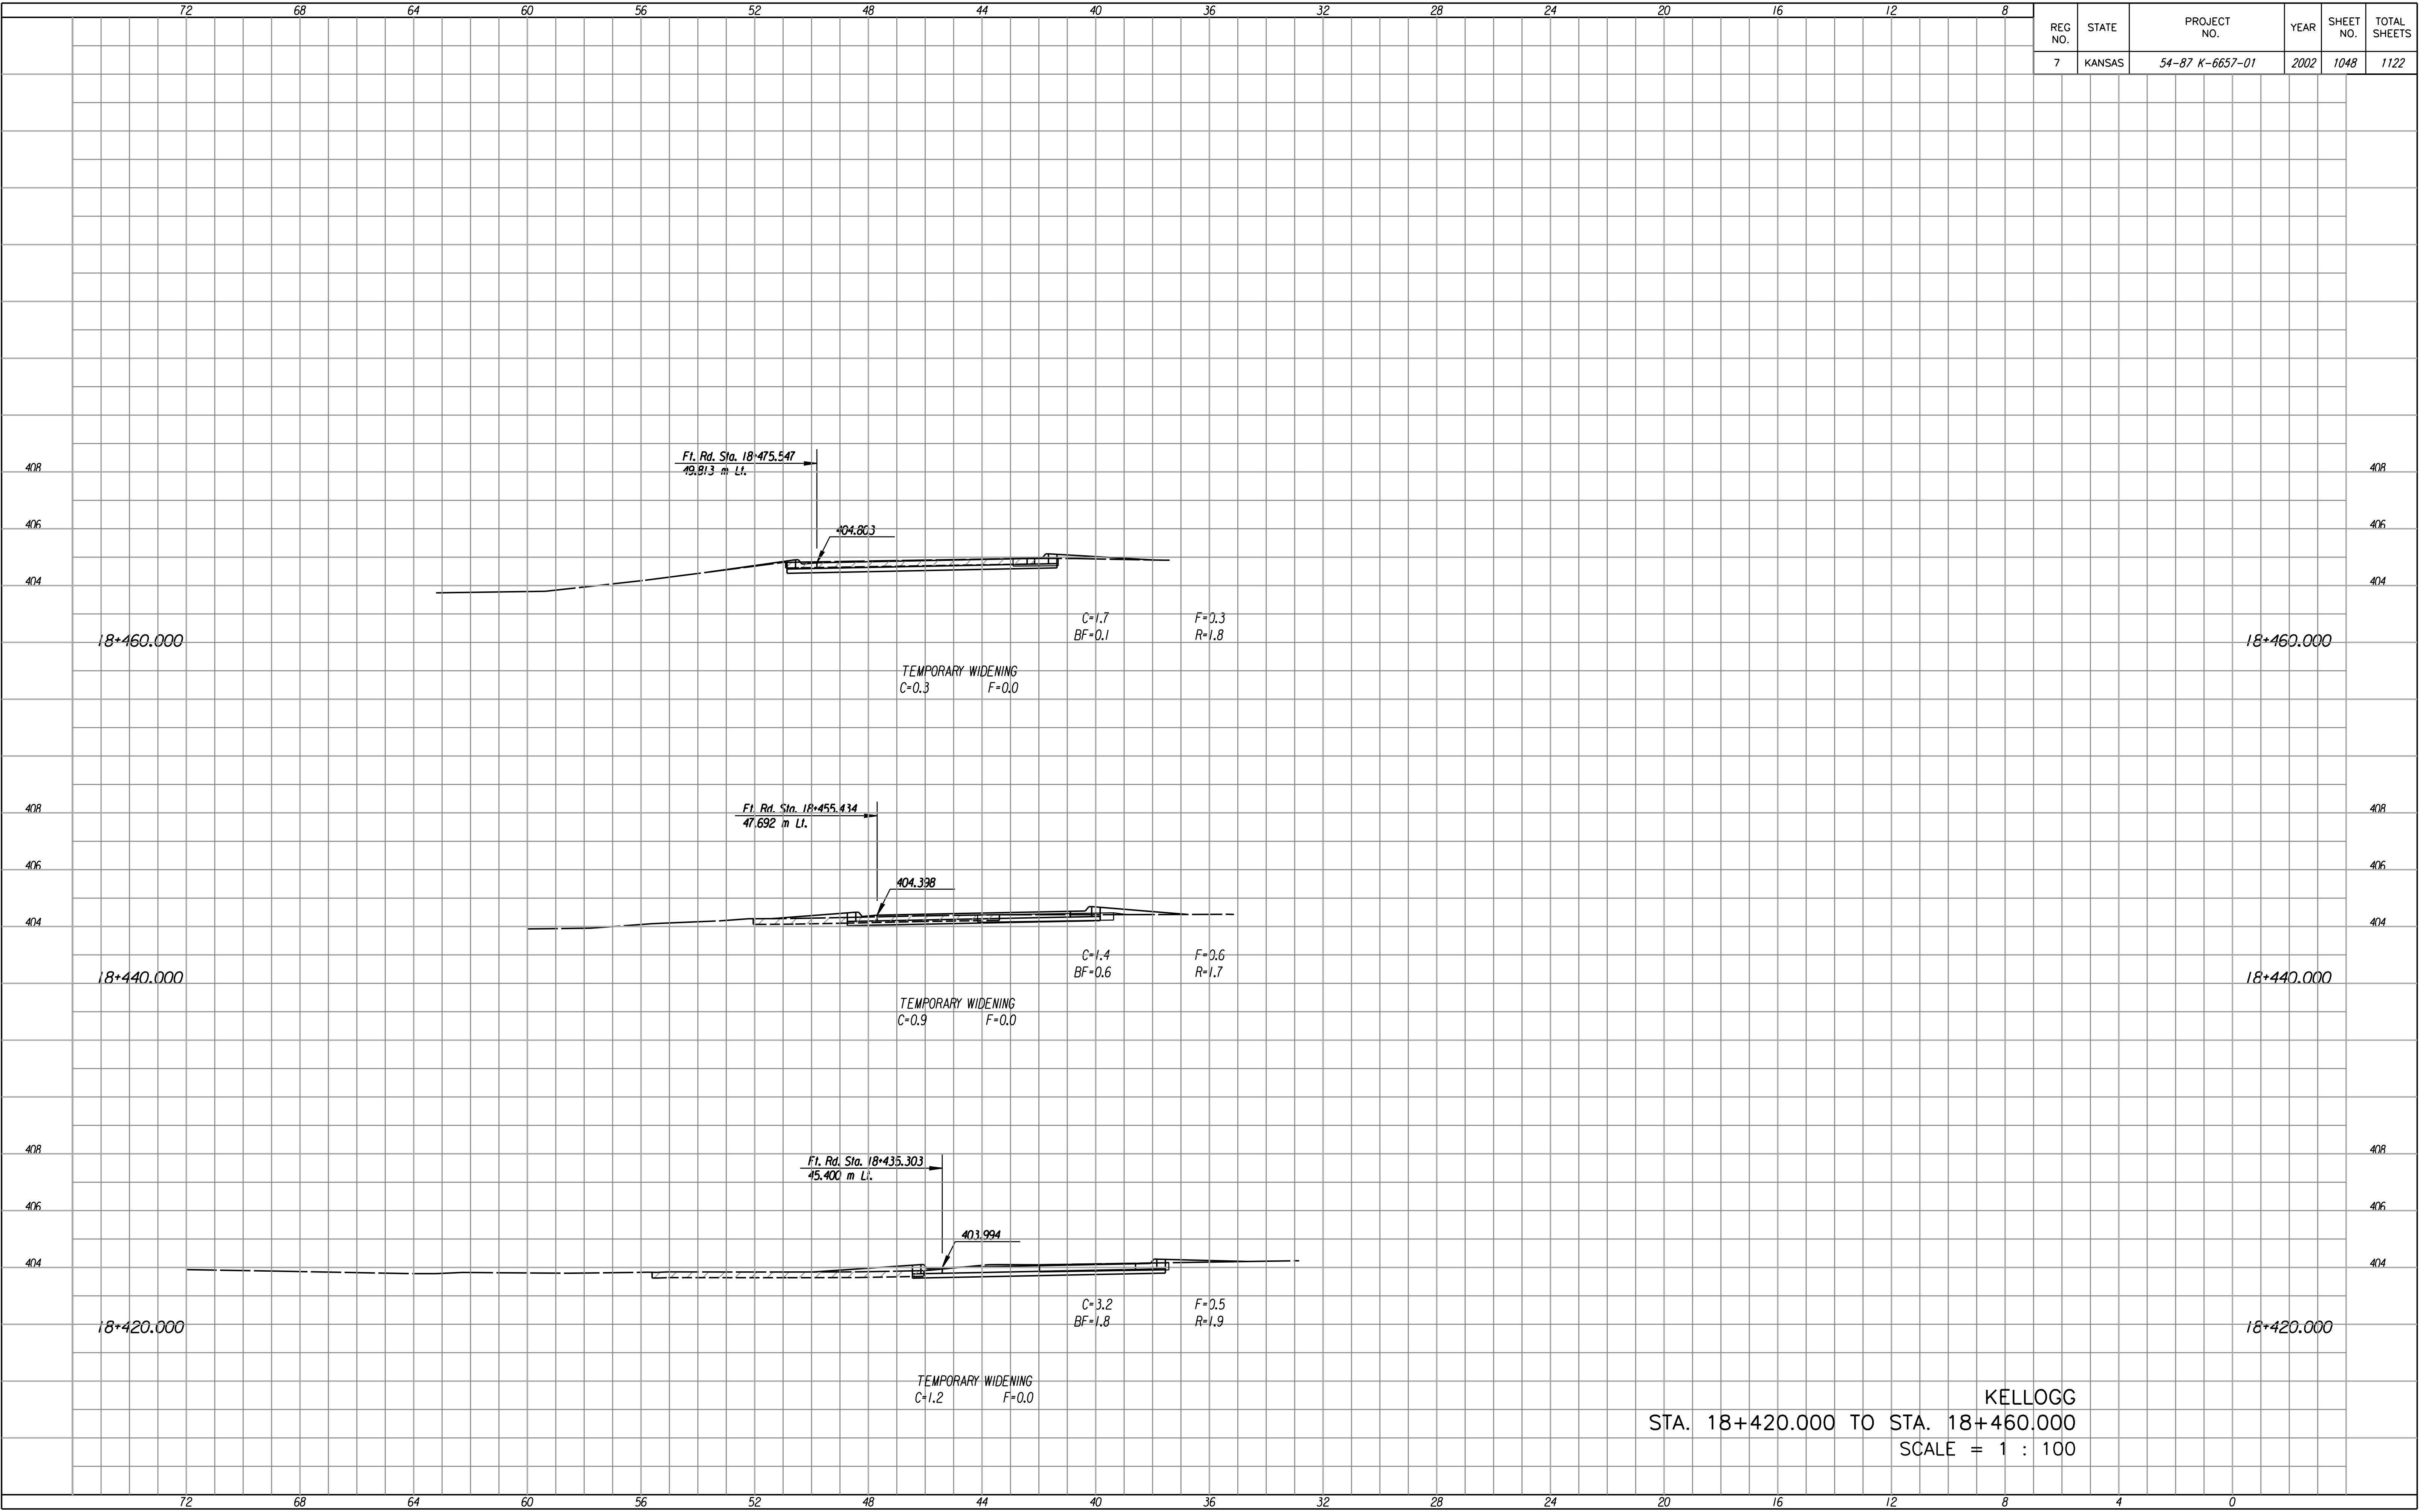

STA. 18+420.000 TO STA. 18+460.000  
 SCALE = 1 : 100  
 KELLOGG