


REG NO.	STATE	PROJECT NO.	YEAR	SHEET NO.	TOTAL SHEETS
7	KANSAS	54-87 K-6657-01	2002	1052	1122

FINAL SURVEY NO.	DATE
SURVEYED	
PLOTTED	
TEMPLATE	
REVISIONS	
CHECKED	

Plotted By :
 Sheet :
 Design File : i:\1997\97362\As-Builts\dgn\Vol.5\Sh. 1052-Cowskin-XS4970right.dgn
 Scale = 1 : 100

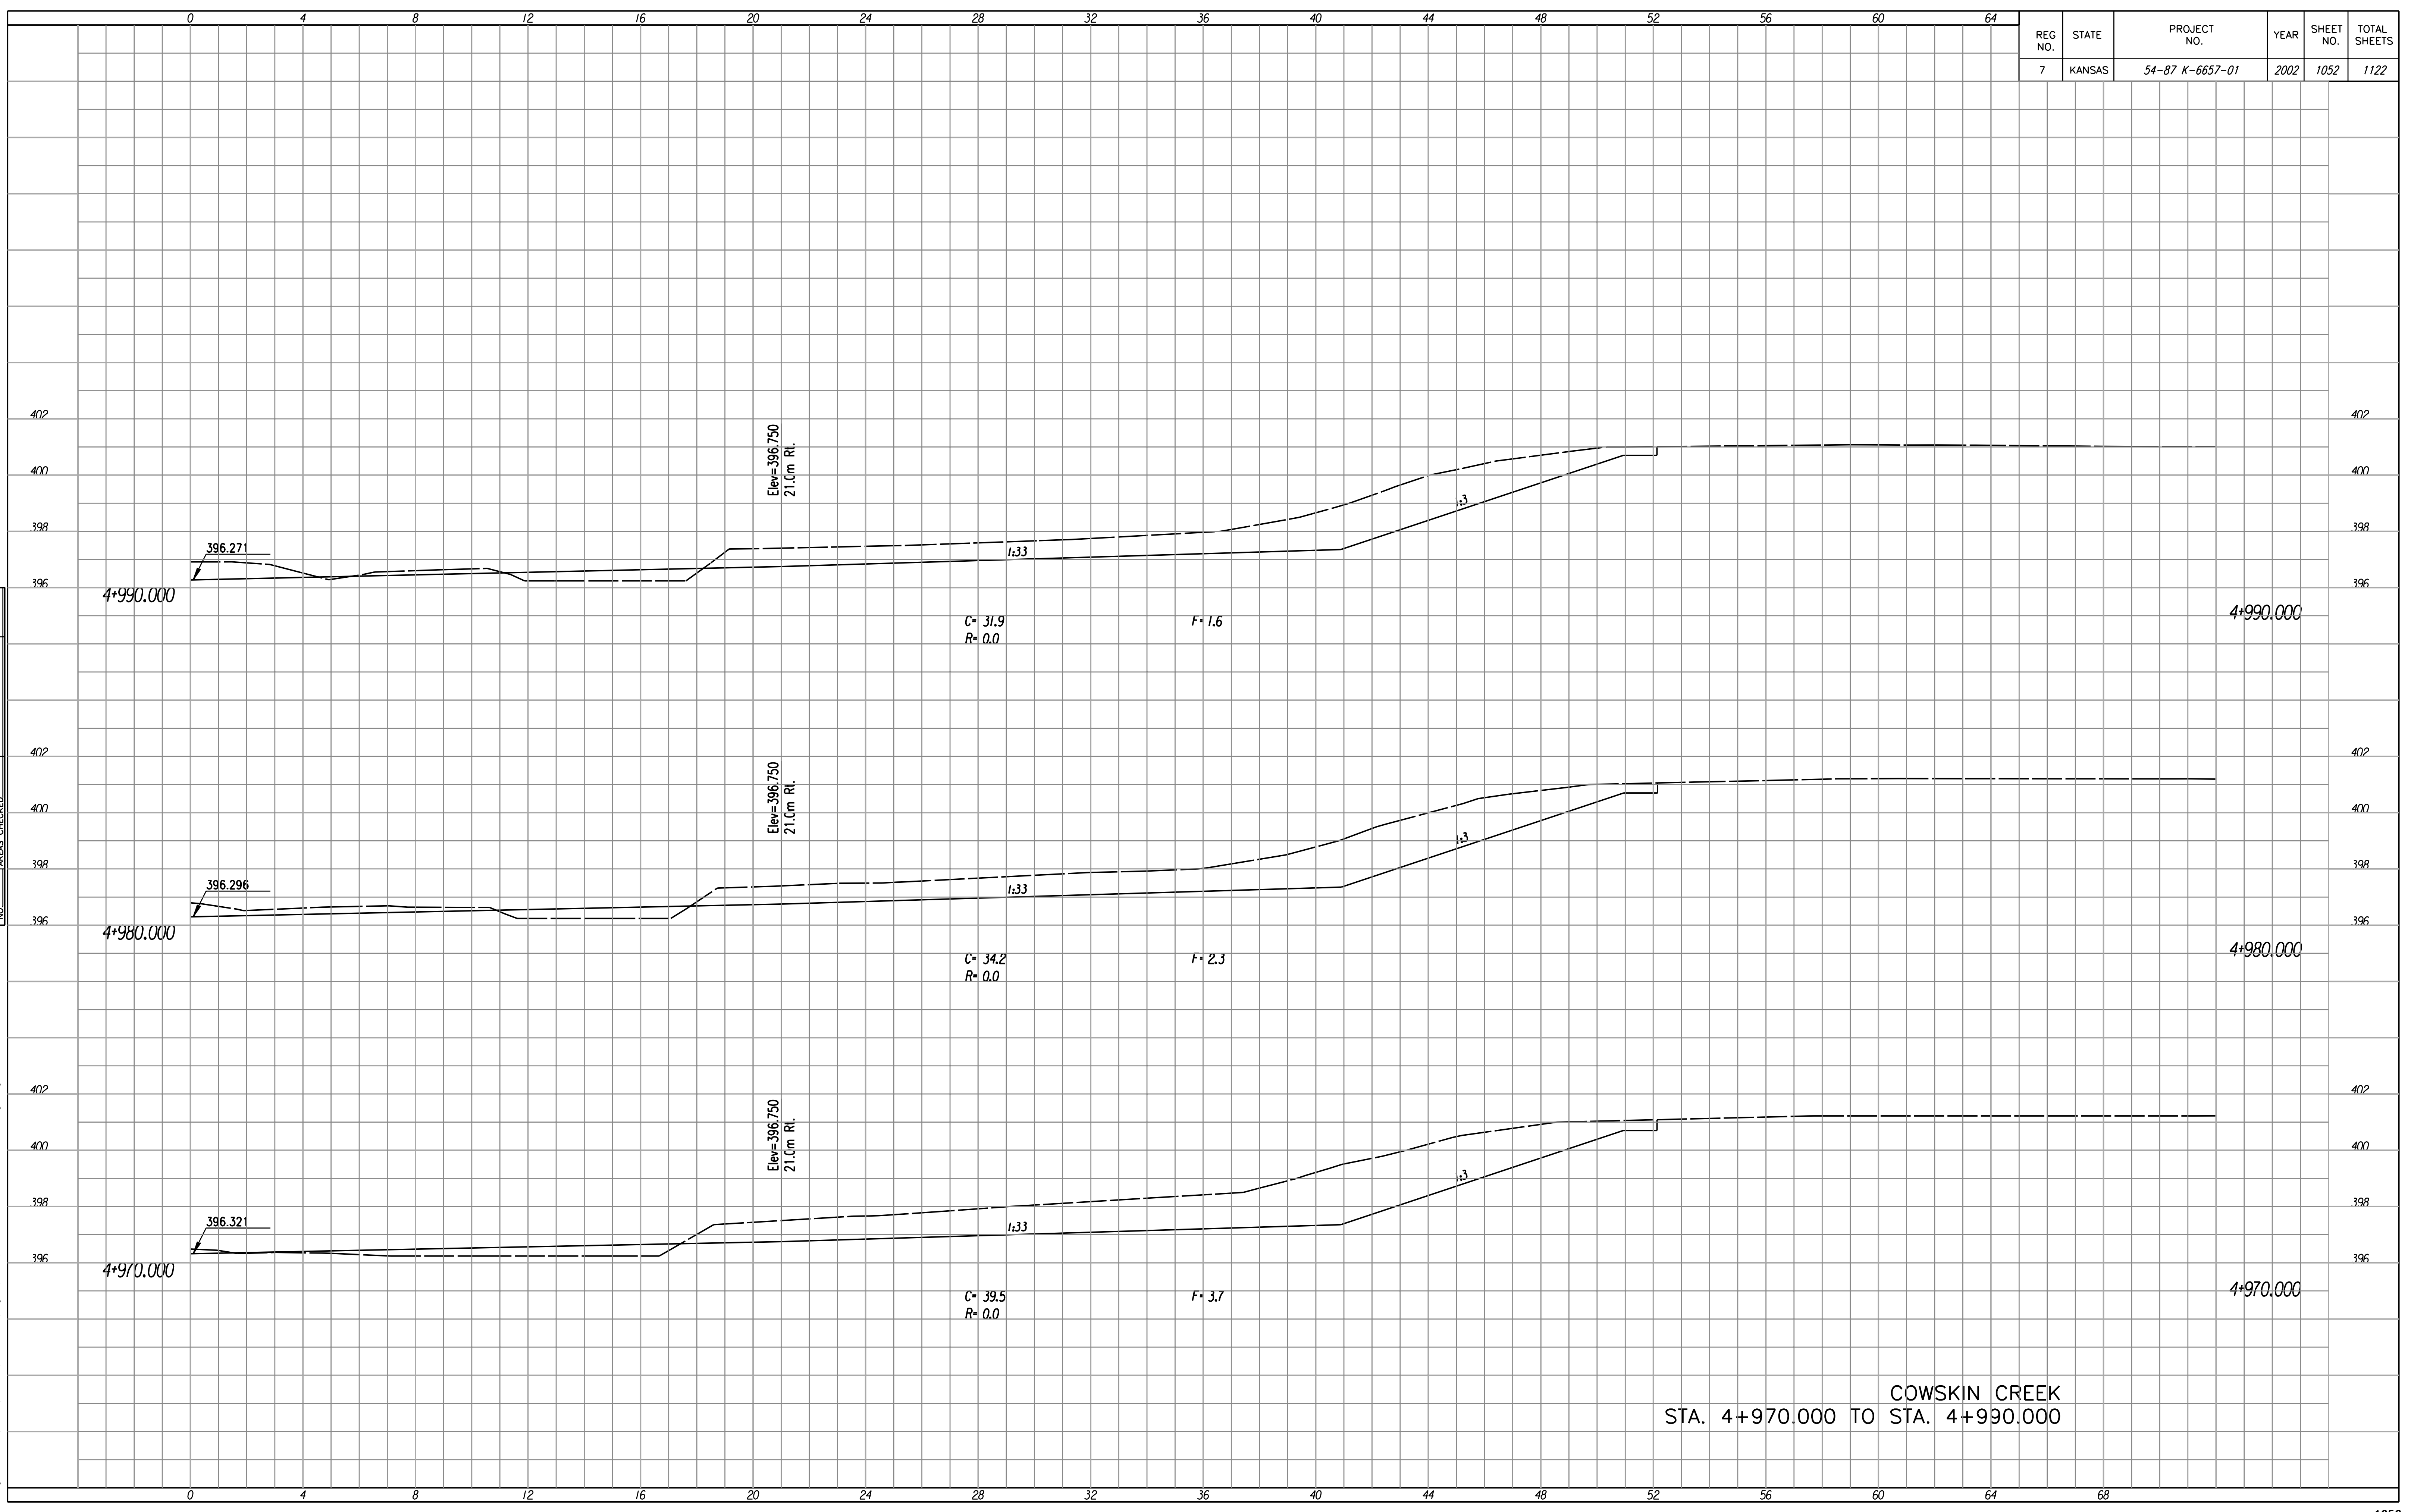

COWSKIN CREEK
 STA. 4+970.000 TO STA. 4+990.000