


REG NO.	STATE	PROJECT NO.	YEAR	SHEET NO.	TOTAL SHEETS
7	KANSAS	54-87 K-6657-01	2002	1054	1122

FINAL SURVEY NO.	DATE
SURVEYED	
PLOTTED	
TEMPLATE	
AREAS CHECKED	

Plotted By :
 Sheet :
 Design File : i:\1997\97362\As-Builts\dgn\Vol.5\Sh. 1054-Cowskin-XS5000.rvt.dgn
 Scale = 1 : 100

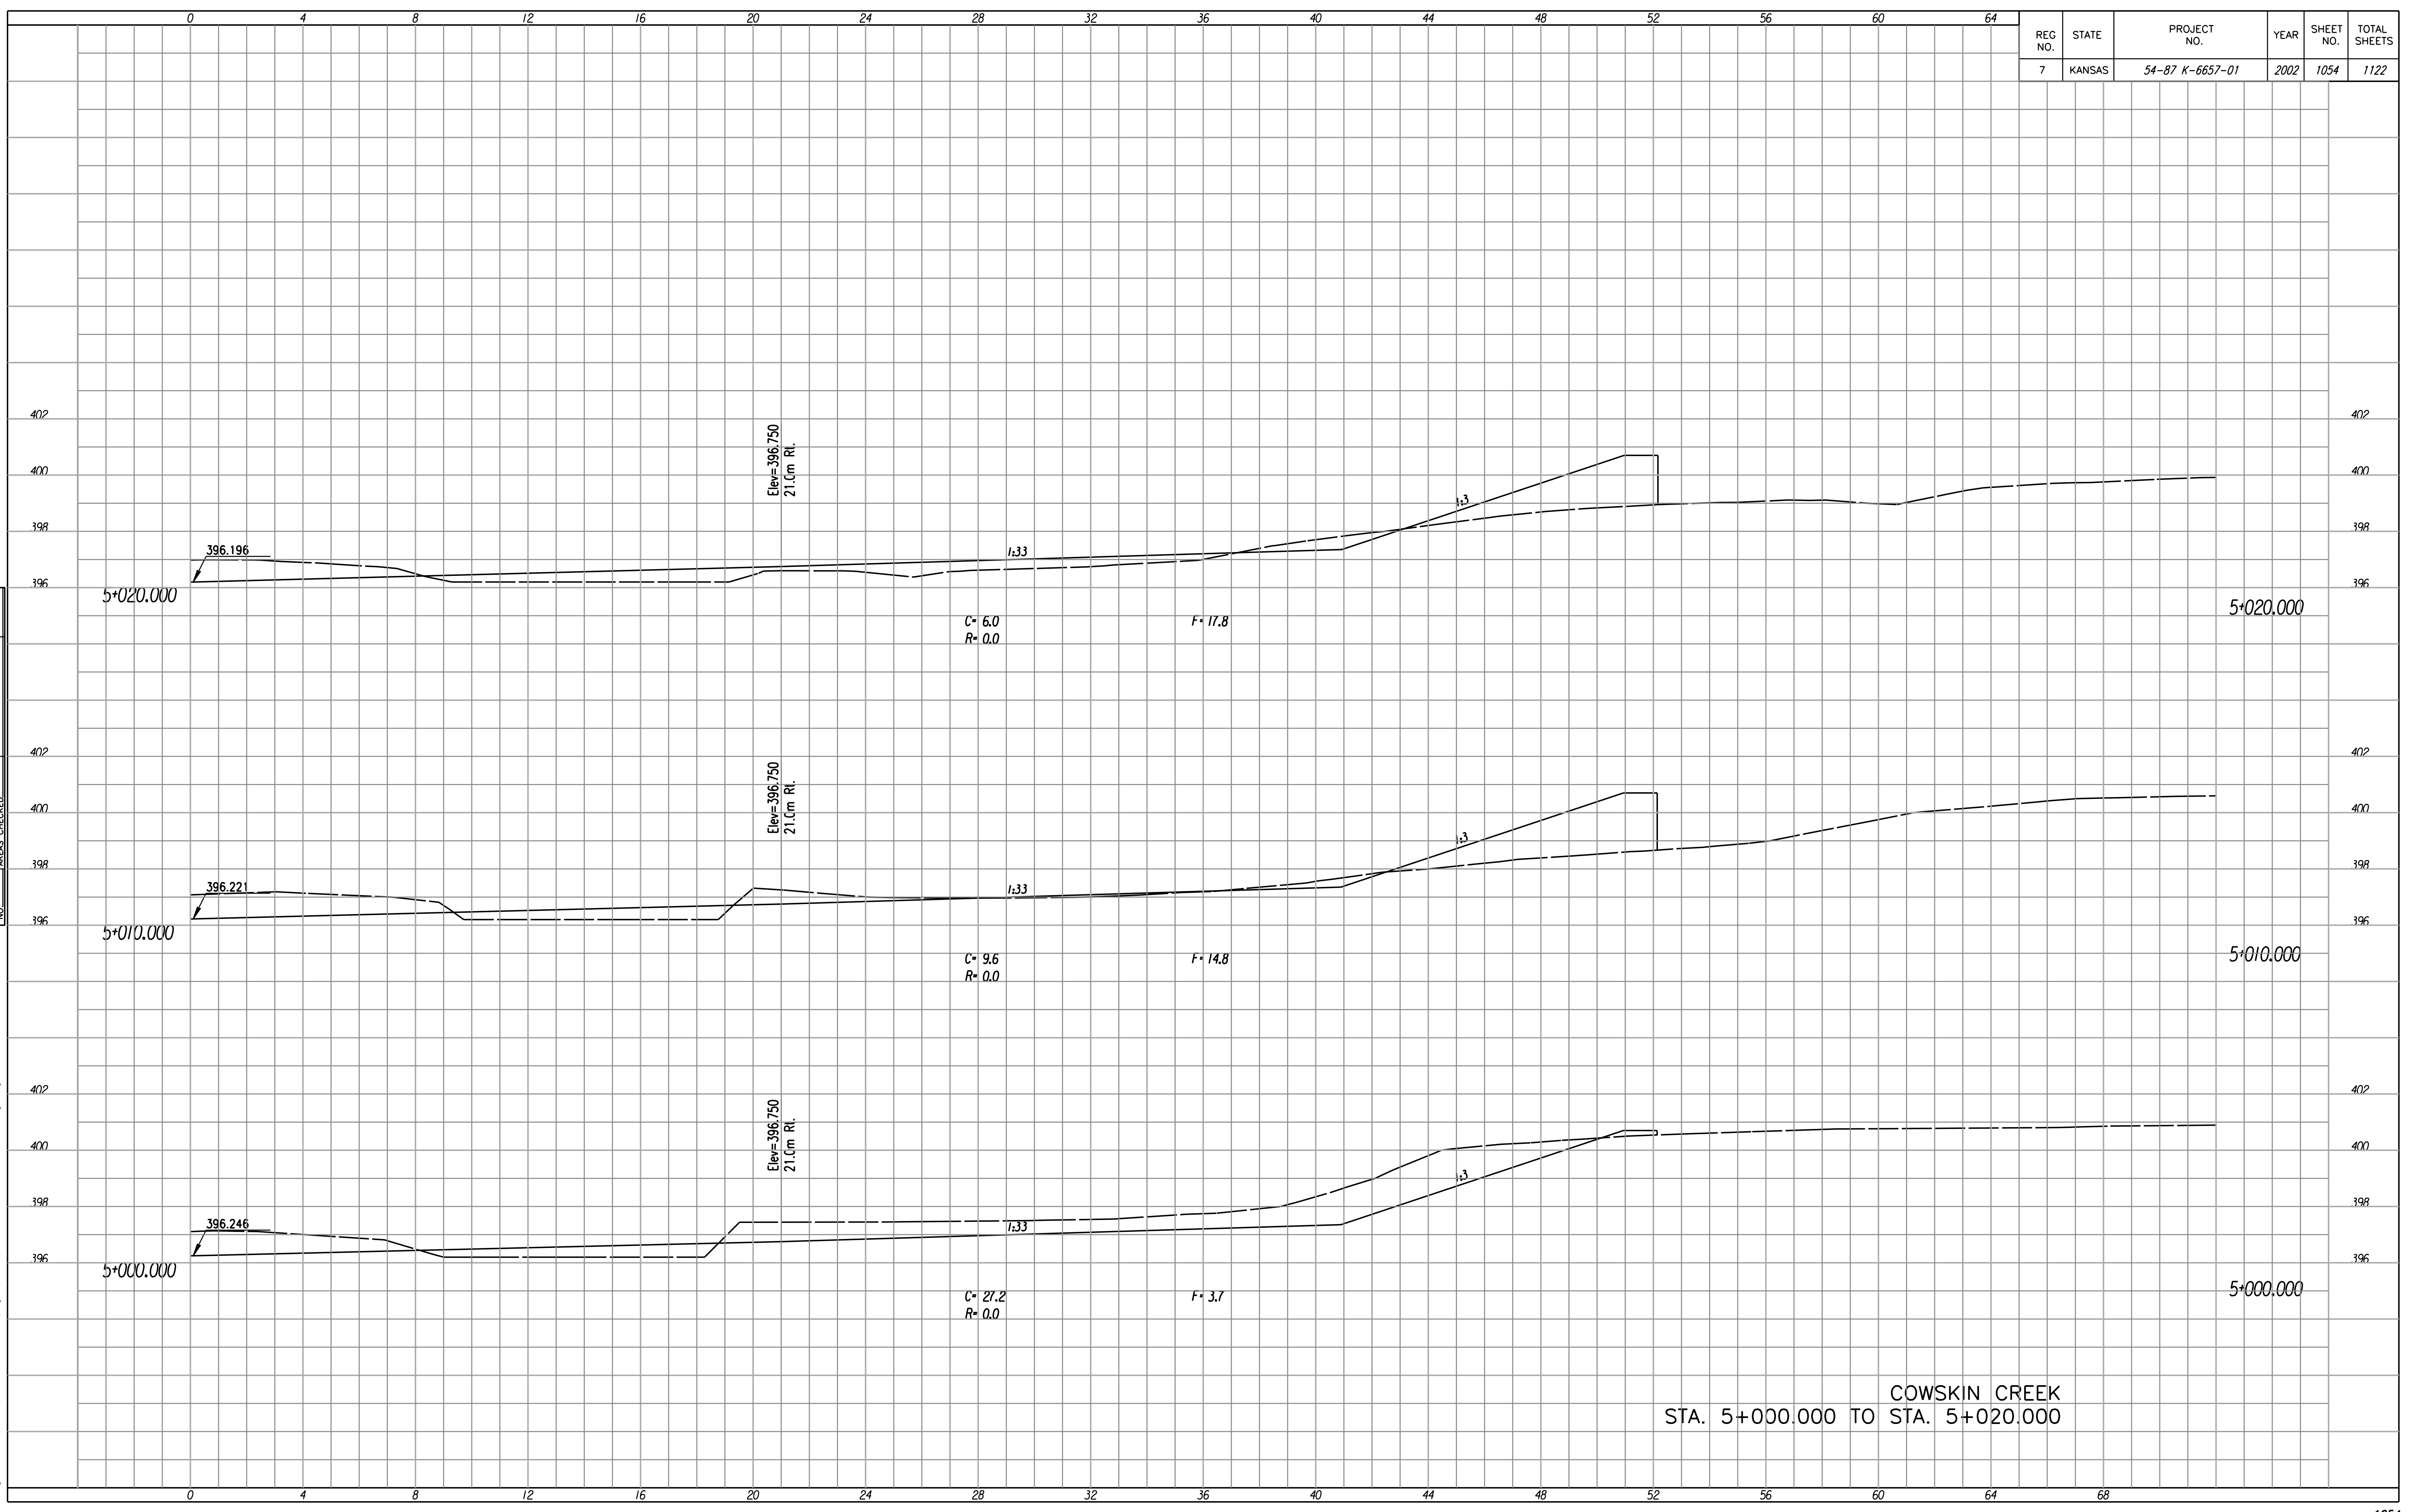

COWSKIN CREEK
 STA. 5+000.000 TO STA. 5+020.000