


FHWA REG NO.	STATE	PROJECT NO.	YEAR	SHEET NO.	TOTAL SHEETS
7	KANSAS	54-87 K-6657-01	2002	1062	1122
	32	36		40	

FINAL SURVEY NO.	DATE
SURVEYED BY	
PLOTTED BY	
TEMPLATE AREAS CHECKED	

DSWR: RCH OPER: SVB SCALE: 1:100  
 I:/1997/07362/As-Built/dgn's/Vol.5/Sh\_1062-Maize-KS3708.dgn

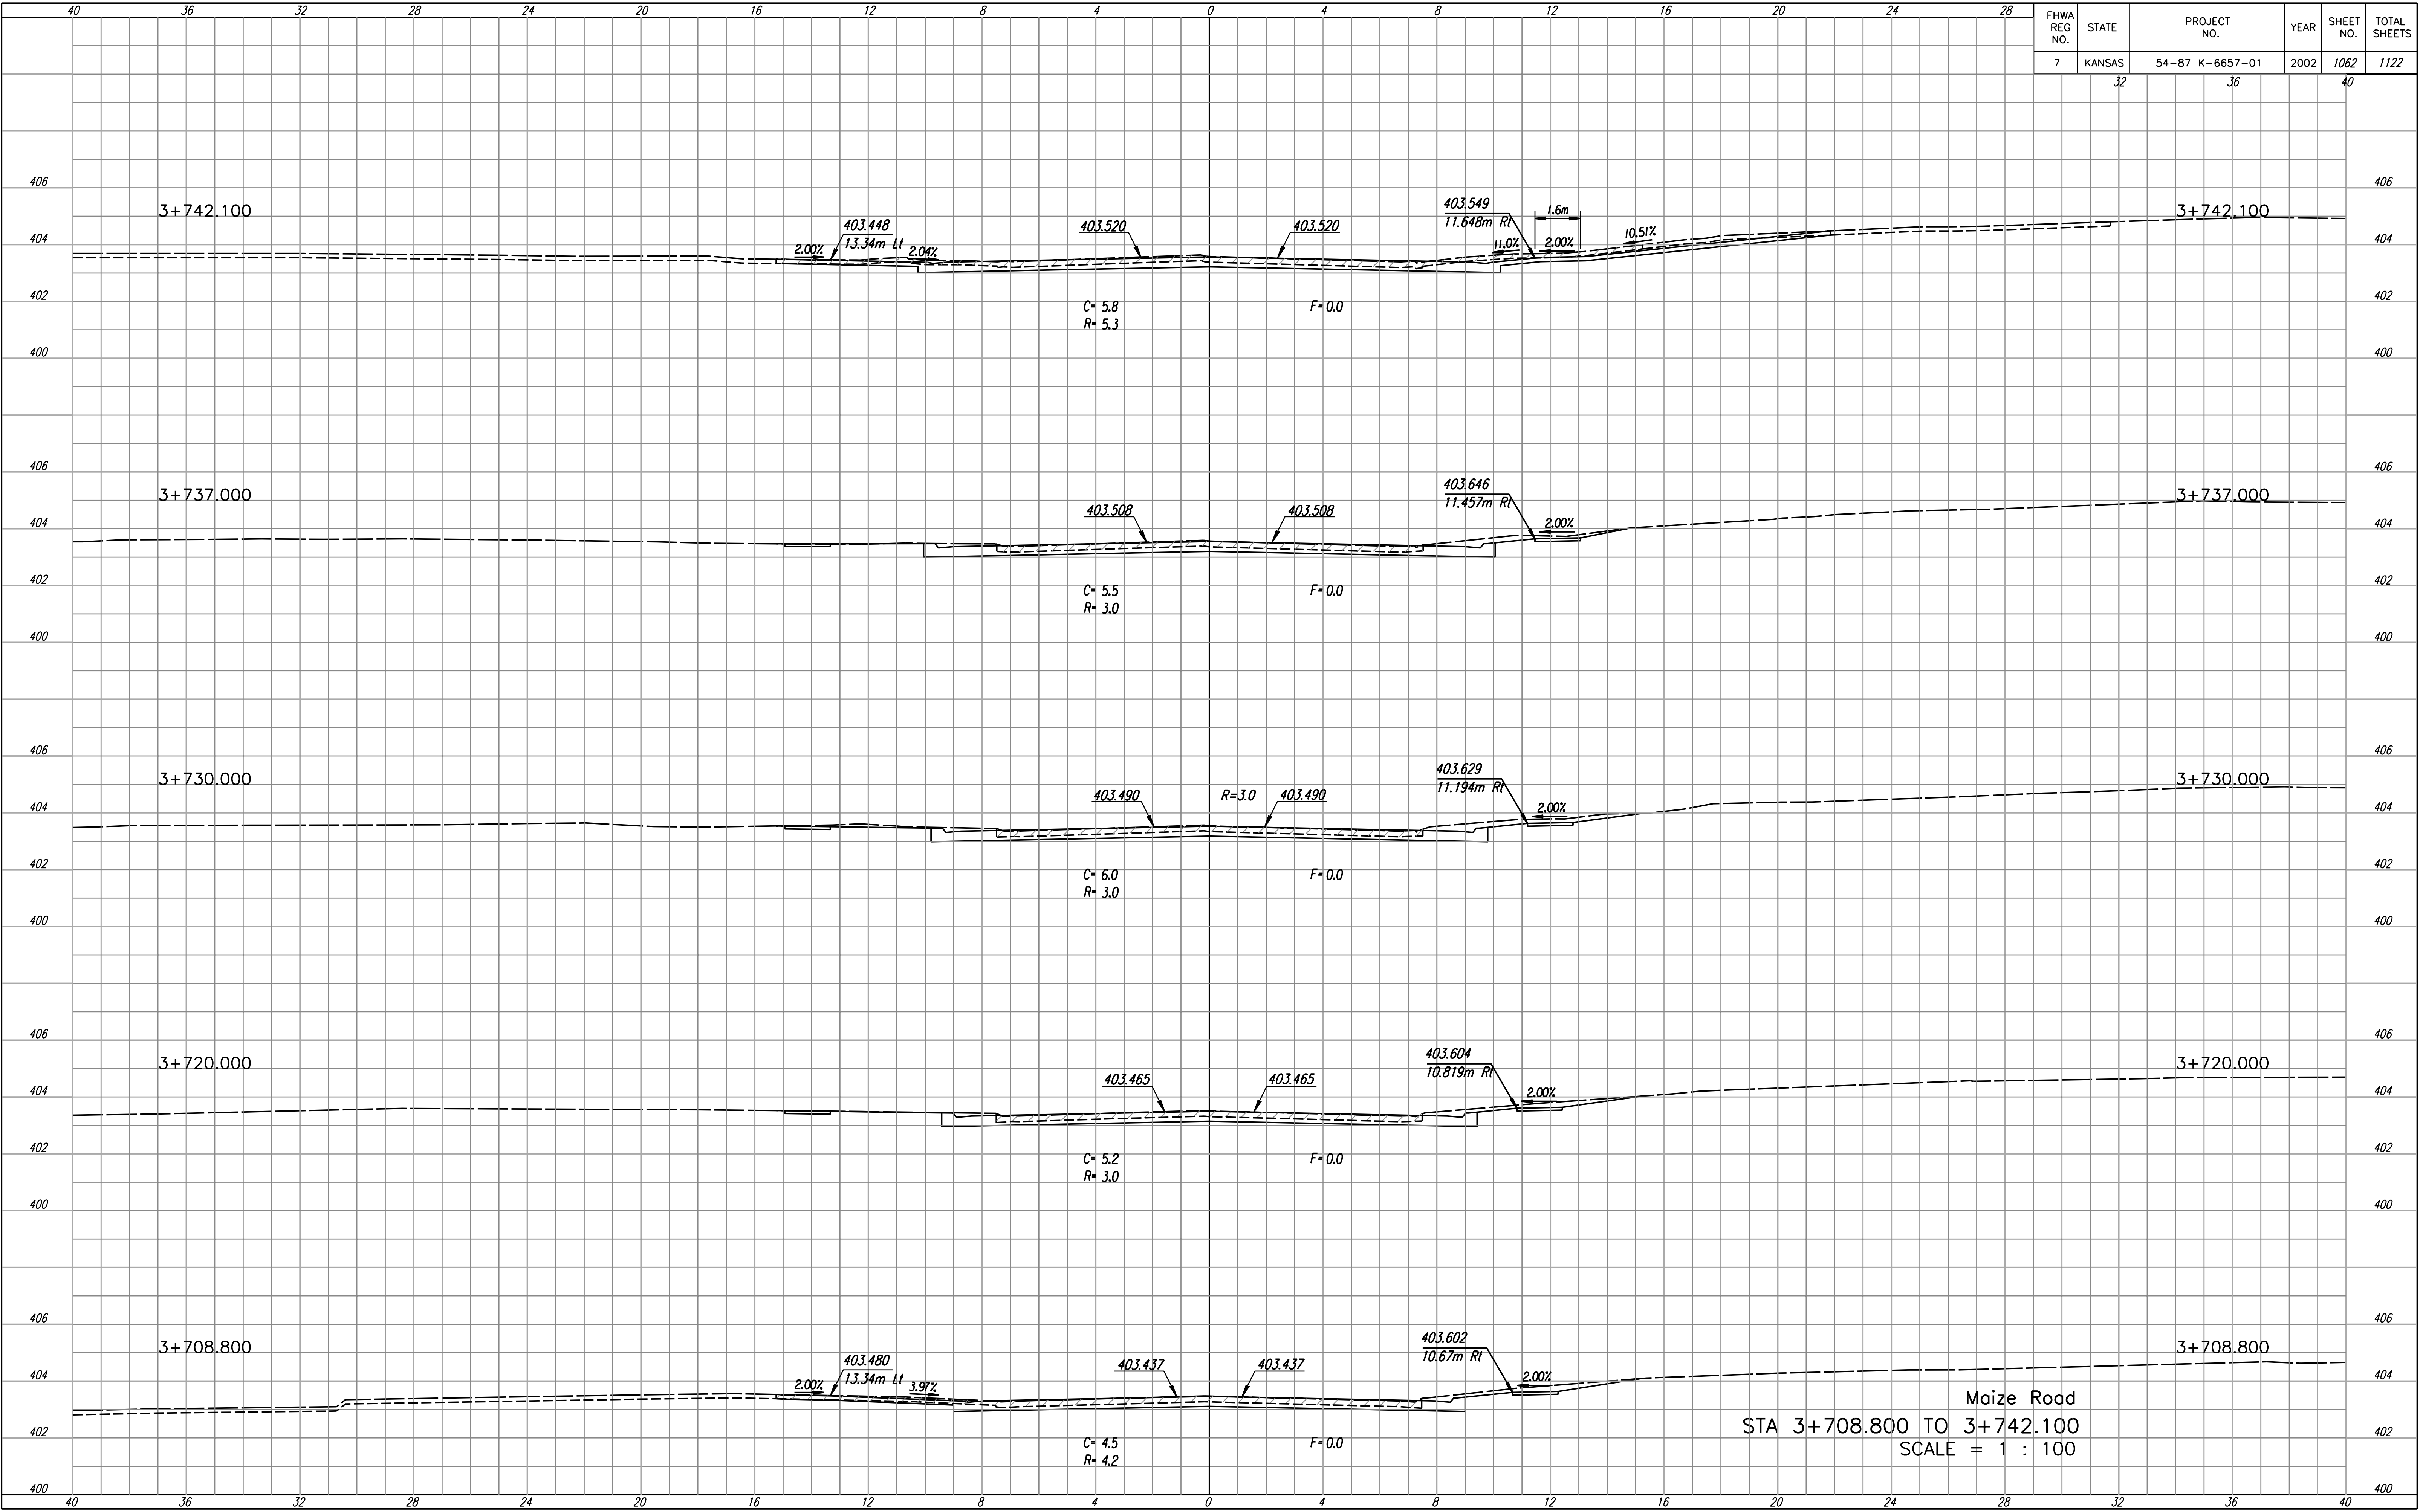

Maize Road  
 STA 3+708.800 TO 3+742.100  
 SCALE = 1 : 100