


FHWA REG NO.	STATE	PROJECT NO.	YEAR	SHEET NO.	TOTAL SHEETS
7	KANSAS	54-87 K-6657-01	2002	1072	1122
		72	76	80	

FINAL SURVEY NO.	BY	DATE
SURVEYED	PLOTTED	DATE
NOTE BOOK	TEMPLATE	AREAS CHECKED
NO.		

DSWR: RCH OPER: SVB SCALE: 1:100
 I:/1997/07362/As-Built/egn's/vol.5/Sh_1072-Maize-154040Right.dgn

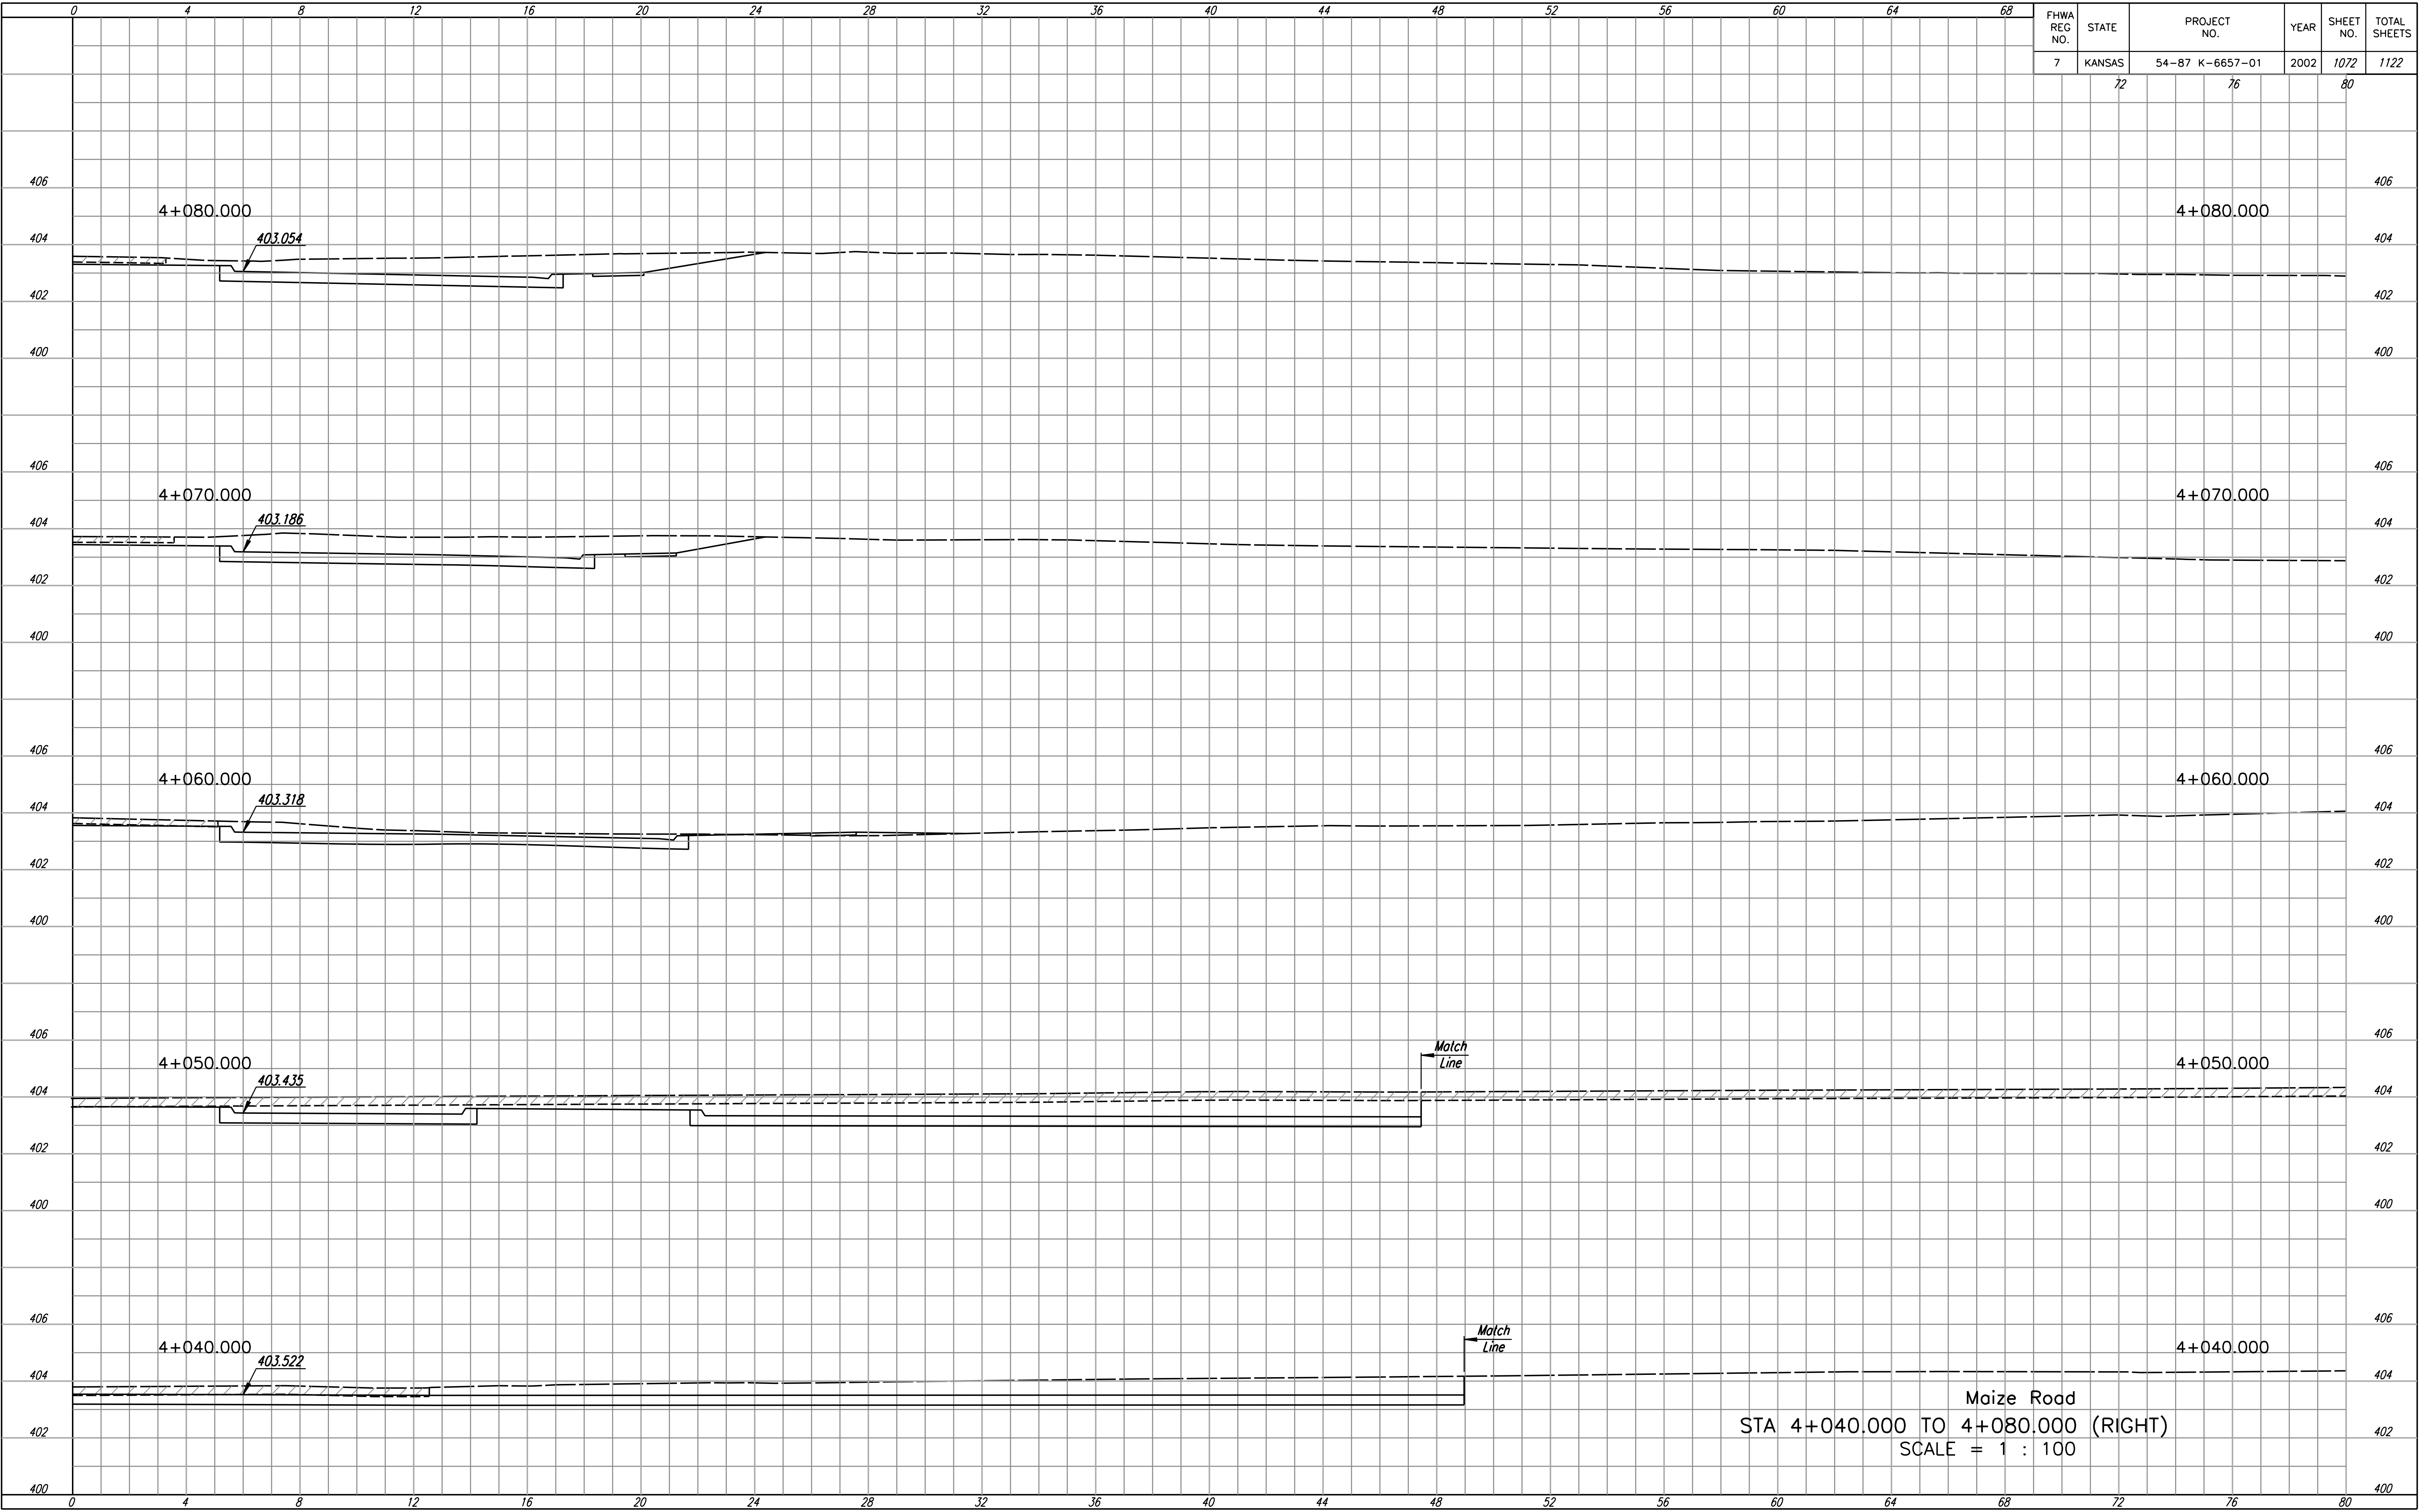

Maize Road
 STA 4+040.000 TO 4+080.000 (RIGHT)
 SCALE = 1 : 100