


FHWA REG NO.	STATE	PROJECT NO.	YEAR	SHEET NO.	TOTAL SHEETS
7	KANSAS	54-87 K-6657-01	2002	1080	1122
32		36		40	

FINAL SURVEY NOTE BOOK NO.	DATE
SURVEYED PLOTTED TEMPLATE AREAS CHECKED	
BY	

DSWR: RCH OPER: SVB SCALE: 1:100
 I:/1997/97362/As-Built/dgn's/Vol.5/Sh_1080-Maize-154430.dgn

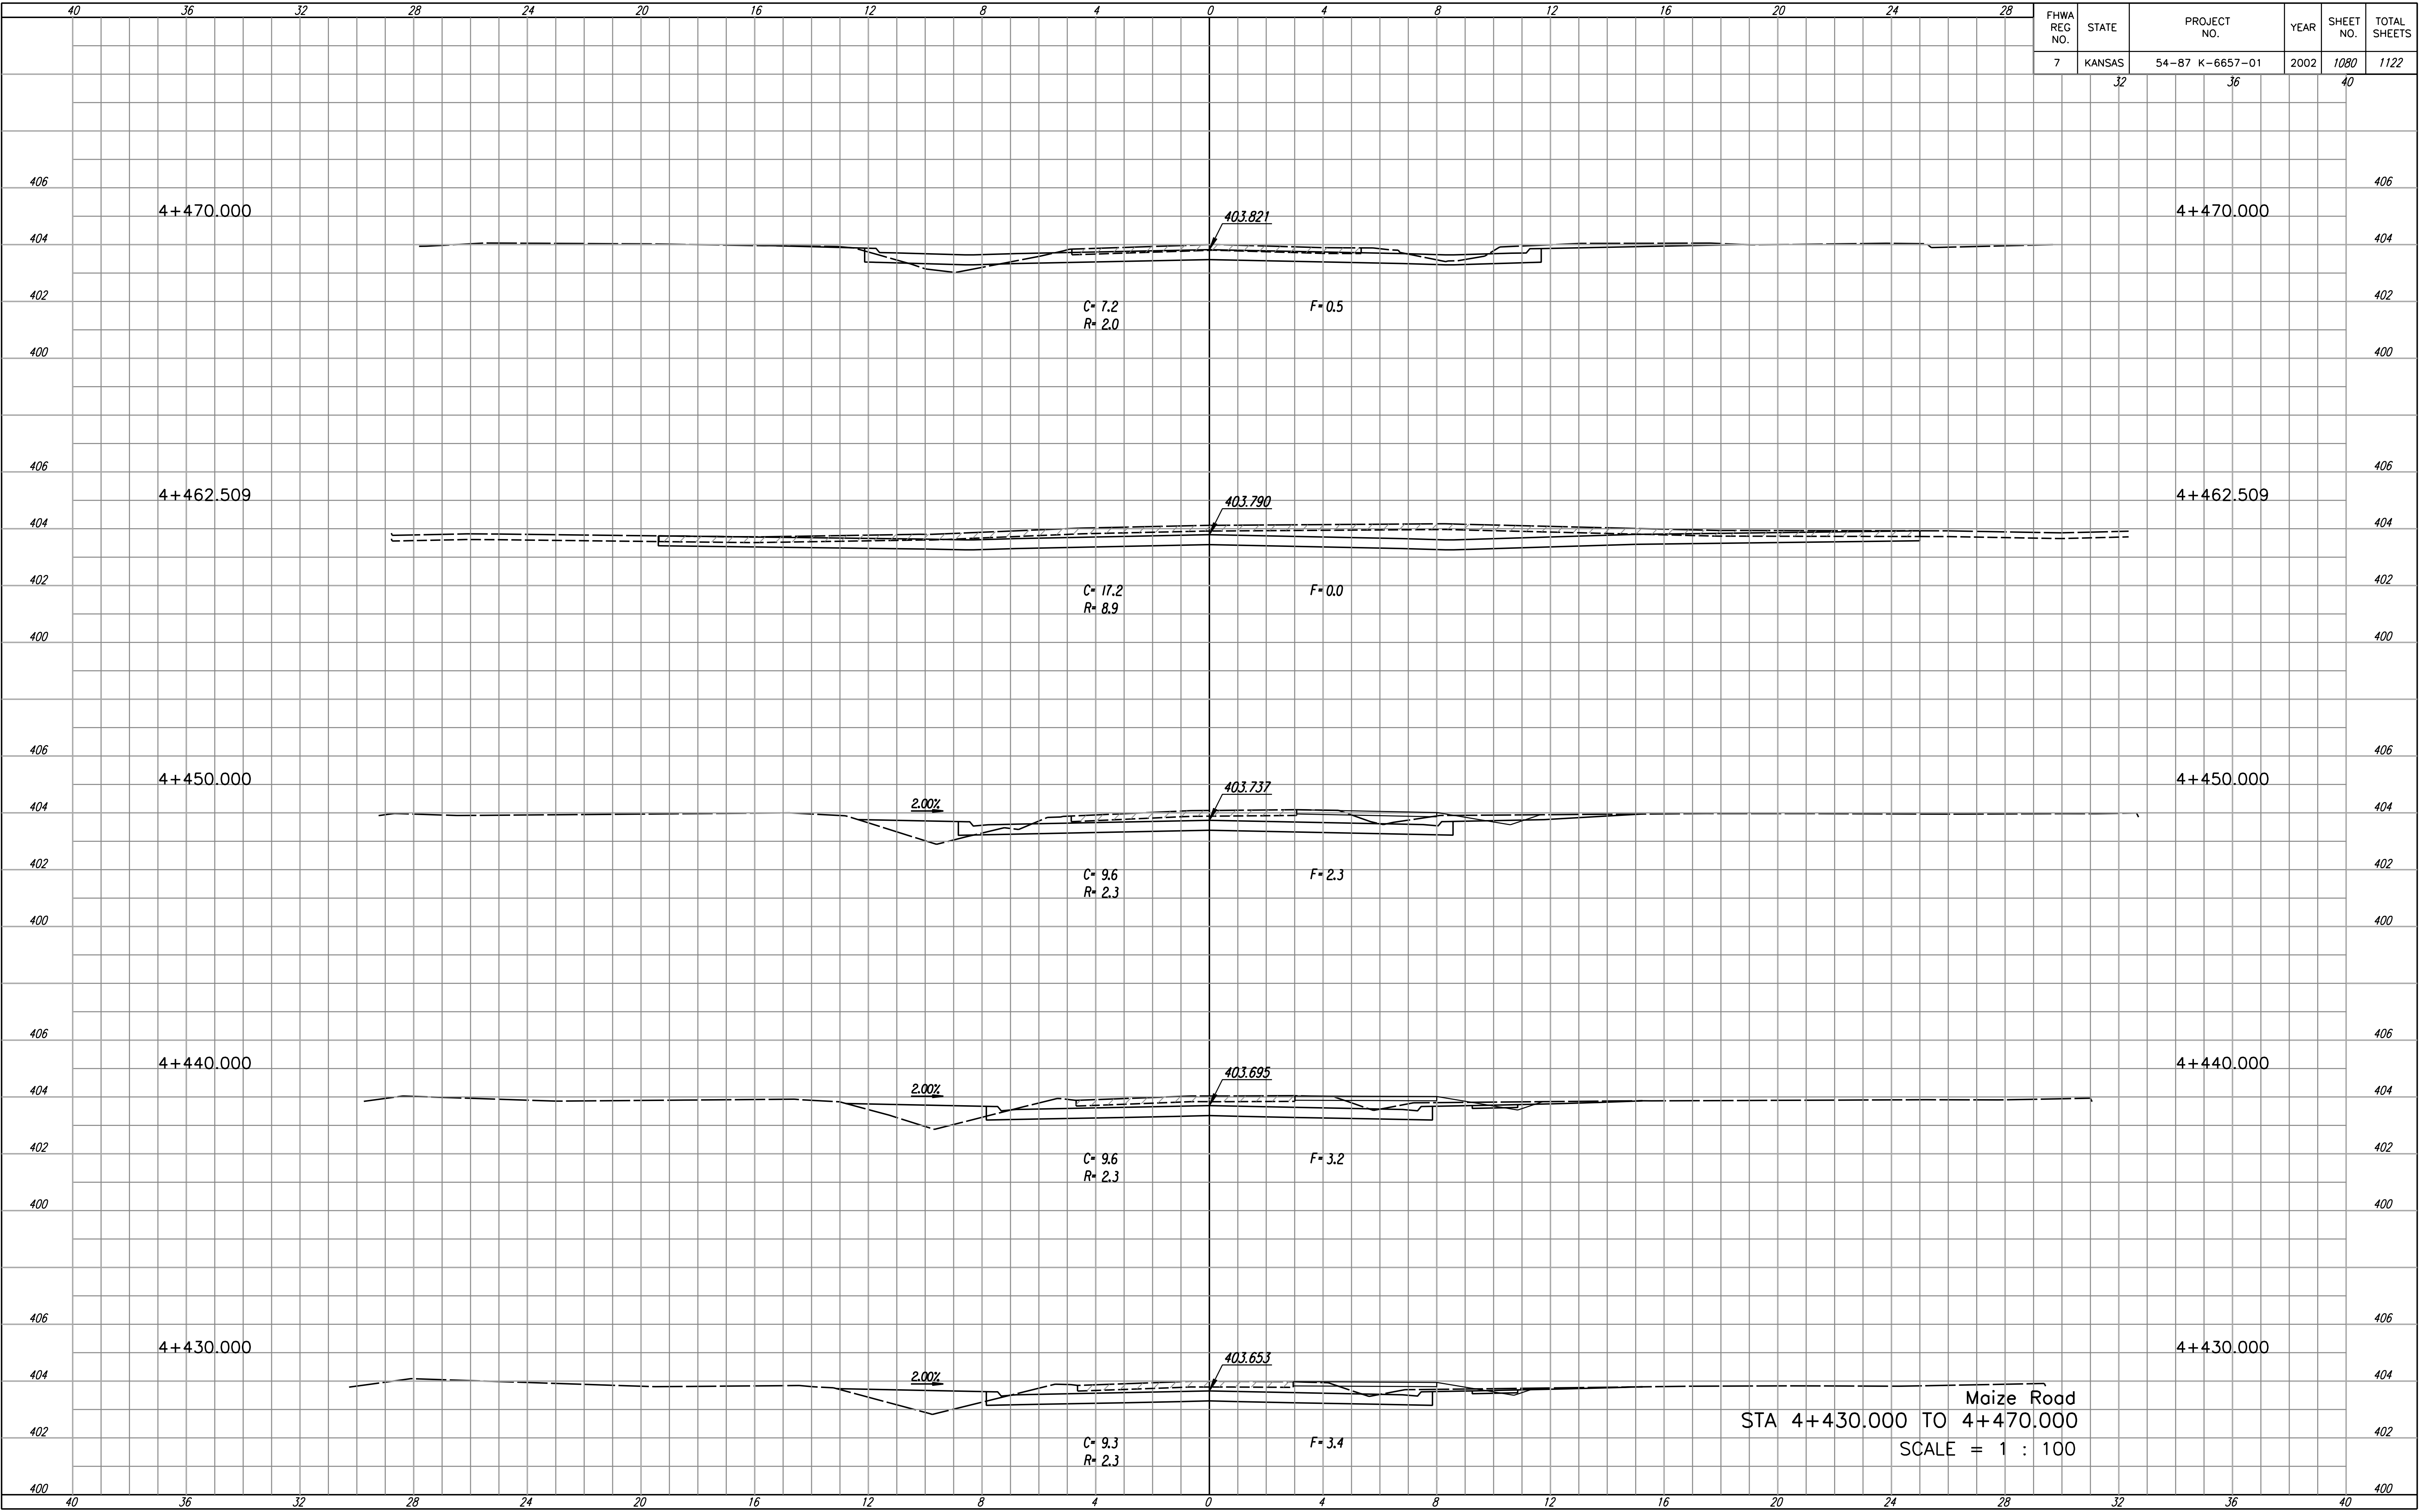

Maize Road
 STA 4+430.000 TO 4+470.000
 SCALE = 1 : 100