


FHWA REG NO.	STATE	PROJECT NO.	YEAR	SHEET NO.	TOTAL SHEETS
7	KANSAS	54-87 K-6657-01	2002	1082	1122
	32	36		40	

FINAL SURVEY NO.	DATE
SURVEYED BY	
PLOTTED BY	
TEMPLATE AREAS CHECKED	
NO.	

DSWR: RCH OPER: SVB SCALE: 1:100
 I:/1997/97362/As-Built/egn's/vol.5/5h_1082-Tyler-X54811.dgn

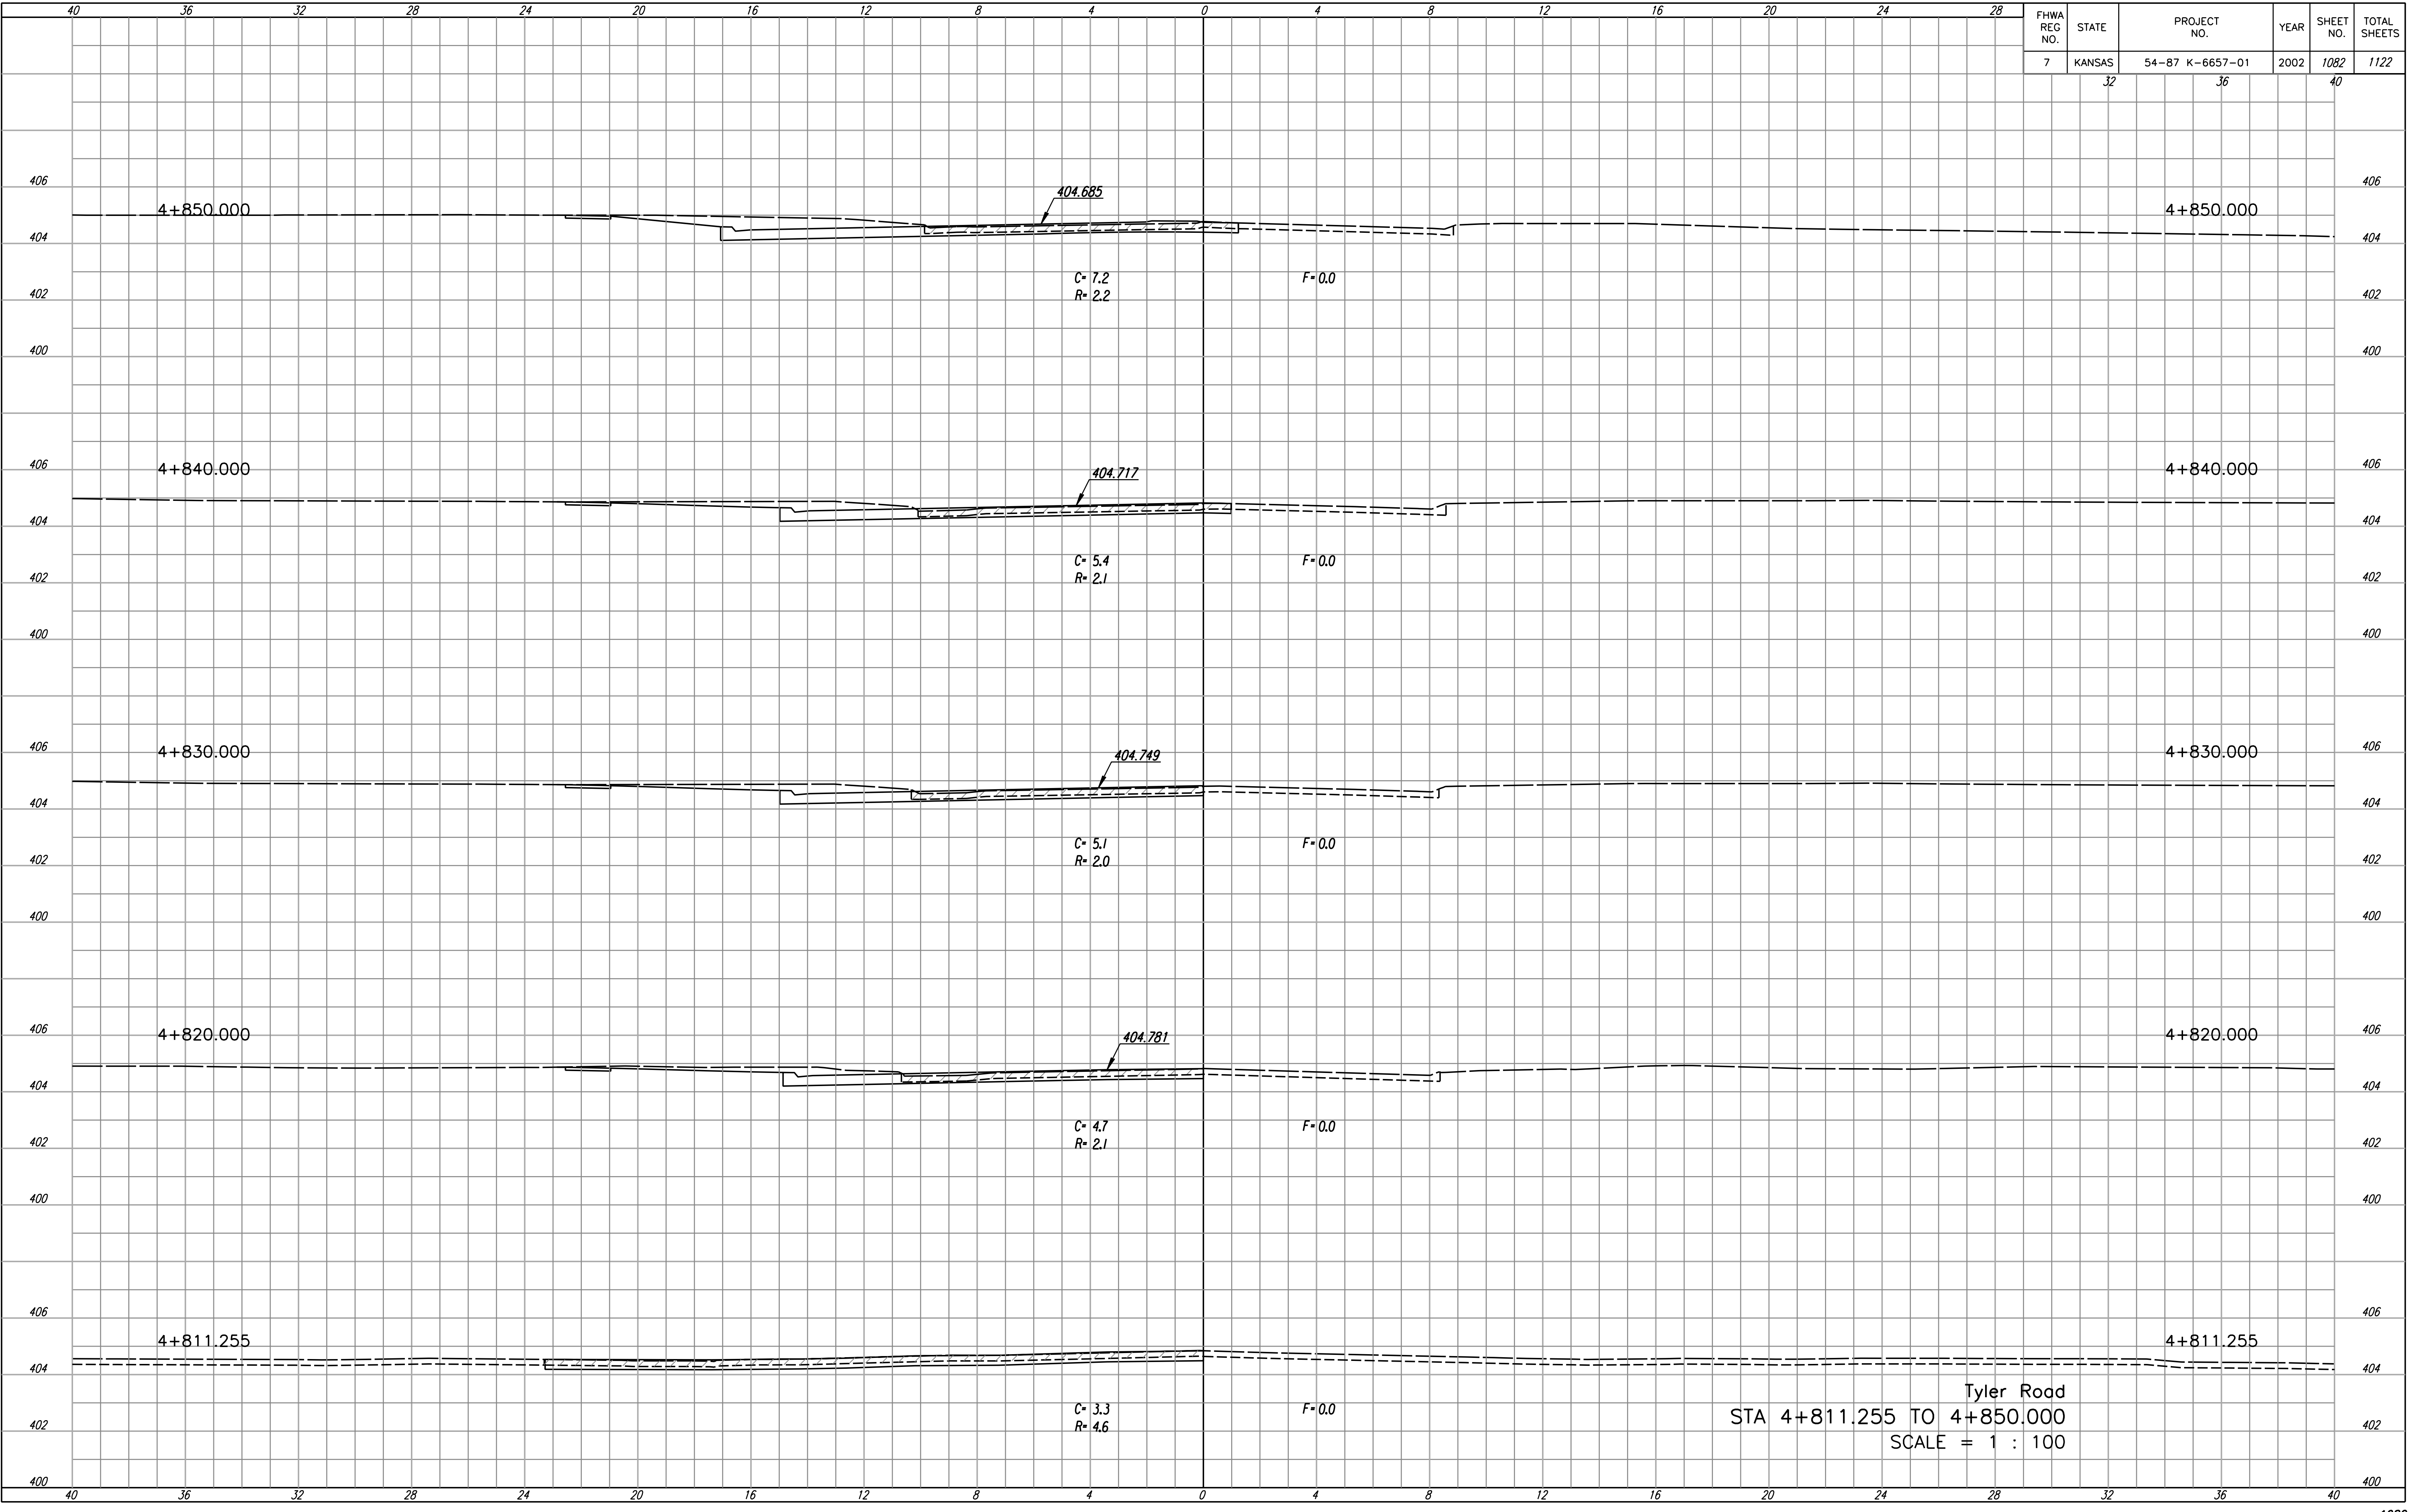

Tyler Road
 STA 4+811.255 TO 4+850.000
 SCALE = 1 : 100