


FHWA REG NO.	STATE	PROJECT NO.	YEAR	SHEET NO.	TOTAL SHEETS
7	KANSAS	54-87 K-6657-01	2002	1093	1122
	32	36		40	

FINAL SURVEY NO.	DATE
SURVEYED BY	DATE
PLOTTED BY	DATE
AREAS CHECKED	DATE

DSNR: RCH OPER: SVB SCALE: 1:100
 I:/1997/07262/As-Built/sgn's/vol.5/Sch_1093-Tyler-XS5184.dgn

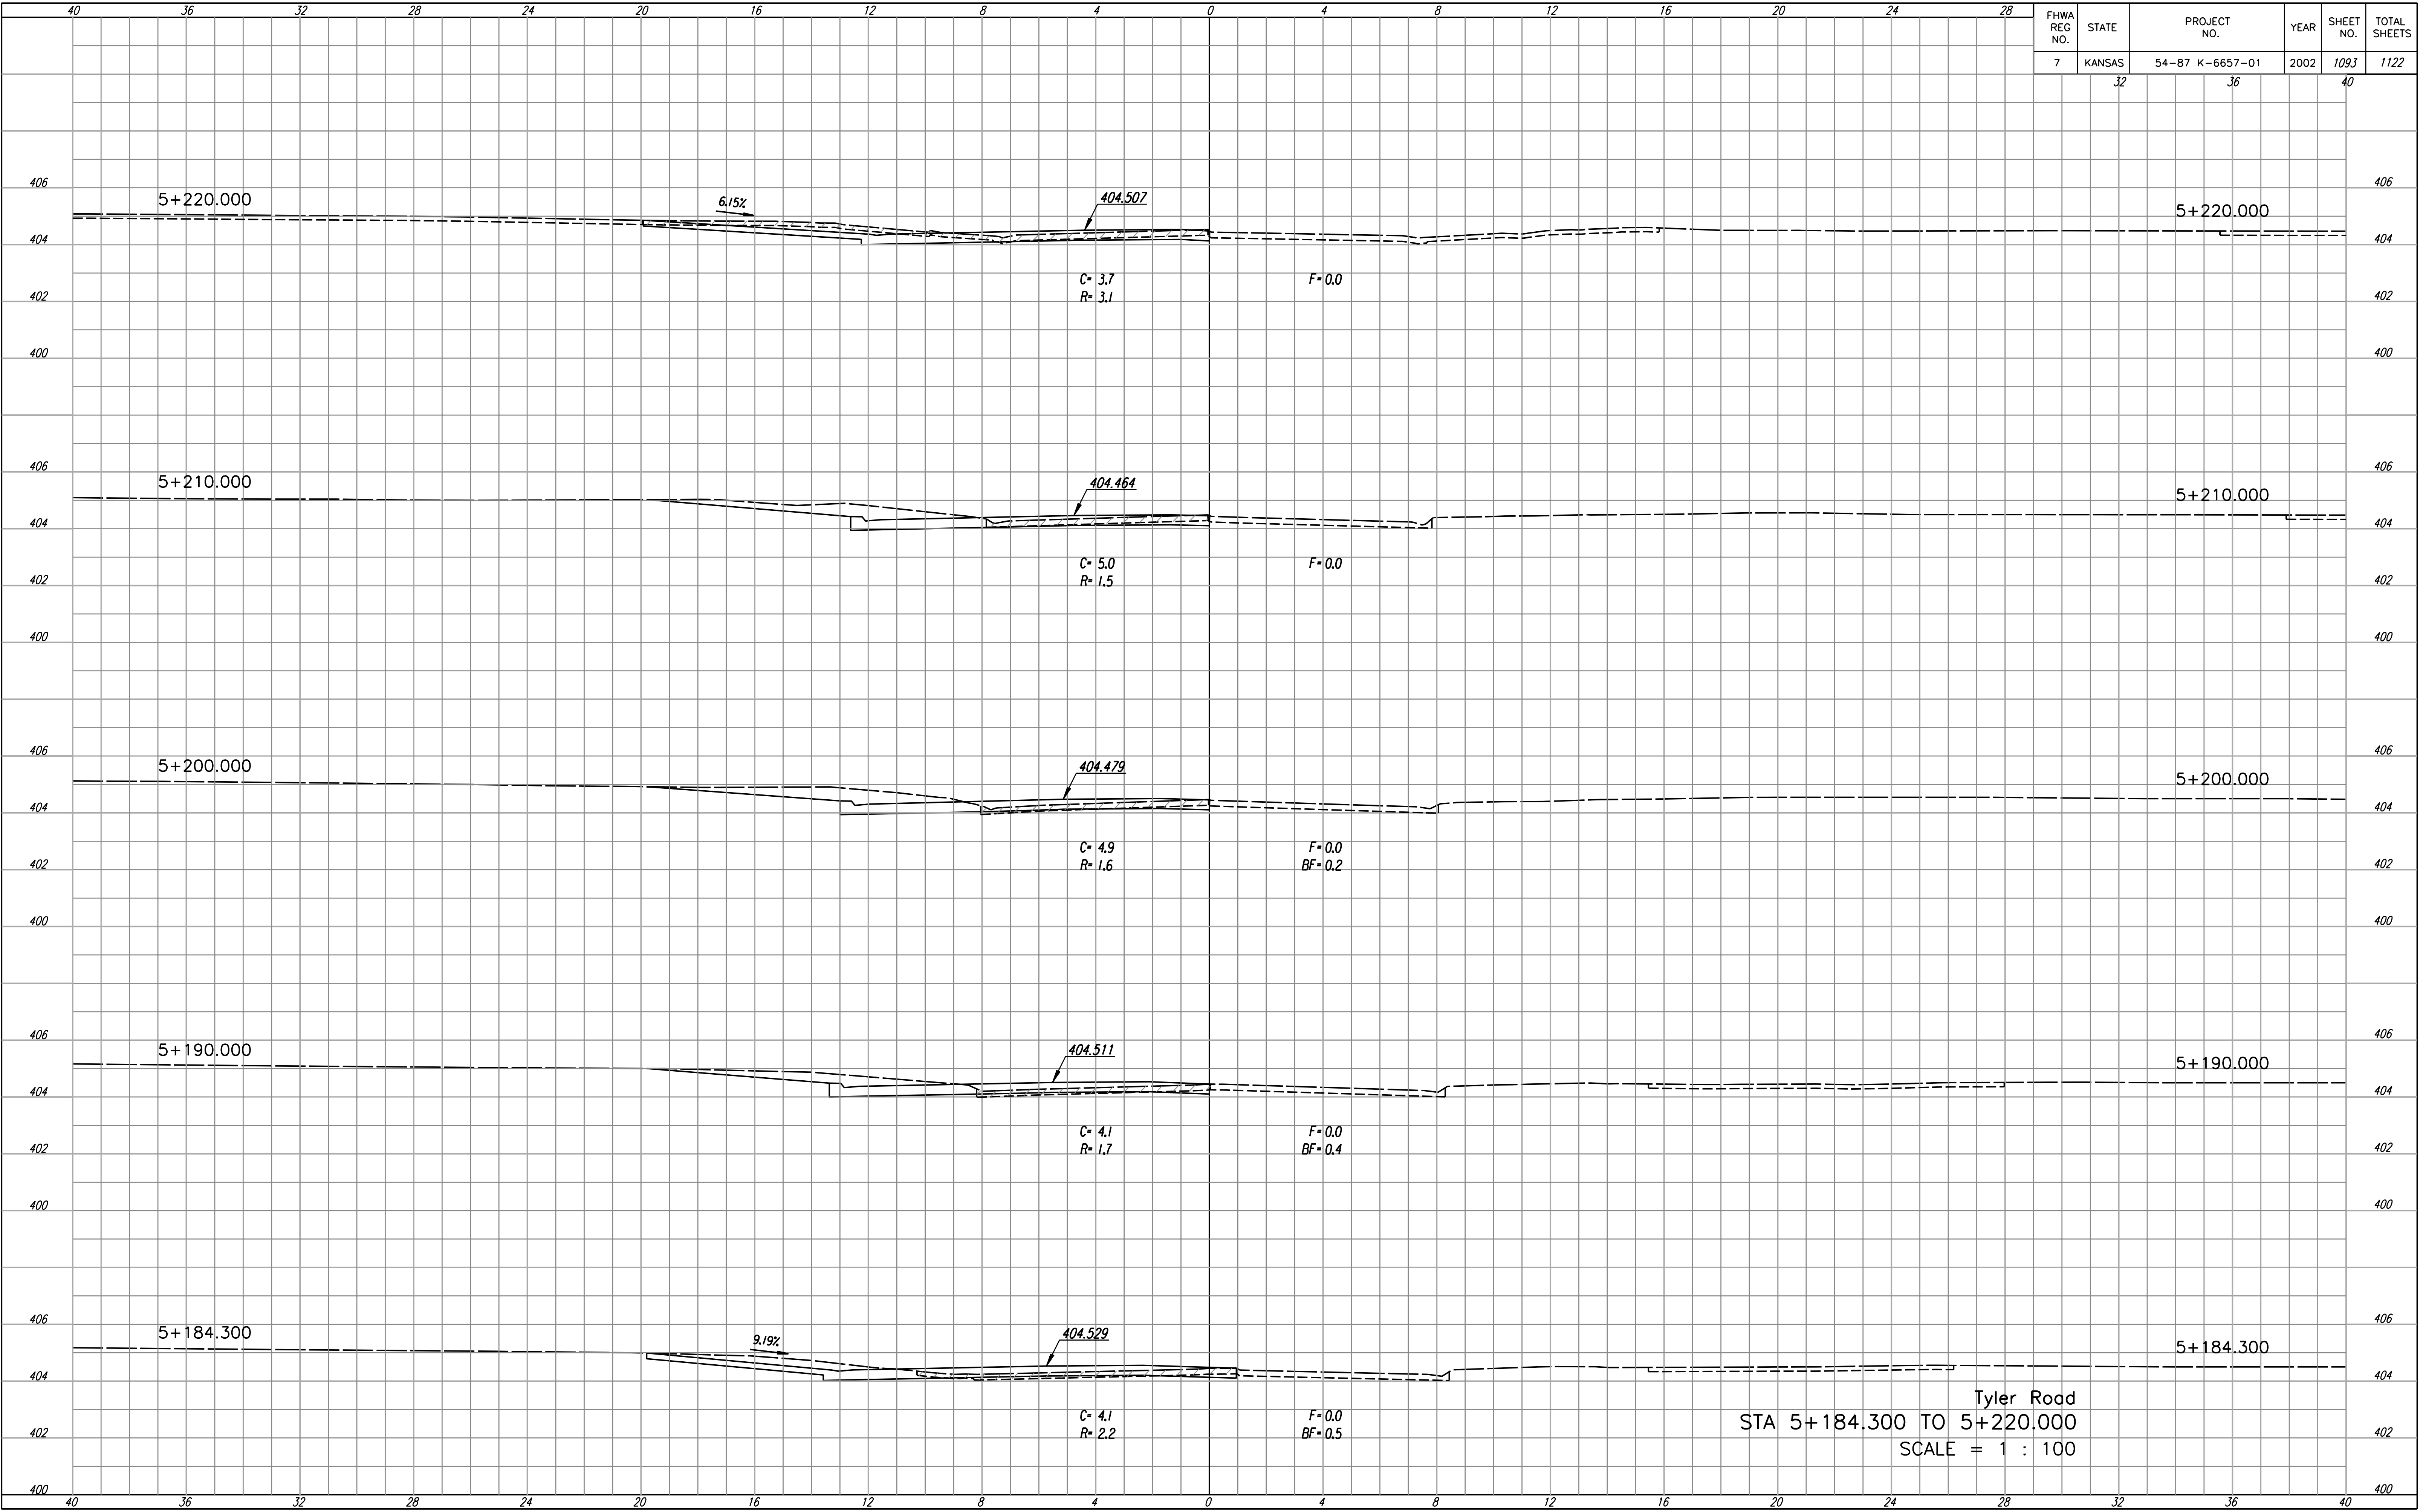

Tyler Road
 STA 5+184.300 TO 5+220.000
 SCALE = 1 : 100