


FHWA REG NO.	STATE	PROJECT NO.	YEAR	SHEET NO.	TOTAL SHEETS
7	KANSAS	54-87 K-6657-01	2002	1097	1122
	32	36		40	

FINAL SURVEY NO.	DATE
SURVEYED BY	
PLOTTED BY	
TEMPLATE AREAS CHECKED	

DSNR: RCH OPER: SVB SCALE: 1:100
 I:/1997/07362/As-Built/sgn's/6615/5h_1097-Tyler-X55353.dgn

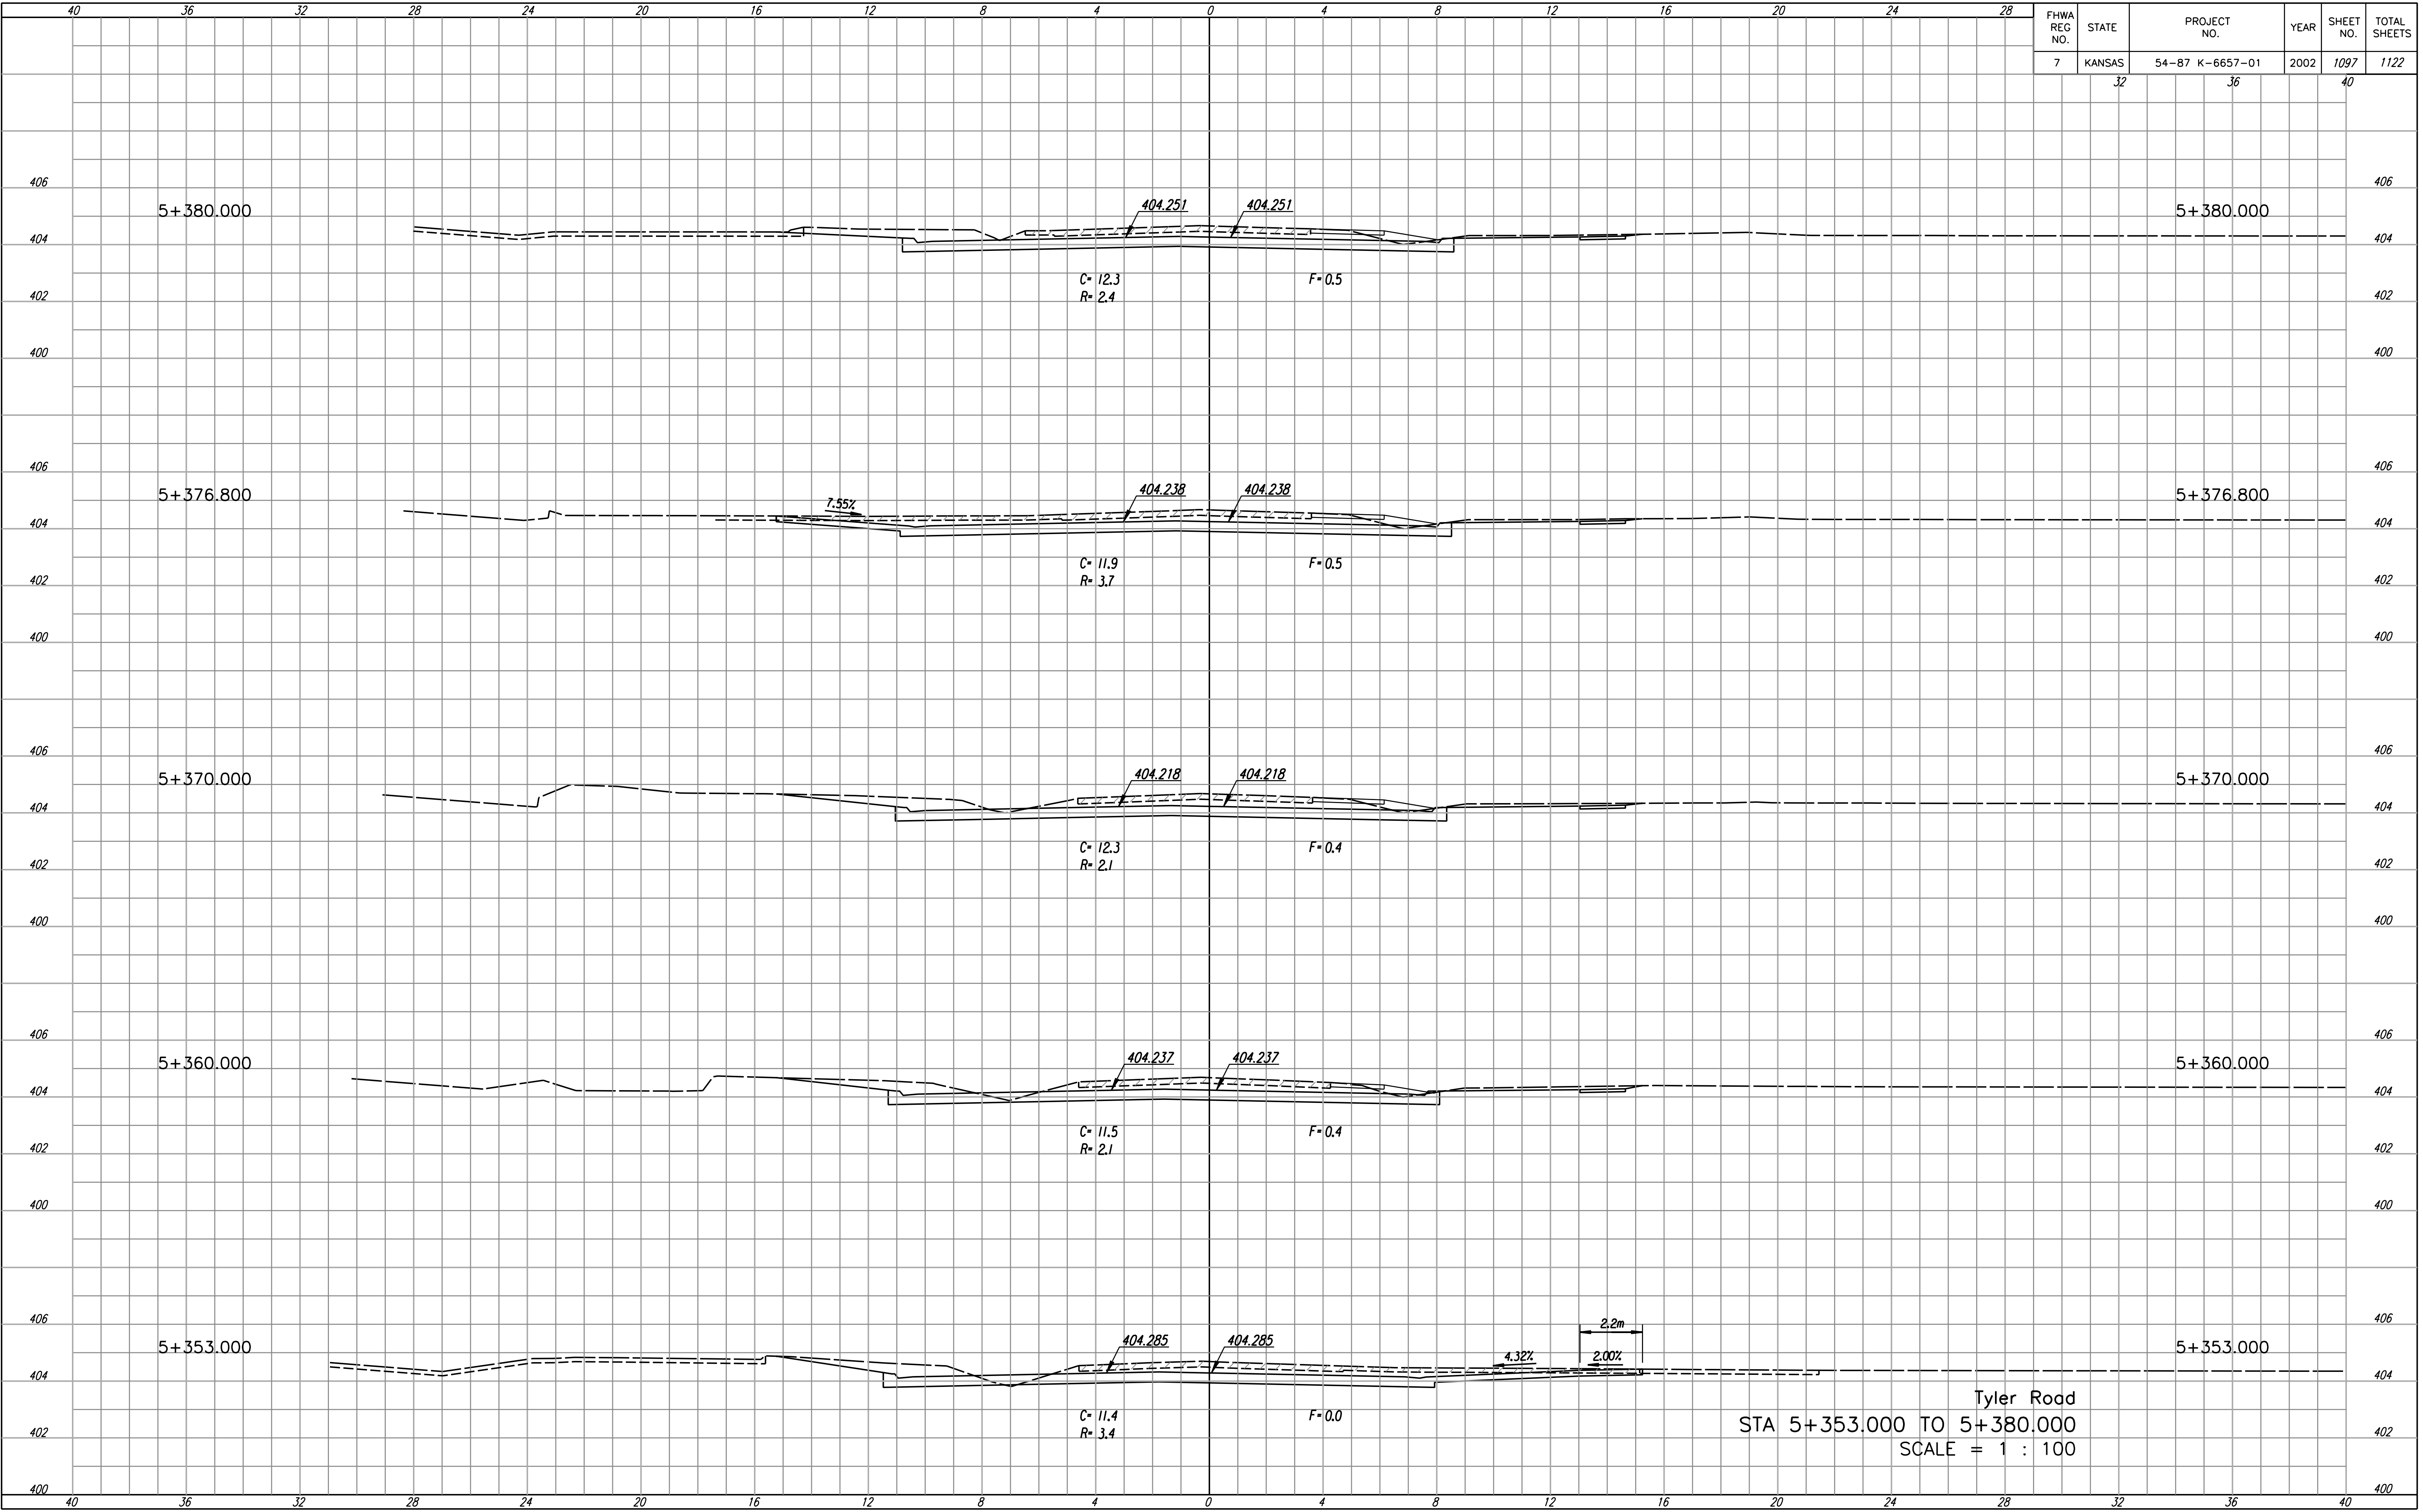

Tyler Road
 STA 5+353.000 TO 5+380.000
 SCALE = 1 : 100