


FHWA REG NO.	STATE	PROJECT NO.	YEAR	SHEET NO.	TOTAL SHEETS
7	KANSAS	54-87 K-6657-01	2002	1099	1122
		32		40	

FINAL SURVEY NO.	DATE
SURVEYED BY	
PLOTTED BY	
TEMPLATE AREAS CHECKED	
NO. OF AREAS CHECKED	

DSNR: RCH OPER. SVB SCALE: 1:100
 I:\1997\97362\As-Built\egm's\Vol.5\Stn_1099-Tyler-XS5430.dgn

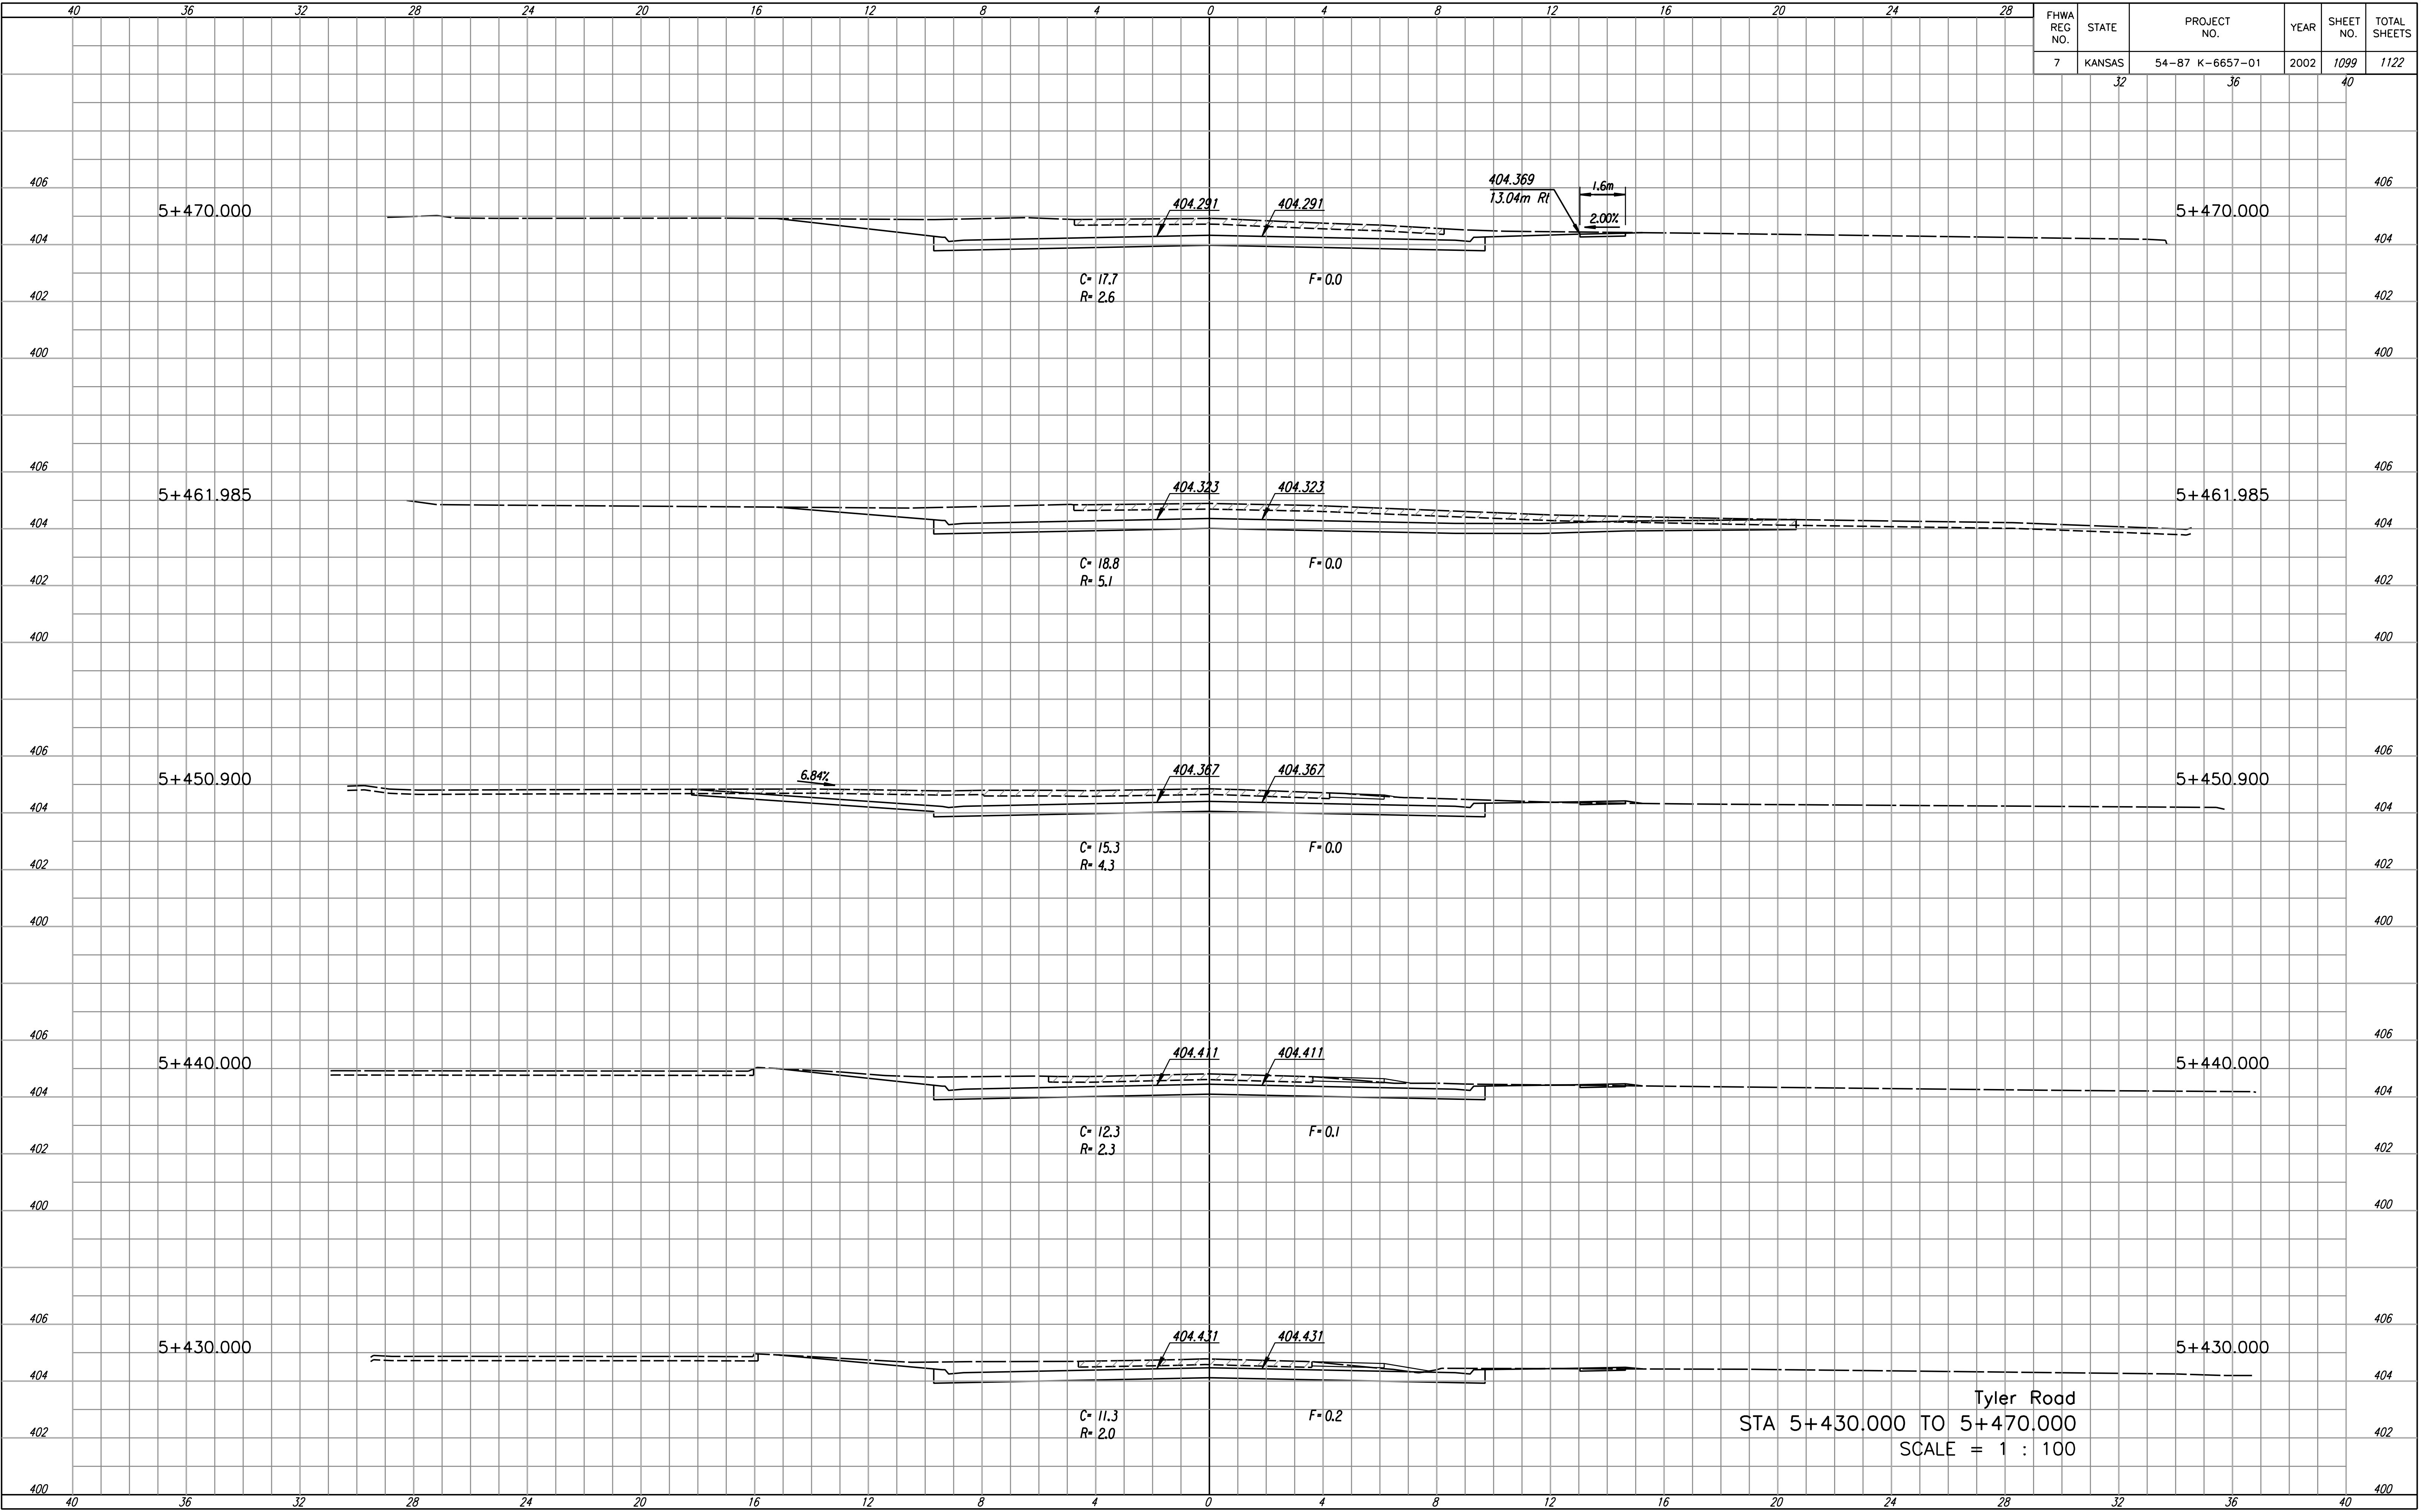

Tyler Road
 STA 5+430.000 TO 5+470.000
 SCALE = 1 : 100