


FHWA REG NO.	STATE	PROJECT NO.	YEAR	SHEET NO.	TOTAL SHEETS
7	KANSAS	54-87 K-6657-01	2002	1100	1122
32		36		40	

FINAL SURVEY NOTE BOOK NO.	DATE
SURVEYED PLOTTED TEMPLATE AREAS	
AREAS CHECKED	

DSWR: RCH OPER: SVB SCALE: 1:100
 I:\1997\97362\As-Built\sgn\5\61.5\StL_1100-Tyler-XS5480.dgn

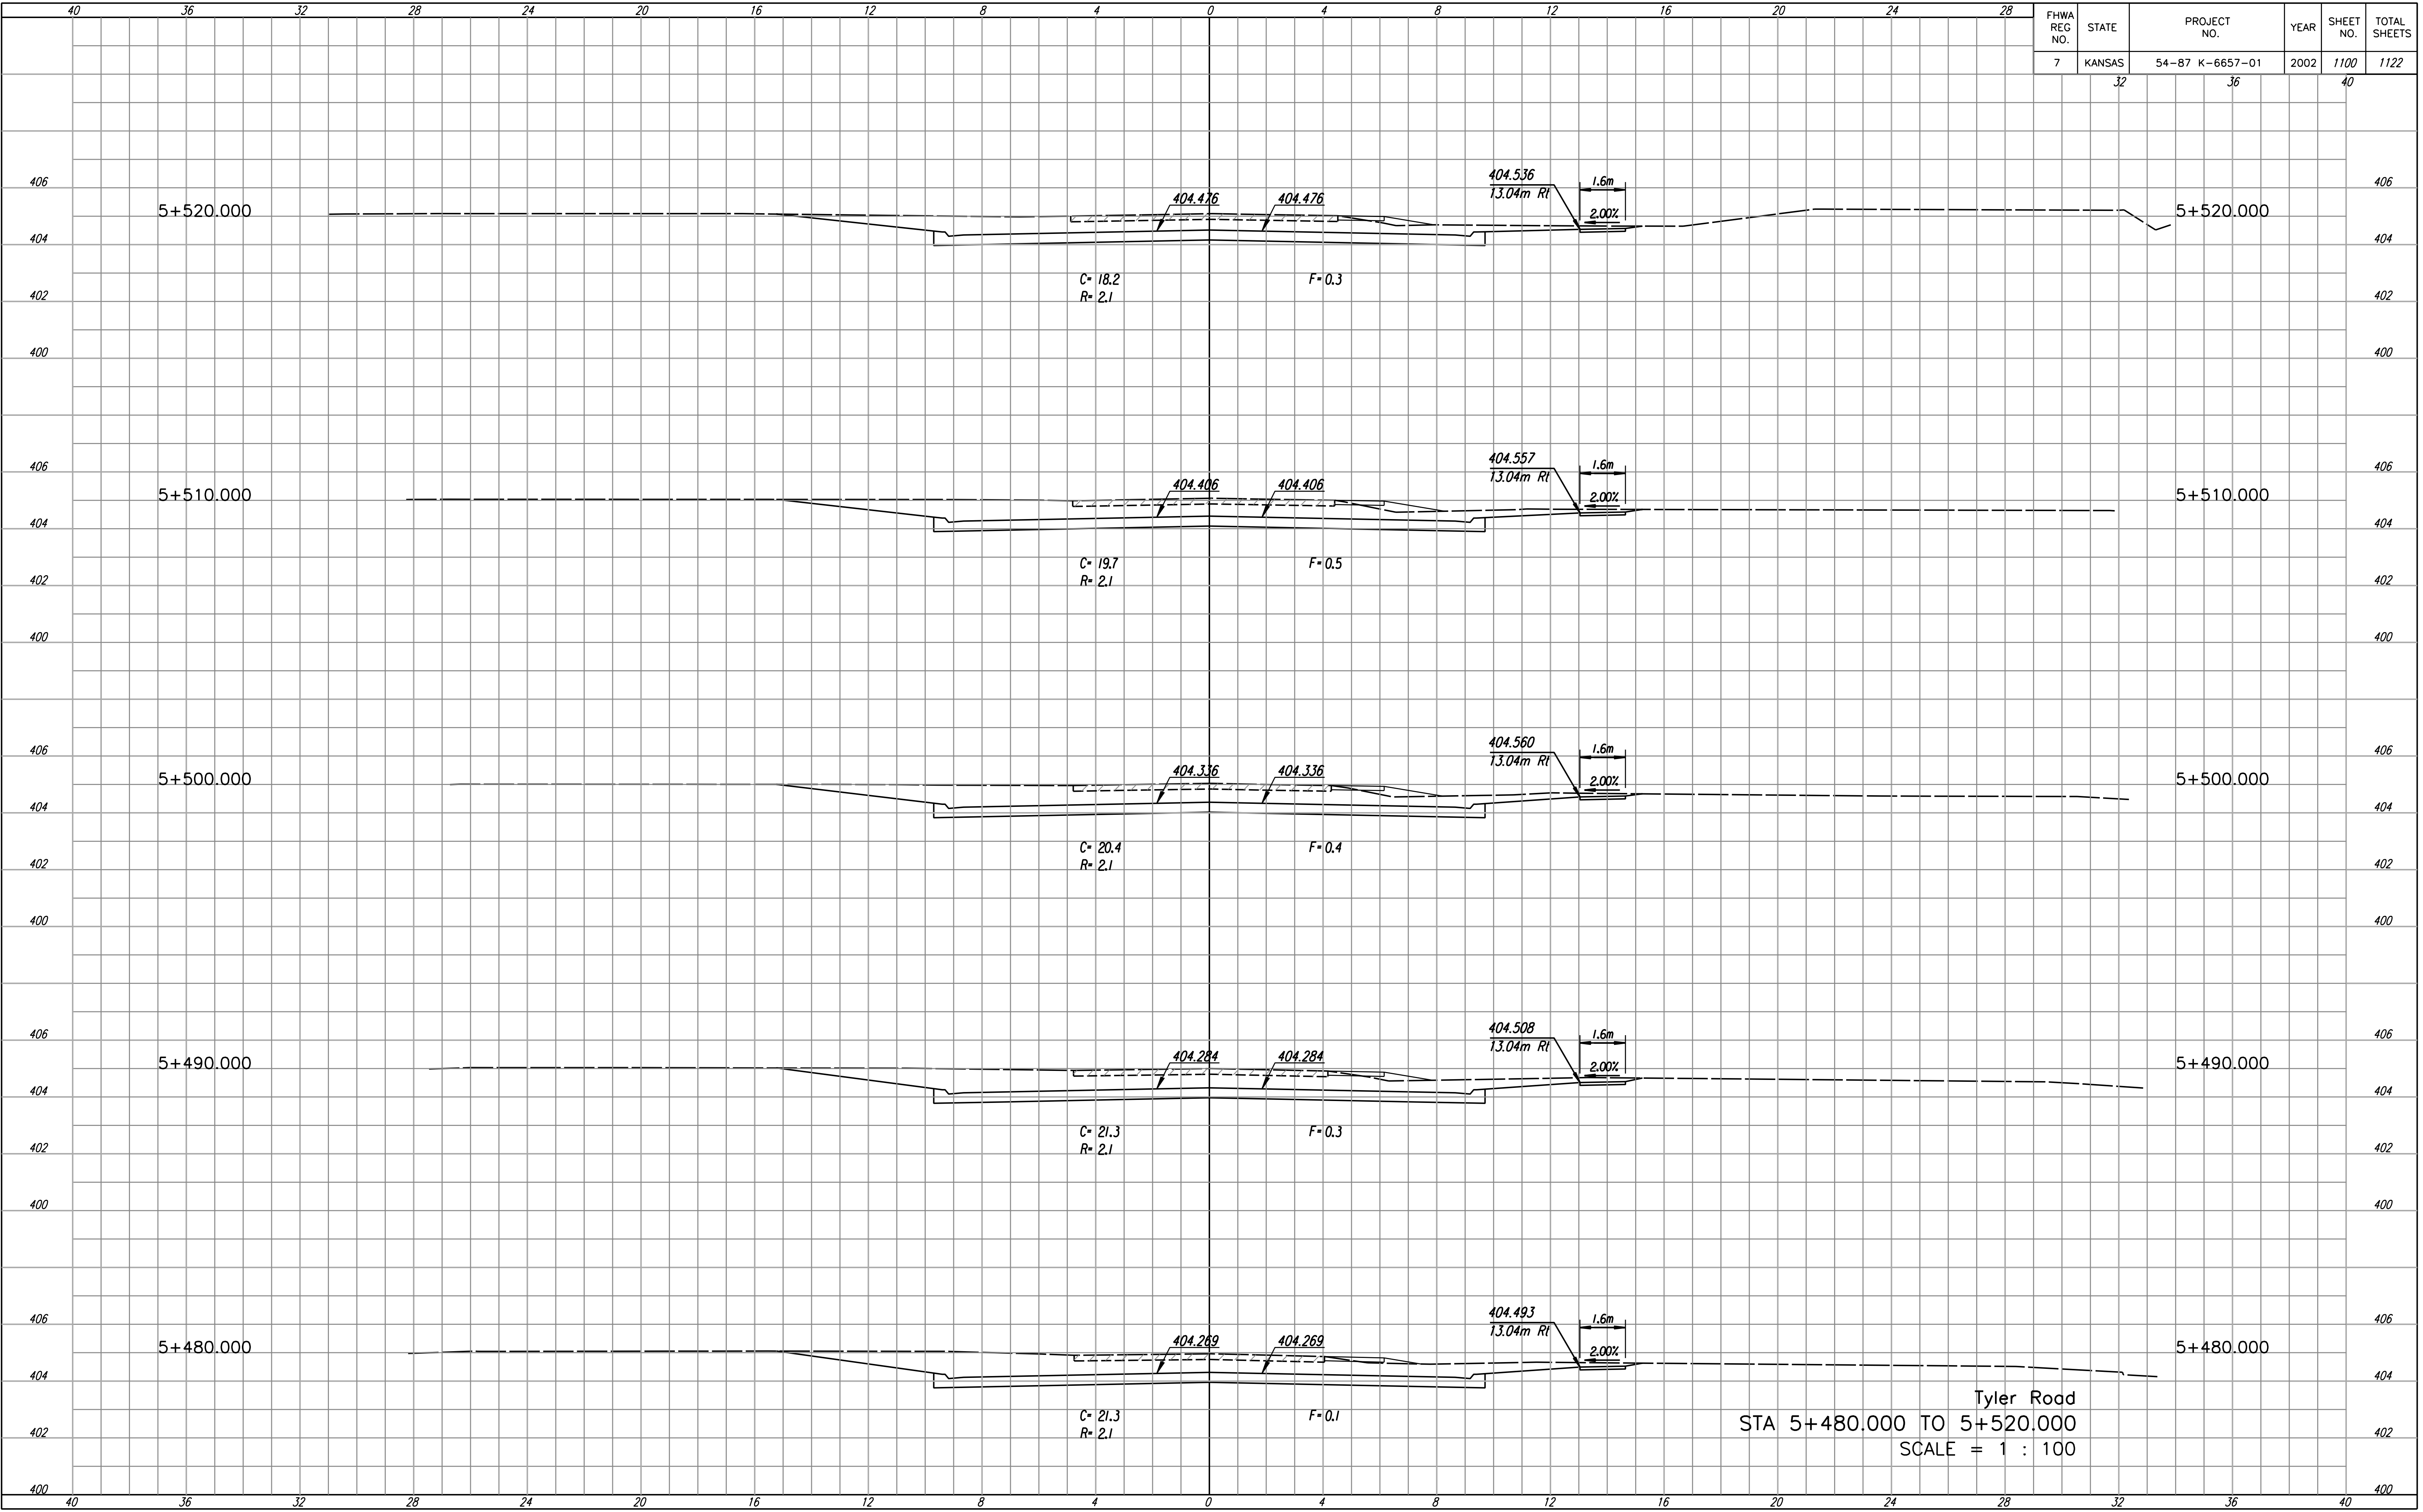

Tyler Road
 STA 5+480.000 TO 5+520.000
 SCALE = 1 : 100