


FHWA REG NO.	STATE	PROJECT NO.	YEAR	SHEET NO.	TOTAL SHEETS
7	KANSAS	54-87 K-6657-01	2002	1101	1122
32		36		40	

FINAL SURVEY NO.	DATE
SURVEYED	
PLOTTED	
TEMPLATE AREAS CHECKED	

DSNR: RCH OPER: SVB SCALE: 1:100
 I:/199/07362/As-Built/sgn's/Vol.5/5h_1101-Tyler-XS5530.dgn

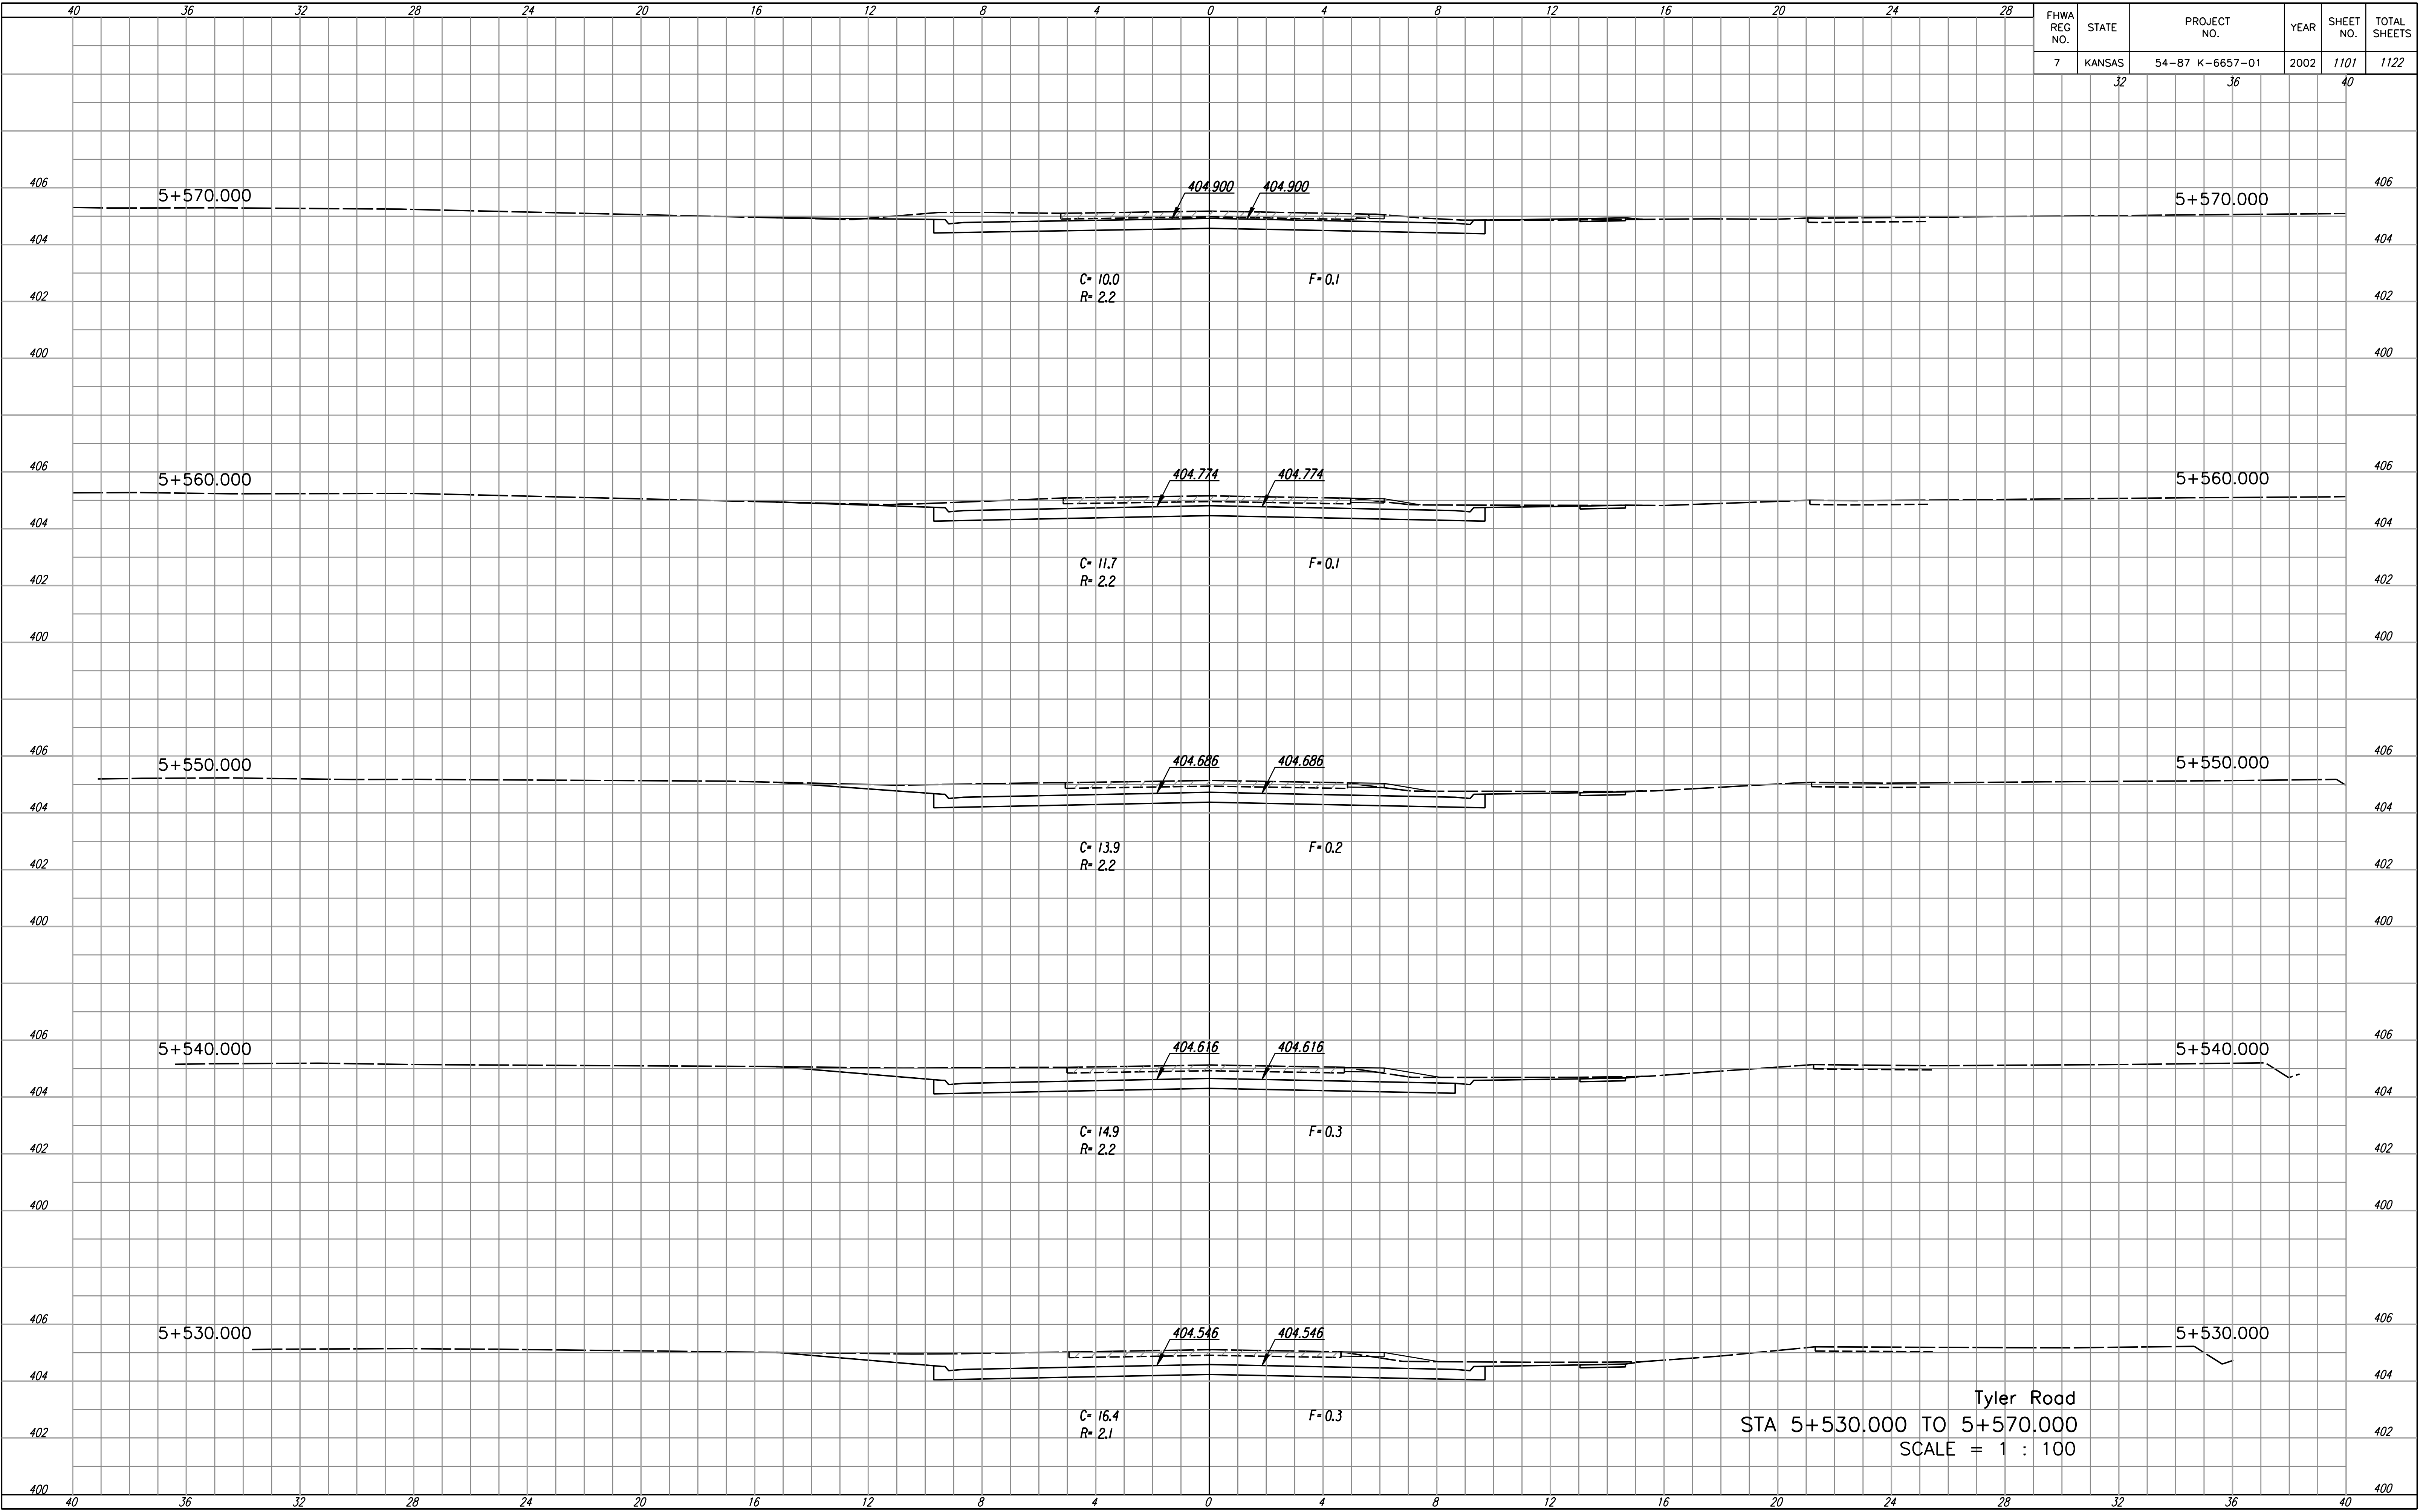

Tyler Road
 STA 5+530.000 TO 5+570.000
 SCALE = 1 : 100